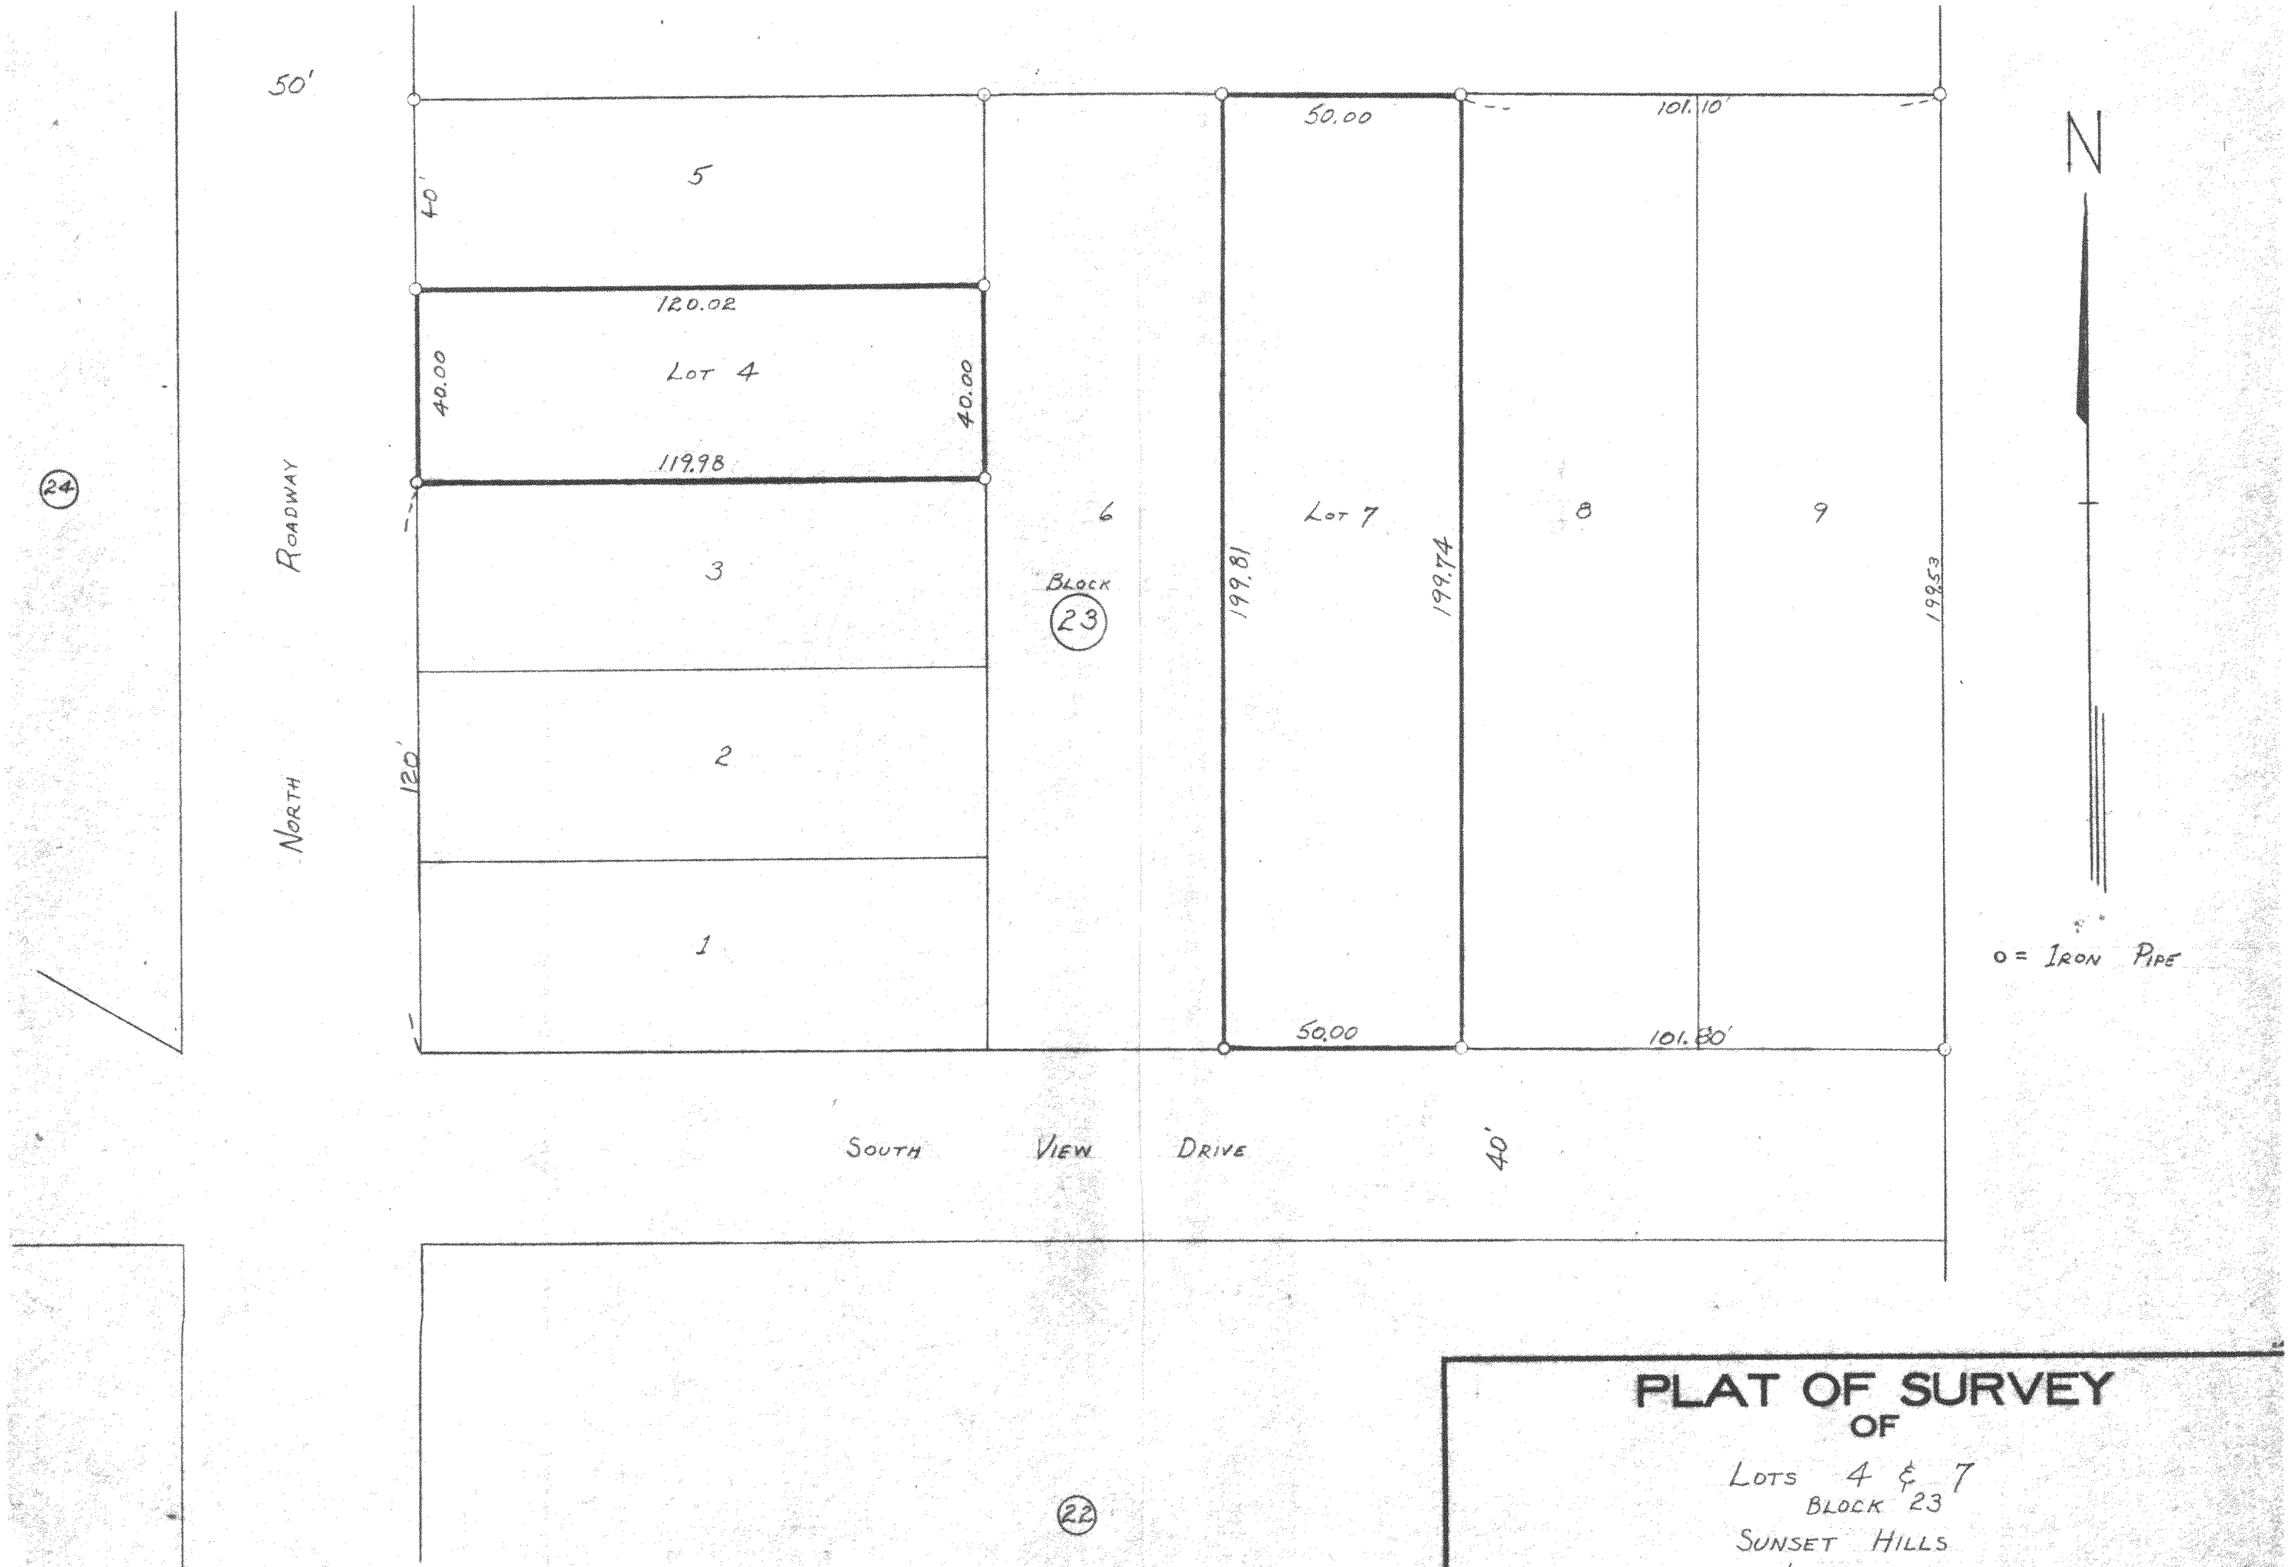

PLAT OF SURVEY
OF

Lots 4 & 7
Block 23
Sunset Hills
Located in
Sect 33, T2NR17E Walworth Co., Wisconsin

Lloyd L. Jensen
Surveyor

SCALE 1" = 30'

DATE July 1953

217-63.1