ABERNATHY and ASSOCIATES
Kenneth B. Abernathy Jr.
Wisconsin Registered Land Surveyor S-1594

Rt. 3, Box 273
Elkhorn, Wisconsin 53121
Phone: (414) 723-4260 (office)
(414) 723-4813 (residence)

PLAT OF SURVEY

LOTS 1 AND 2 OF BLOCK 2 OF HAWTHORNE HILLS, A SUBDIVISION LOCATED IN SECTION 26, TOWN 2 NORTH, RANGE 17 EAST, WALWORTH COUNTY, WISCONSIN.

OWNER: GEORGE JACOBSON
RT. 4 BOX 296
LAKE GENEVA, WI. 53147

SUBDIVISION RECORDED IN VOL. 13 AS PAGE 47 OF WALWORTH COUNTY PLATS
CABINET A SLIDE 120

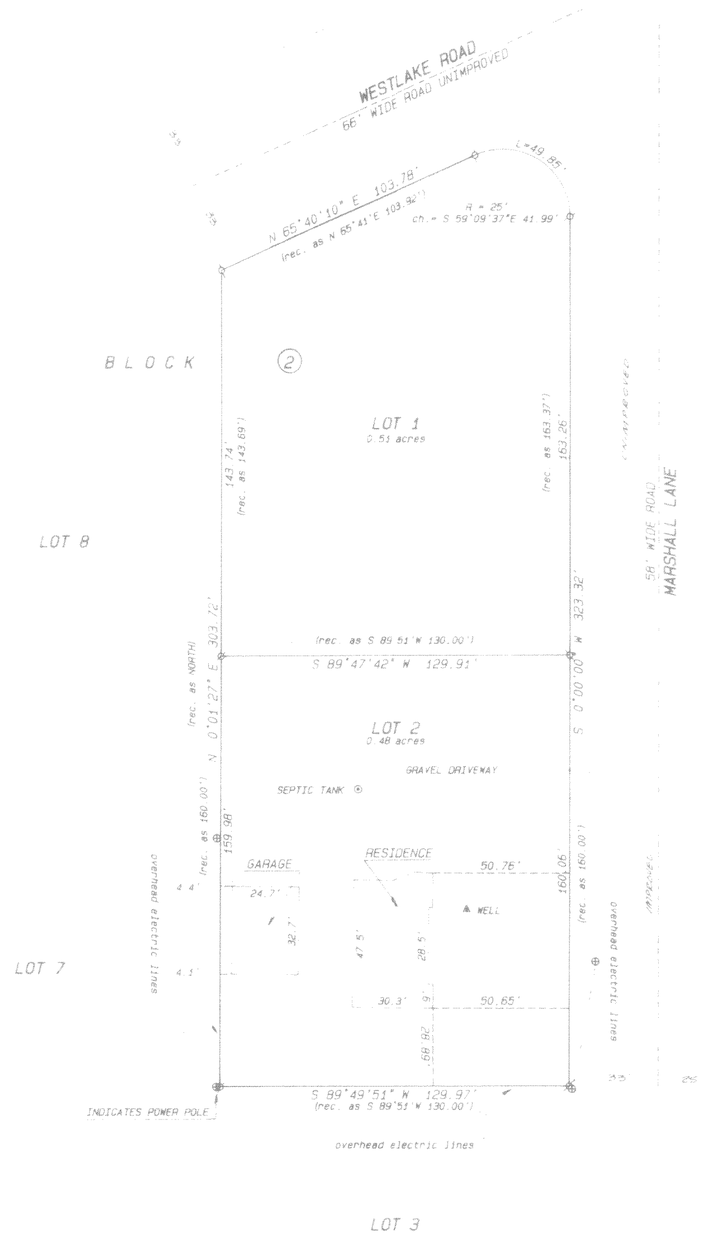

scale 1"= 40 feet

bearings are based on the east line of block 2 assumed to bear NORTH

Legend

- FOUND IRON PIPE
- FOUND IRON ROD
- FOUND BRASS CAPPED MONUMENT
- FOUND CONCRETE MONUMENT
- CHISEL CUT IN CONCRETE
- SET IRON ROD 24" LONG WEIGHING 1.5 LBS. LINEAL FT. 1/4" DIA.
- SET IRON ROD 18" LONG WEIGHING 4.5 LBS. LINEAL FT. 1/2" DIA.
- (xxx) RECORDED AS DIMENSION
- EXISTING FENCE

RECEIVED
APR 9 1994

SCALE: 1" 40 FEET

I hereby certify that I have surveyed the above described property and that the above map is a true representation thereof and shows the size and location of the property, its exterior boundaries, the location of all visible structures and dimensions of all principal buildings thereon, boundary fences, apparent easements, roadways and visible encroachments, if any.

This survey is made for the use of the present owners of the property, and also those who purchase, mortgage or guarantee the title thereto within one year from date hereof.

KENNETH B. ABERNATHY, JR.
WISCONSIN REGISTERED LAND SURVEYOR
S-1594

Date: 11/26/90 Job No. 90-102

217-939

JHH 00009