PLAT OF SURVEY

- OF -

LOT 1 OF MAPLE TREE FARMS A SUBDIVISION OF PART OF THE NORTHWEST 1/4 , SOUTHWEST 1/4 AND SOUTHEAST 1/4 OF THE SOUTHEAST 1/4 OF SECTION 33, TOWNSHIP 2 NORTH, RANGE 17 EAST, TOWN OF GENEVA, COUNTY OF WALWORTH AND STATE OF WISCONSIN.

PREPARED FOR
ELAINE JOHNSON
KEEFE REAL ESTATE
LAKE GENEVA WI

PATHFINDER SURVEYING INC.
(formerly)
J.K. SURVEYING INC.
P.O BOX 322
LAKE GENEVA, WI. 53147
WWW.PATHFINDERSURVEYING.NET
262-248-8303

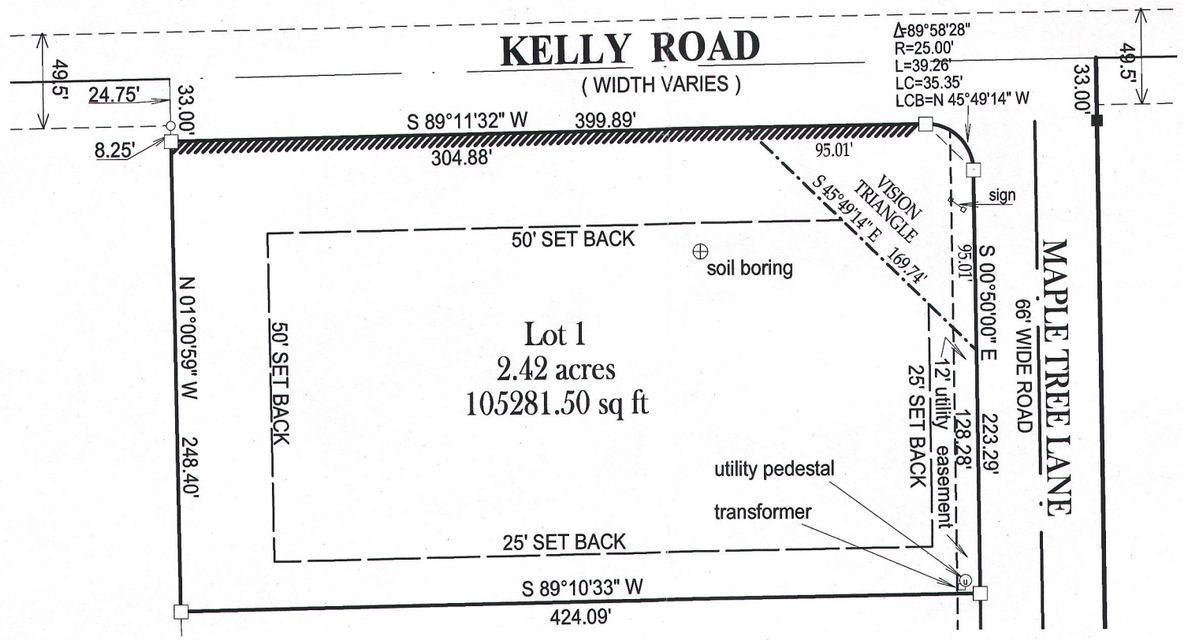

= no direct access
( )= recorded as
□ = found iron bar
○ = found iron pipe
● = set iron pipe
■ = set iron bar

SCALE 1" = 80'

JOB # 15-66

TAX ID # JMAP00001

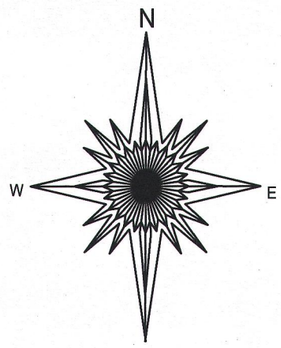

80 0 80

80 0 80 160 240

BASIS OF BEARING OF THIS PLAT: THE WISCONSIN STAE PLANE COORDINATE SYSTEM, SOUTH ZONE GRID NORTH, NAD 83 (2011).

"I hereby certify that I have surveyed the above described property and that the above map is a true representation thereof and shows the size and location of all visible structures, apparent easements and encroachments if any."
This survey is made for the present owners of the property, and those who purchase, mortgage, or guarentee the title thereto, within one year from the date hereof.

DATED THIS 23RD DAY OF MARCH, 2015.

RECEIVED
MAY 11 2015
By

WISCONSIN
JEFFREY L. KIMPS S-2436 LAKE GENEVA. WIS.
LAND SURVEYOR

JEFFREY L KIMPS S - 2436
Wisconsin Registered Land Surveyor
(original if signed in red)

JMAP -1 217-4066