


PLAT OF SURVEY

Units 26-11, 26-12, and 26-13 in Geneva National Condominium No. 26, being a condominium created under the Condominium Ownership Act of the State of Wisconsin by a Declaration of Condominium for Geneva National Condominium No. 26, dated the 1st day of July 2005 in the Office of the Register of Deeds for Walworth County, Wisconsin, as Document No. 646983, and Amendment recorded January 13 as Document No. 807302 and by a Condominium Plat thereof.

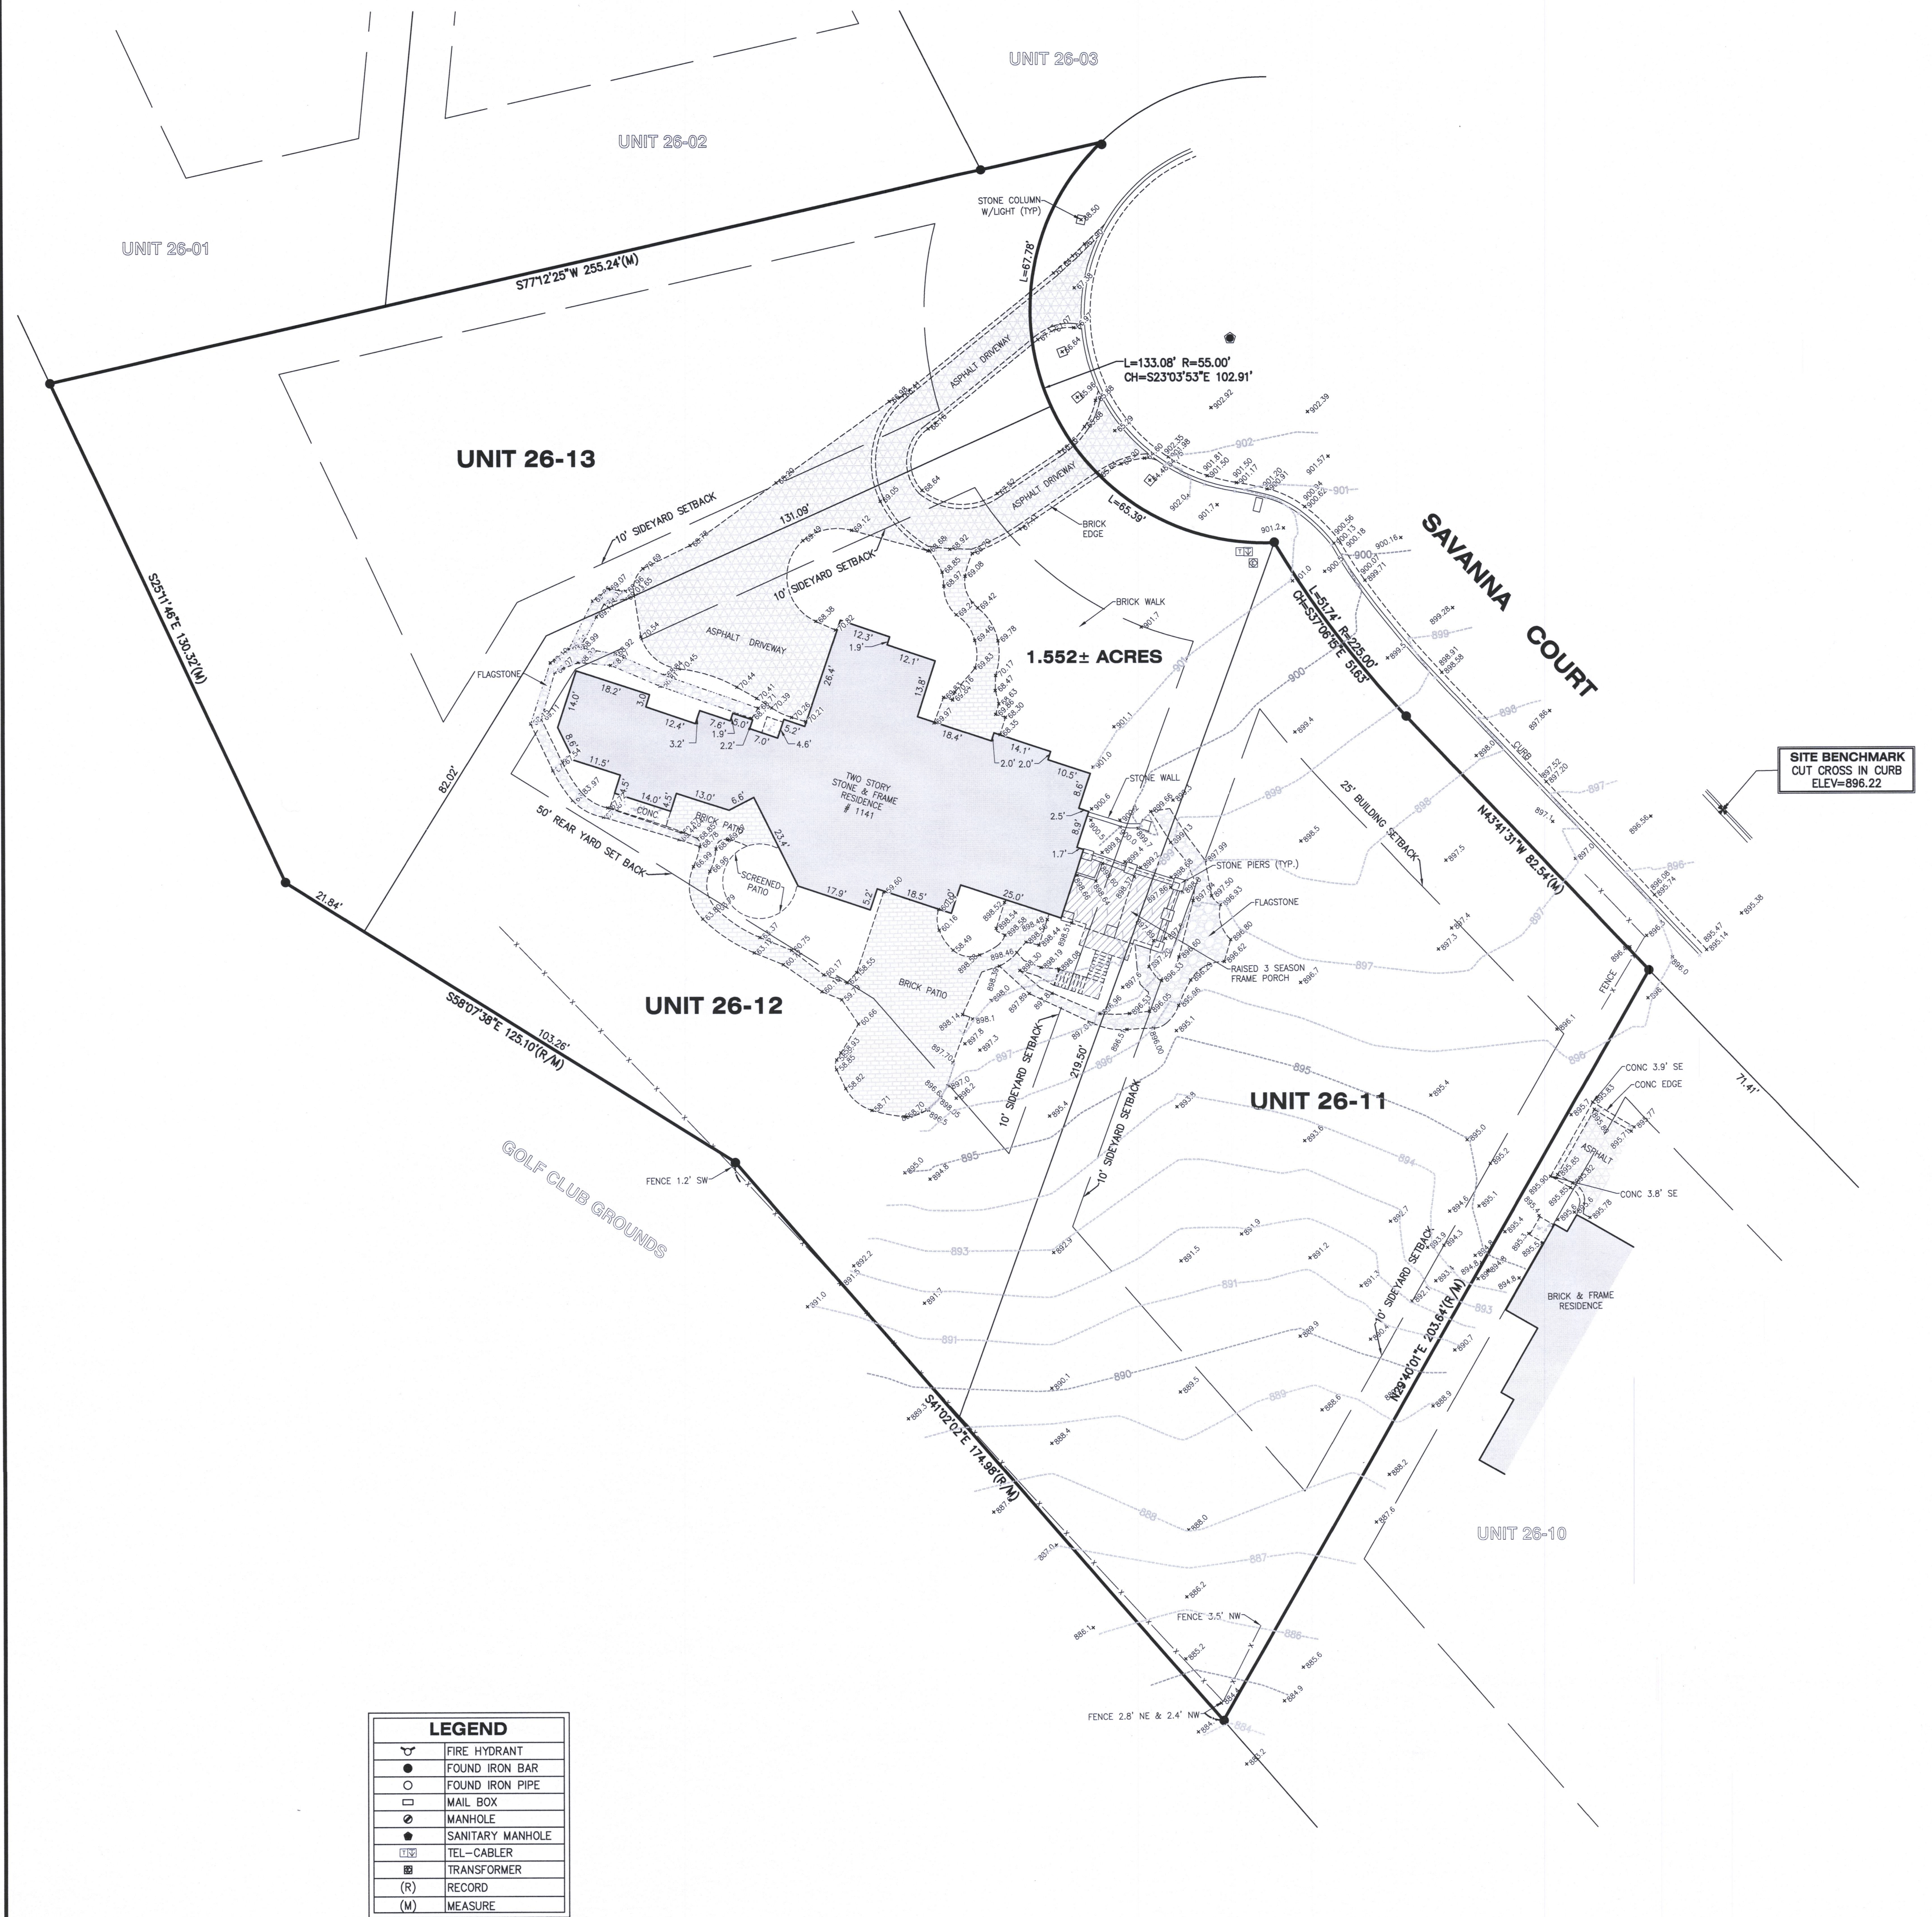

LEGEND	
	FIRE HYDRANT
	FOUND IRON BAR
	FOUND IRON PIPE
	MAIL BOX
	MANHOLE
	SANITARY MANHOLE
	TEL-CABLER
	TRANSFORMER
	RECORD
	MEASURE

20' 0' 20' 40'
SCALE: 1" = 20'

PROJECT BENCHMARK
PUBLIC LAND SURVEY CONTROL
STATION SECTION CORNER
MONUMENT AT SW 1/4 CORNER
OF SECTION 29-02-17
ELEV=901.88 NAVD88

NOTE: Only those Building Line Restrictions or Easements shown on a Recorded Subdivision Plat are shown hereon unless the description ordered to be surveyed contains a proper description of the required building lines or easements.
• No distance should be assumed by scaling.
• No underground improvements have been located unless shown and noted.
• No representation as to ownership, use, or possession should be hereon implied.
• This Survey and Plat of Survey are void without original embossed or colored seal and signature affixed.

Compare your description and site markings with this plat and AT ONCE report any discrepancies which you may find.



9/4/20 APG - REVISED LOTS PER CONDO ADDENDUM 2

STATE OF ILLINOIS)
COUNTY OF McHENRY) S.S.

In my professional opinion, and based on my observations, I hereby certify that the above described property has been surveyed under my direction and that the above map is a true representation thereof and shows the size and location of all visible structures, and dimensions of all principle buildings thereon, boundary fences, apparent easements, roadways, and visible encroachments, if any. This survey is made for the use of the present owners of the property, and also those who purchase, mortgage, or guarantee the title thereto within one year from the date hereof.

Dated at Woodstock, McHenry County, Illinois 8/18 A.D., 20 20.

Vanderstappen Land Surveying, Inc.
Design Firm No. 184-002792

By: Wisconsin Registered Land Surveyor No. S1777

CLIENT: TY LAURIE
DRAWN BY: PJD CHECKED BY: WJV
SCALE: 1"=20' SEC. 29 T. 02 R. 17 E.
BASIS OF BEARING: ASSUMED
P.L.N.: JGN2600011, 12, 13
JOB NO.: 200623 I.D. LSS
FIELDWORK COMP.: 08/10/20 BK. PG.
PARTS THEREOF CORRECTED TO 60 F.

JEN 26-11 JEN 26-12 JEN 26-13

217-4730