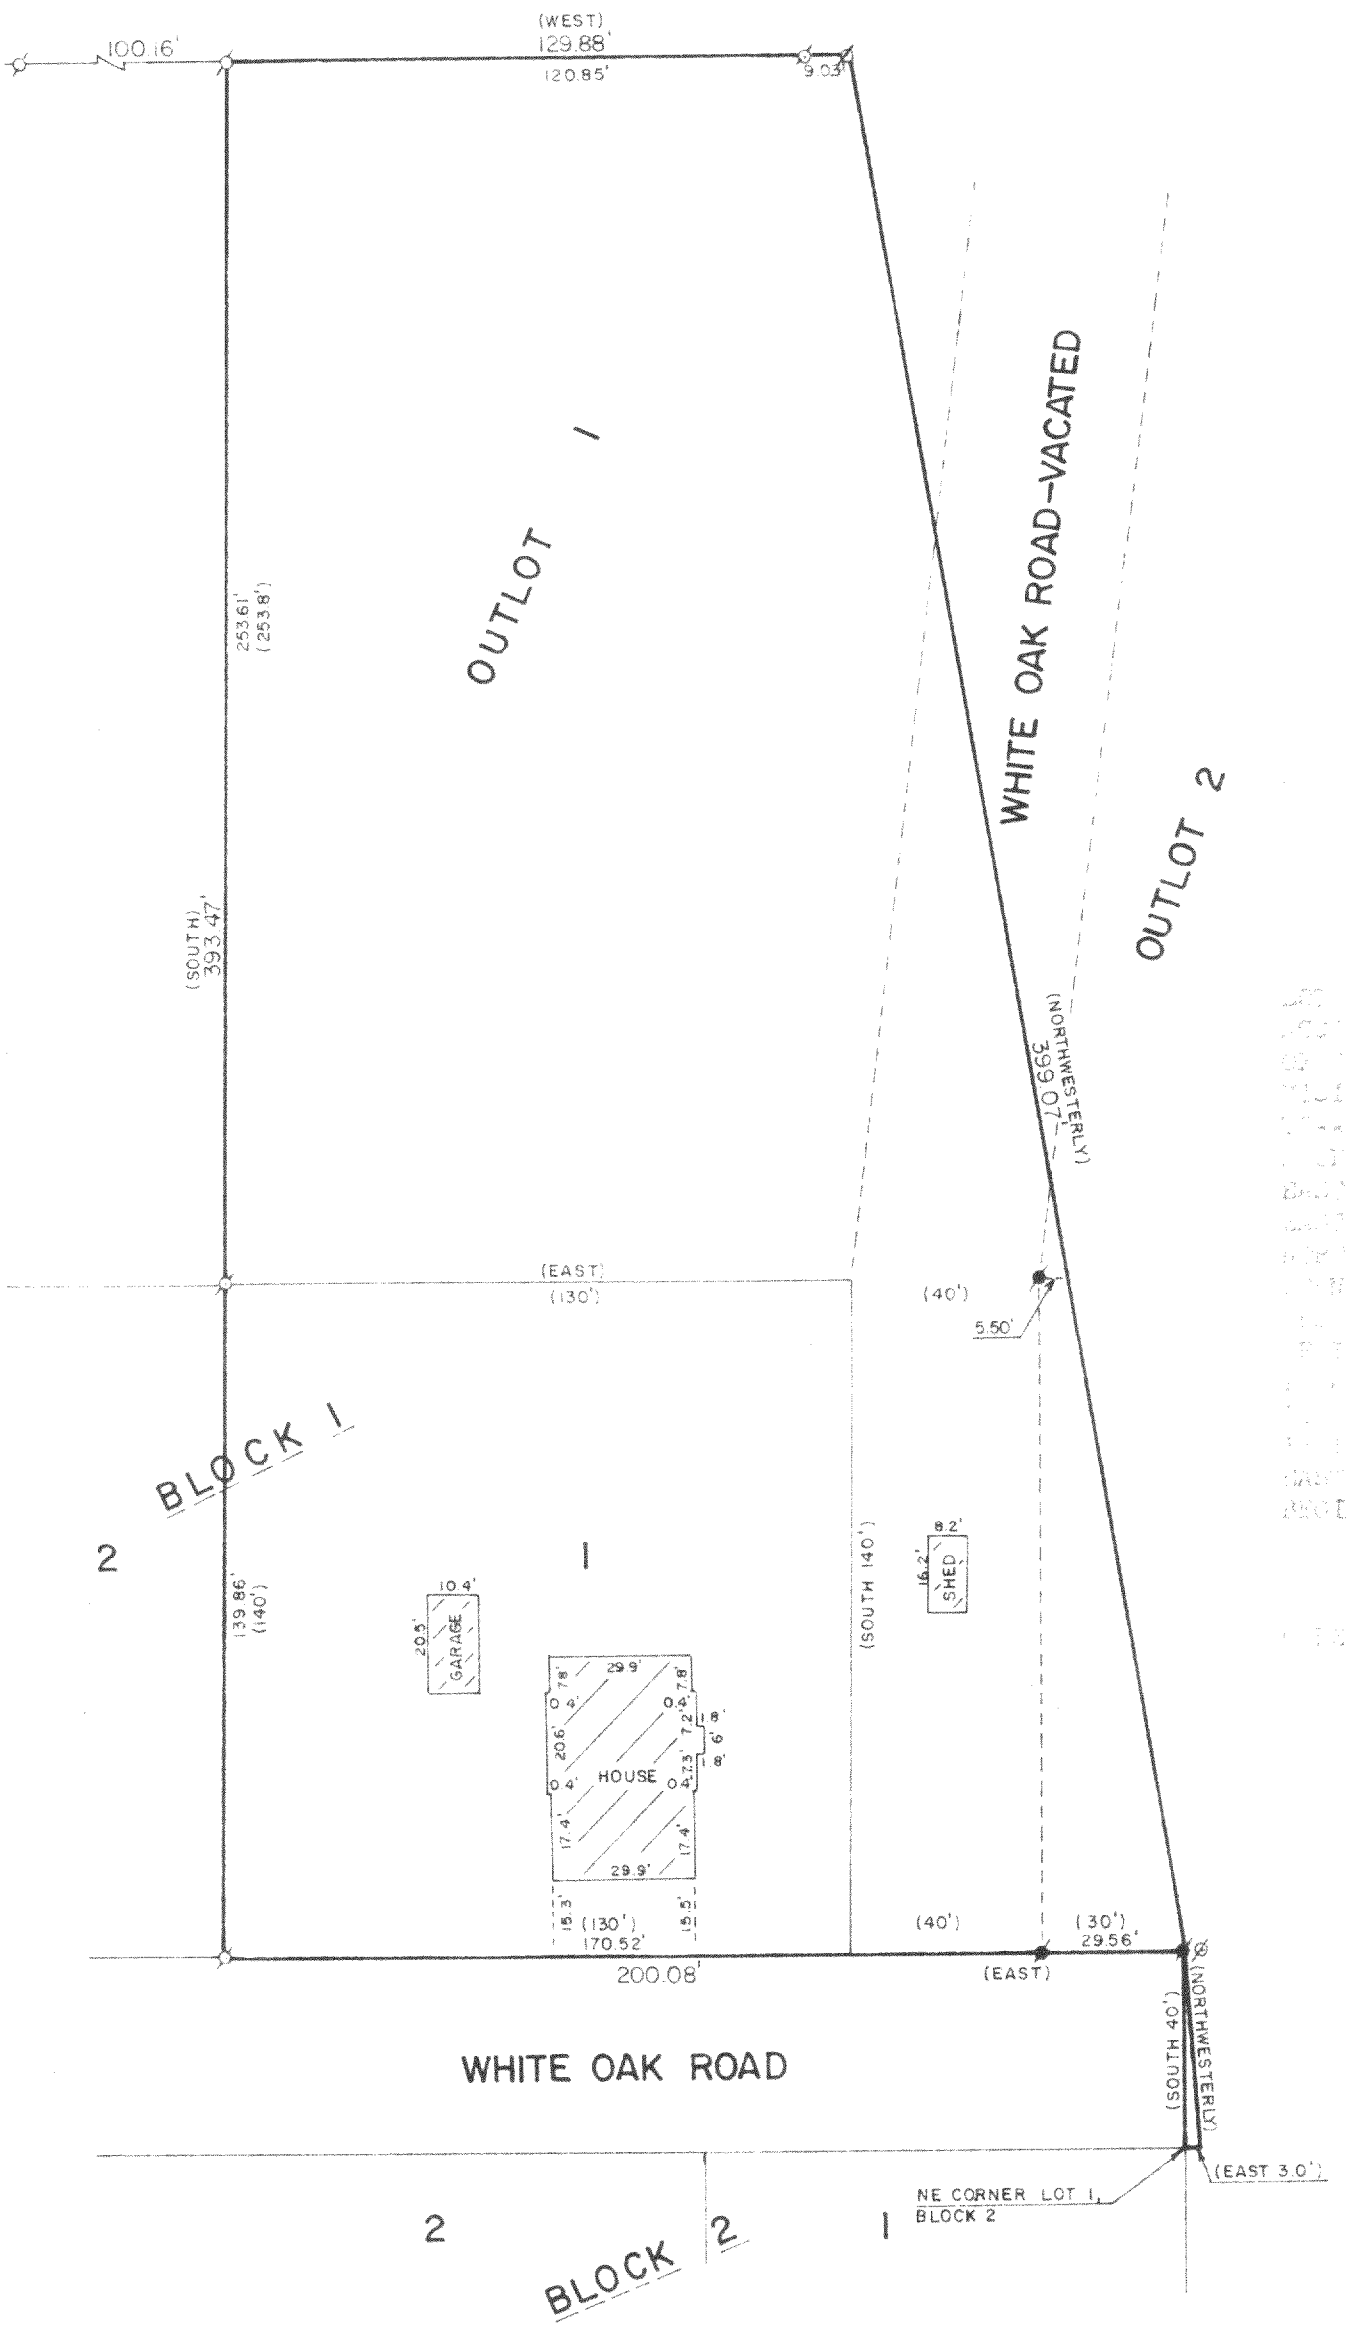

RECEIVED
SEP 19 '87

Robert M. Baumwald

Sept. 2, 1987

JLAU-1

217-706