TOPOGRAPHICAL MAPPING

LOTS 399 THROUGH 403 OF BLOCK 8 OF THE THIRD MAP OF LAKE COMO BEACH SUBDIVISION

LOCATED IN THE SE 1/4 OF SECTION 22, TOWN 2 NORTH, RANGE 17 EAST, TOWN OF GENEVA, WALWORTH COUNTY, WISCONSIN

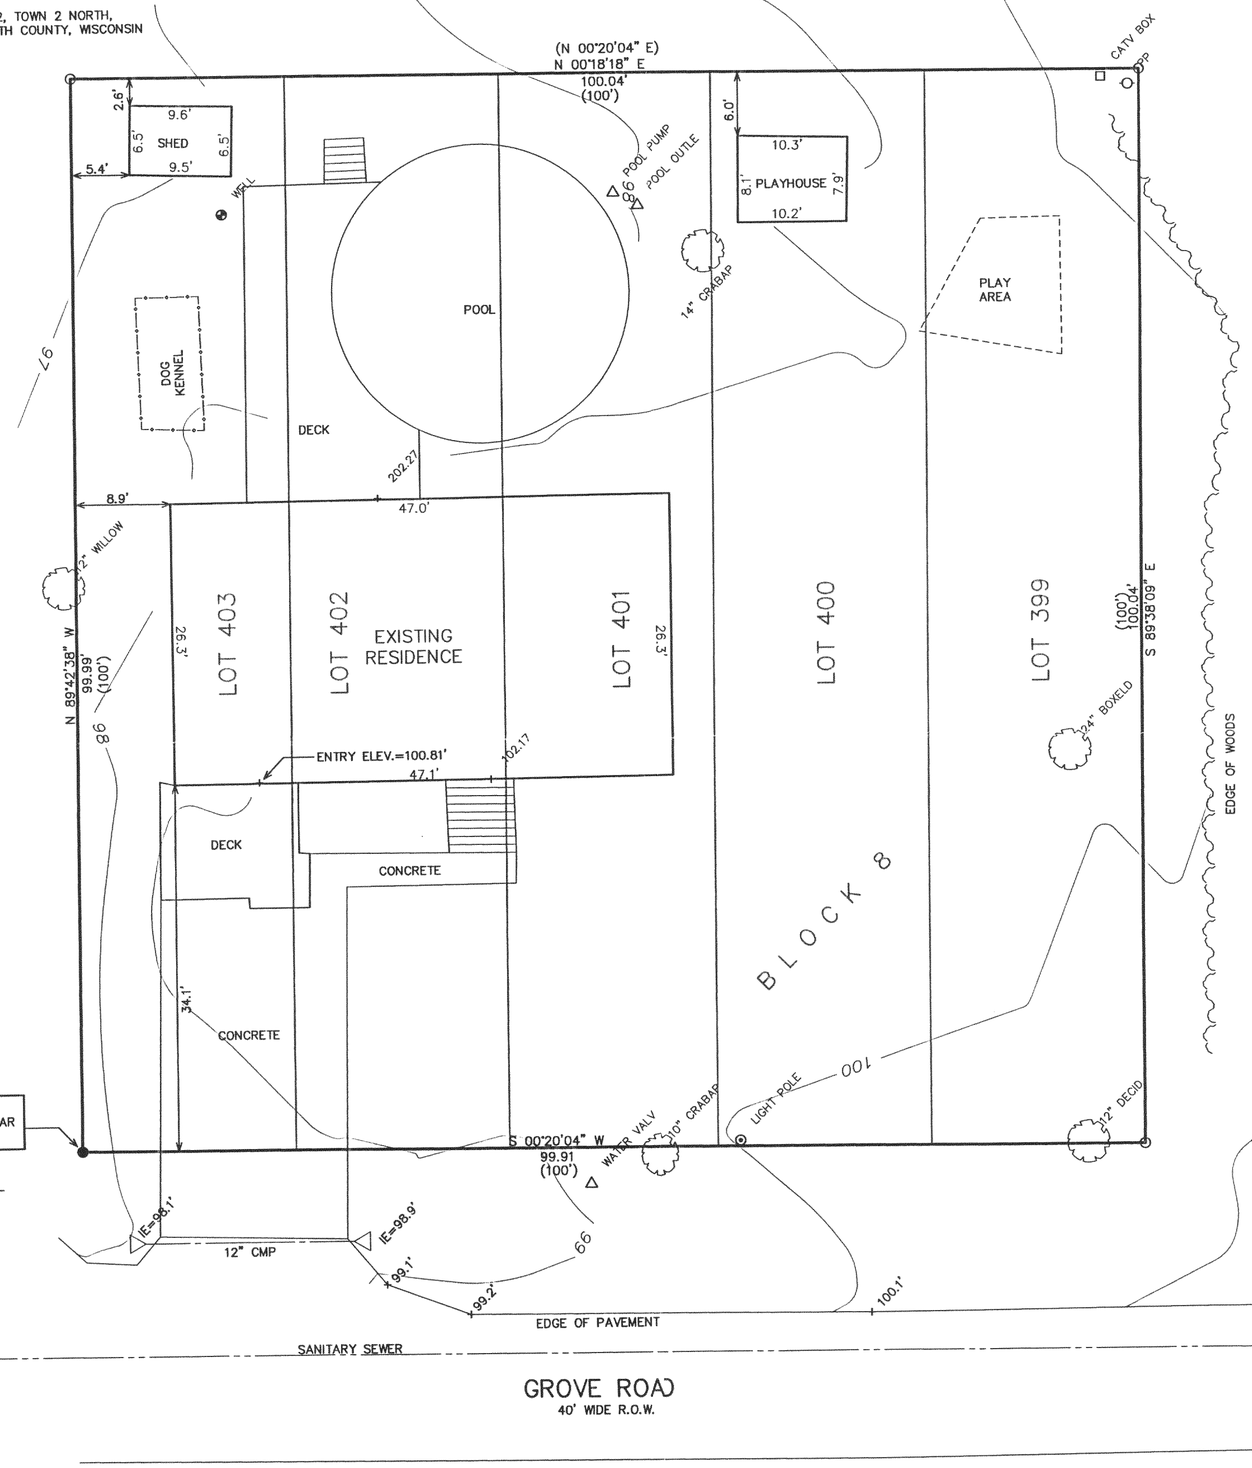

NOTE: COPIES OF THIS MAP TO WHICH THE FOLLOWING CERTIFICATE WILL APPLY SHOW THE SURVEYOR'S ORIGINAL SEAL AND SIGNATURE IN RED INK. COPIES BY ANY OTHER MEANS MAY HAVE ALTERATIONS WHICH DO NOT REPRESENT THE SURVEYOR'S WORK PRODUCT.

I HEREBY CERTIFY THAT THE ABOVE DESCRIBED PROPERTY HAS BEEN SURVEYED UNDER MY DIRECTION AND THAT THE ABOVE MAP IS A TRUE REPRESENTATION THEREOF AND SHOWS THE SIZE AND LOCATION OF THE PROPERTY AND ITS EXTERIOR BOUNDARIES. THIS SURVEY IS MADE FOR THE USE OF THE PRESENT OWNERS OF THE PROPERTY, AND ALSO THOSE WHO PURCHASE, MORTGAGE, OR GUARANTEE THE TITLE THERETO WITHIN ONE YEAR FROM THE DATE HEREOF.

DATED: 08/06/02

PETER S. GORDON R.L.S. 2101

BENCH MARK
FOUND IRON REBAR
ELEV.=97.58'

BENCH MARK
SANITARY MANHOLE
ELEV.=96.01'

LEGEND

● = FOUND IRON REBAR STAKE

O = FOUND IRON PIPE STAKE

(XXX) = RECORDED AS

RECEIVED
AUG 13 2002
HPG

– WORK ORDERED BY –
OREST DUTKO
N3333 GROVE ROAD
LAKE GENEVA, WI 53147

FARRIS, HANSEN & ASSOCIATES, INC.
ENGINEERING – ARCHITECTURE – SURVEYING
7 RIDGWAY COURT P.O. BOX 437
ELKHORN, WISCONSIN 53121
OFFICE: (262) 723-2098 FAX: (262) 723-5886

REVISIONS

PROJECT NO.	6088
DATE:	08/06/02
SHEET NO.	1 OF 1

AUG 06 2002

JLCB-56

217-2327