PROPERTY SURVEY

PREPARED FOR: **LARRY RYGIELSKI & REBEKAH FOX /**
GENERATION BUILDERS

LOCATION: KRUEGER ROAD (TOWN OF GENEVA)

DESCRIPTION OF PROPERTY

LOT 3 OF **CERTIFIED SURVEY MAP NO. 2911**, DOCUMENT NO. 366205, VOLUME 15, PAGES 149-153, A RESUBDIVISION OF LOT 4 OF CERTIFIED SURVEY MAP NO. 2072, LOCATED IN THE SOUTHEAST 1/4 OF SECTION 23, TOWN 2 NORTH, RANGE 17 EAST, TOWN OF GENEVA, WALWORTH COUNTY, WISCONSIN.

(207,281 SQ.FT.)

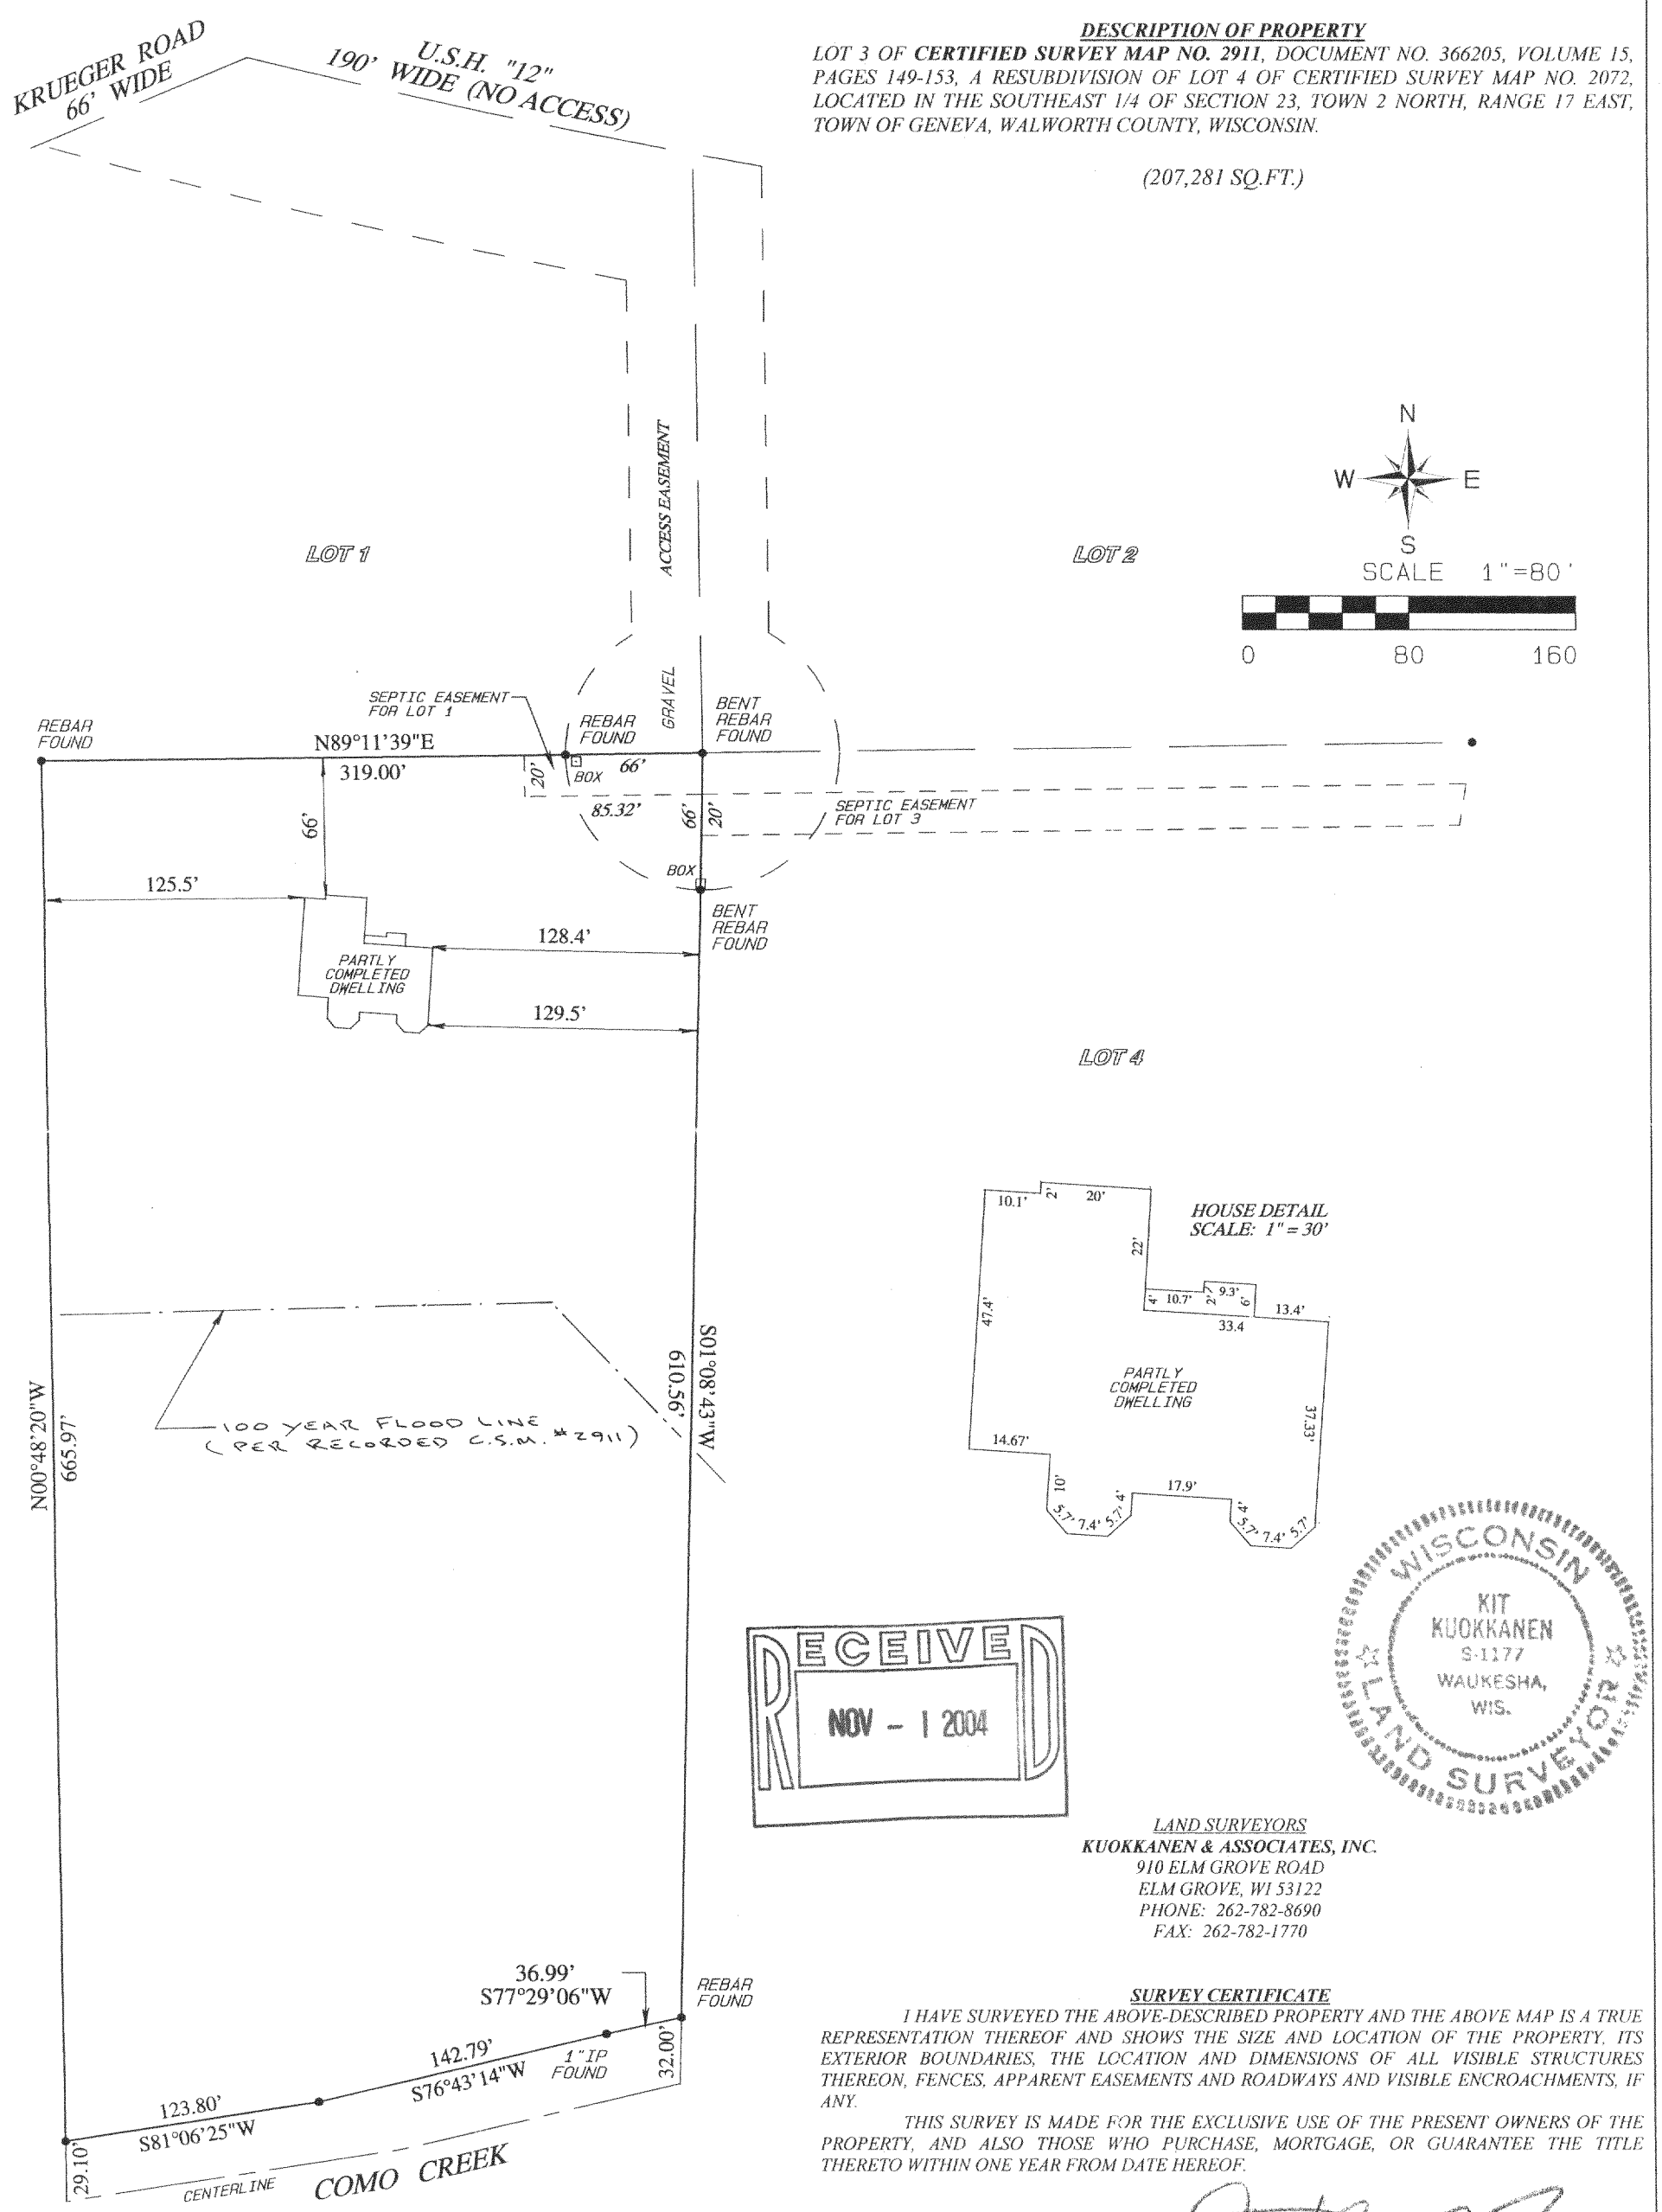

RECEIVED
NOV - 1 2004

WISCONSIN
KIT KUOKKANEN
S-1177
WAUKESHA, WIS.
LAND SURVEYOR

LAND SURVEYORS
KUOKKANEN & ASSOCIATES, INC.
910 ELM GROVE ROAD
ELM GROVE, WI 53122
PHONE: 262-782-8690
FAX: 262-782-1770

SURVEY CERTIFICATE

I HAVE SURVEYED THE ABOVE-DESCRIBED PROPERTY AND THE ABOVE MAP IS A TRUE REPRESENTATION THEREOF AND SHOWS THE SIZE AND LOCATION OF THE PROPERTY, ITS EXTERIOR BOUNDARIES, THE LOCATION AND DIMENSIONS OF ALL VISIBLE STRUCTURES THEREON, FENCES, APPARENT EASEMENTS AND ROADWAYS AND VISIBLE ENCROACHMENTS, IF ANY.

THIS SURVEY IS MADE FOR THE EXCLUSIVE USE OF THE PRESENT OWNERS OF THE PROPERTY, AND ALSO THOSE WHO PURCHASE, MORTGAGE, OR GUARANTEE THE TITLE THERETO WITHIN ONE YEAR FROM DATE HEREOF.

JANUARY 26, 2004
DATE
REV. 2-18-04
RECERTIFICATION 8-11-04

KIT KUOKKANEN
REGISTERED LAND SURVEYOR
S-1177

04-1513-15

JA2911-3

217-2934