


PLAT OF SURVEY

LOT 1 OF CERTIFIED SURVEY MAP NO. 2722
 RECORDED AS DOCUMENT NO. 333940 IN VOLUME 14 ON PAGE 59
 LOCATED IN PART OF THE SOUTHEAST 1/4 OF THE NORTHEAST 1/4 OF SECTION 33,
 TOWN 2 NORTH, RANGE 17 EAST, WALWORTH COUNTY, WISCONSIN

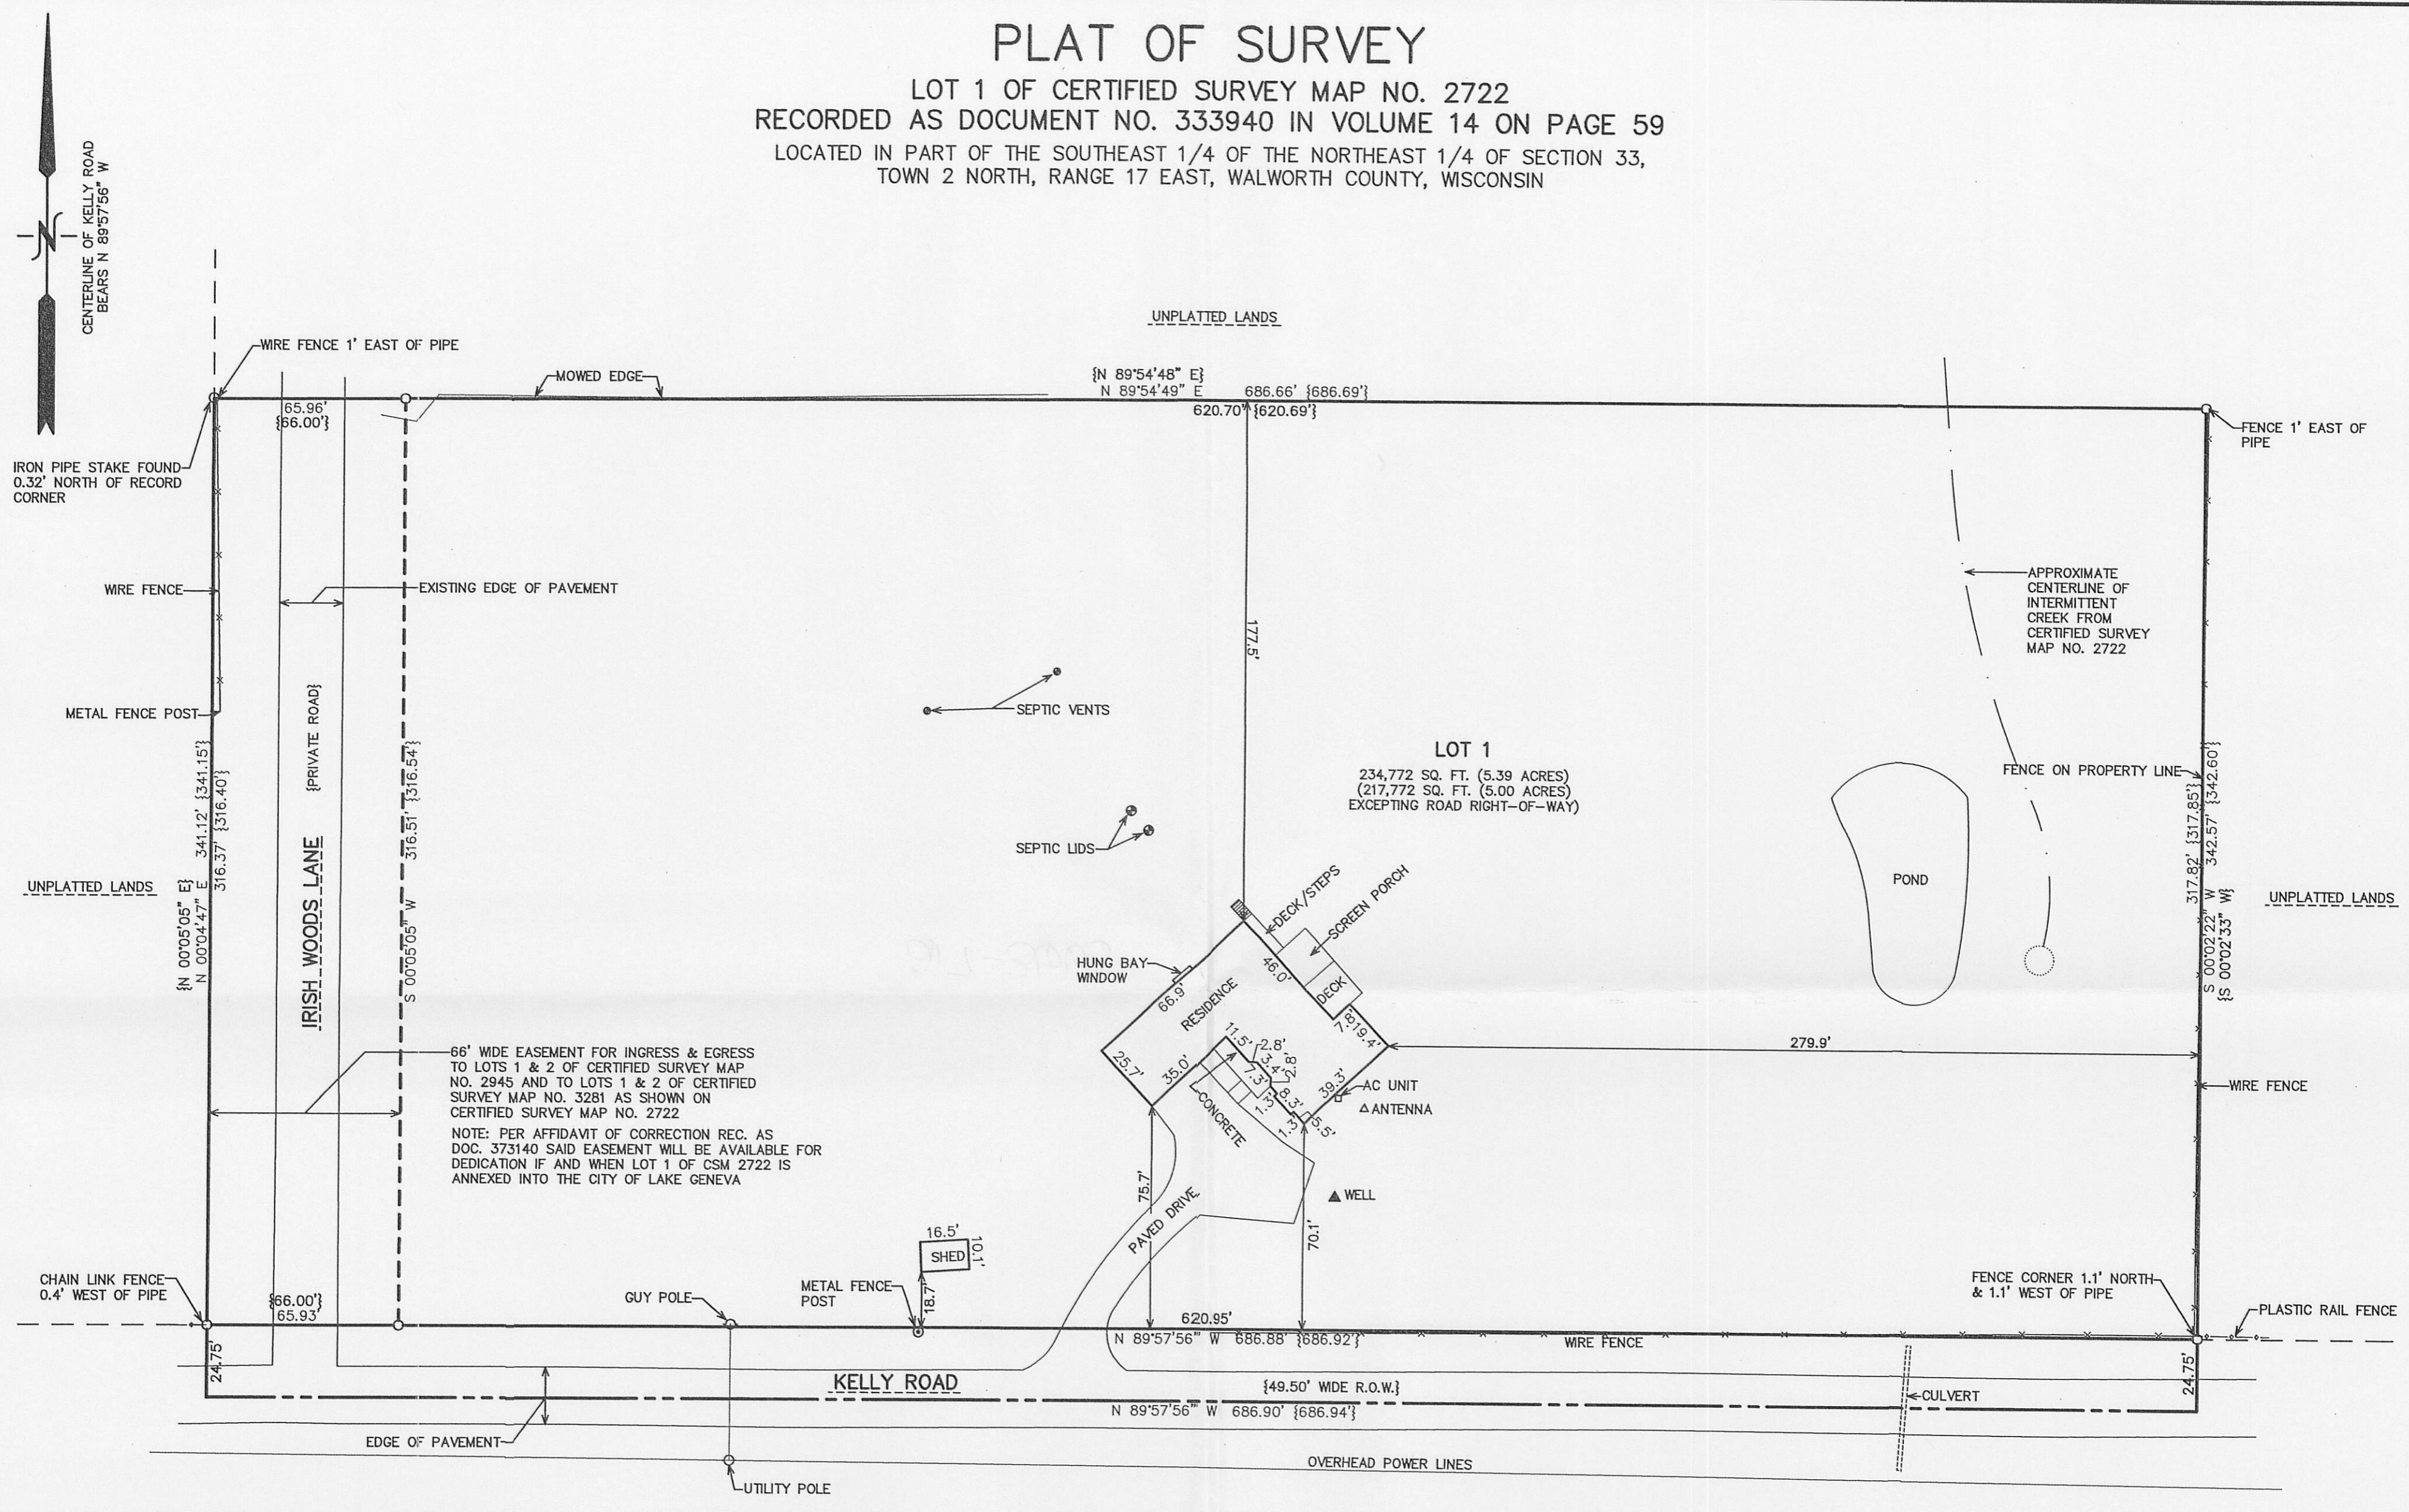

66' WIDE EASEMENT FOR INGRESS & EGRESS TO LOTS 1 & 2 OF CERTIFIED SURVEY MAP NO. 2945 AND TO LOTS 1 & 2 OF CERTIFIED SURVEY MAP NO. 3281 AS SHOWN ON CERTIFIED SURVEY MAP NO. 2722
 NOTE: PER AFFIDAVIT OF CORRECTION REC. AS DOC. 373140 SAID EASEMENT WILL BE AVAILABLE FOR DEDICATION IF AND WHEN LOT 1 OF CSM 2722 IS ANNEXED INTO THE CITY OF LAKE GENEVA

LEGEND
 O = FOUND IRON PIPE STAKE
 {XXX} = RECORDED AS

NOTE: COPIES OF THIS MAP TO WHICH THE FOLLOWING CERTIFICATE WILL APPLY SHOW THE SURVEYOR'S ORIGINAL SEAL AND SIGNATURE IN RED INK. COPIES BY ANY OTHER MEANS MAY HAVE ALTERATIONS WHICH DO NOT REPRESENT THE SURVEYOR'S WORK PRODUCT.



I HEREBY CERTIFY THAT THE ABOVE DESCRIBED PROPERTY HAS BEEN SURVEYED UNDER MY DIRECTION AND THAT THE ABOVE MAP IS A TRUE REPRESENTATION THEREOF AND SHOWS THE SIZE AND LOCATION OF THE PROPERTY, ITS EXTERIOR BOUNDARIES, THE LOCATION OF ALL VISIBLE STRUCTURES, AND DIMENSIONS OF ALL PRINCIPLE BUILDINGS THEREON, BOUNDARY FENCES, APPARENT EASEMENTS, ROADWAYS, AND VISIBLE ENCROACHMENTS, IF ANY. THIS SURVEY IS MADE FOR THE USE OF THE PRESENT OWNERS OF THE PROPERTY, AND ALSO THOSE WHO PURCHASE, MORTGAGE, OR GUARANTEE THE TITLE THERETO WITHIN ONE YEAR FROM THE DATE HEREOF.

DATED: AUGUST 23, 2010



Peter S. Gordon
 PETER S. GORDON

Lot 1 of Certified Survey Map No. 2722, recorded July 12, 1996 in Volume 14 of Certified Surveys on page 59 as Document No. 333940 and located in the Southeast 1/4 of the Northeast 1/4 of Section 33, T2N, R17E, Walworth County, Wisconsin.
 Tax Key No: JA272200001

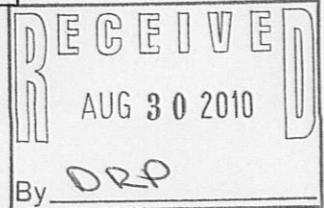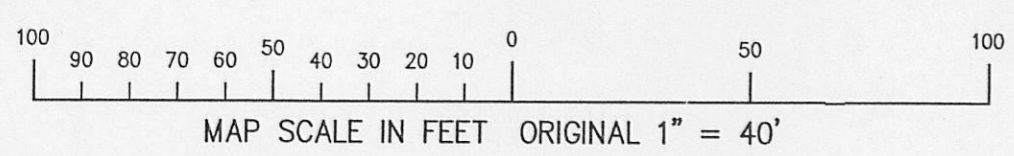

WORK ORDERED BY -
 BOB RAULAND
 C/O THE RAULAND AGENCY
 118 KENOSHA STREET
 WALWORTH, WISCONSIN 53184

FARRIS, HANSEN & ASSOCIATES, INC.
 ENGINEERING - ARCHITECTURE - SURVEYING
 7 RIDGWAY COURT P.O. BOX 437
 ELKHORN, WISCONSIN 53121
 OFFICE: (262) 723-2098 FAX: (262) 723-5886

REVISIONS

PROJECT NO. 8205
 DATE: 8/5/2010
 SHEET NO. 1 OF 1

8/23/2010 X:\Projects\8205\Doc\TITSUR_20100805

AUG 23 2010

JA2722-1

217-3603