


JAN 28 2016

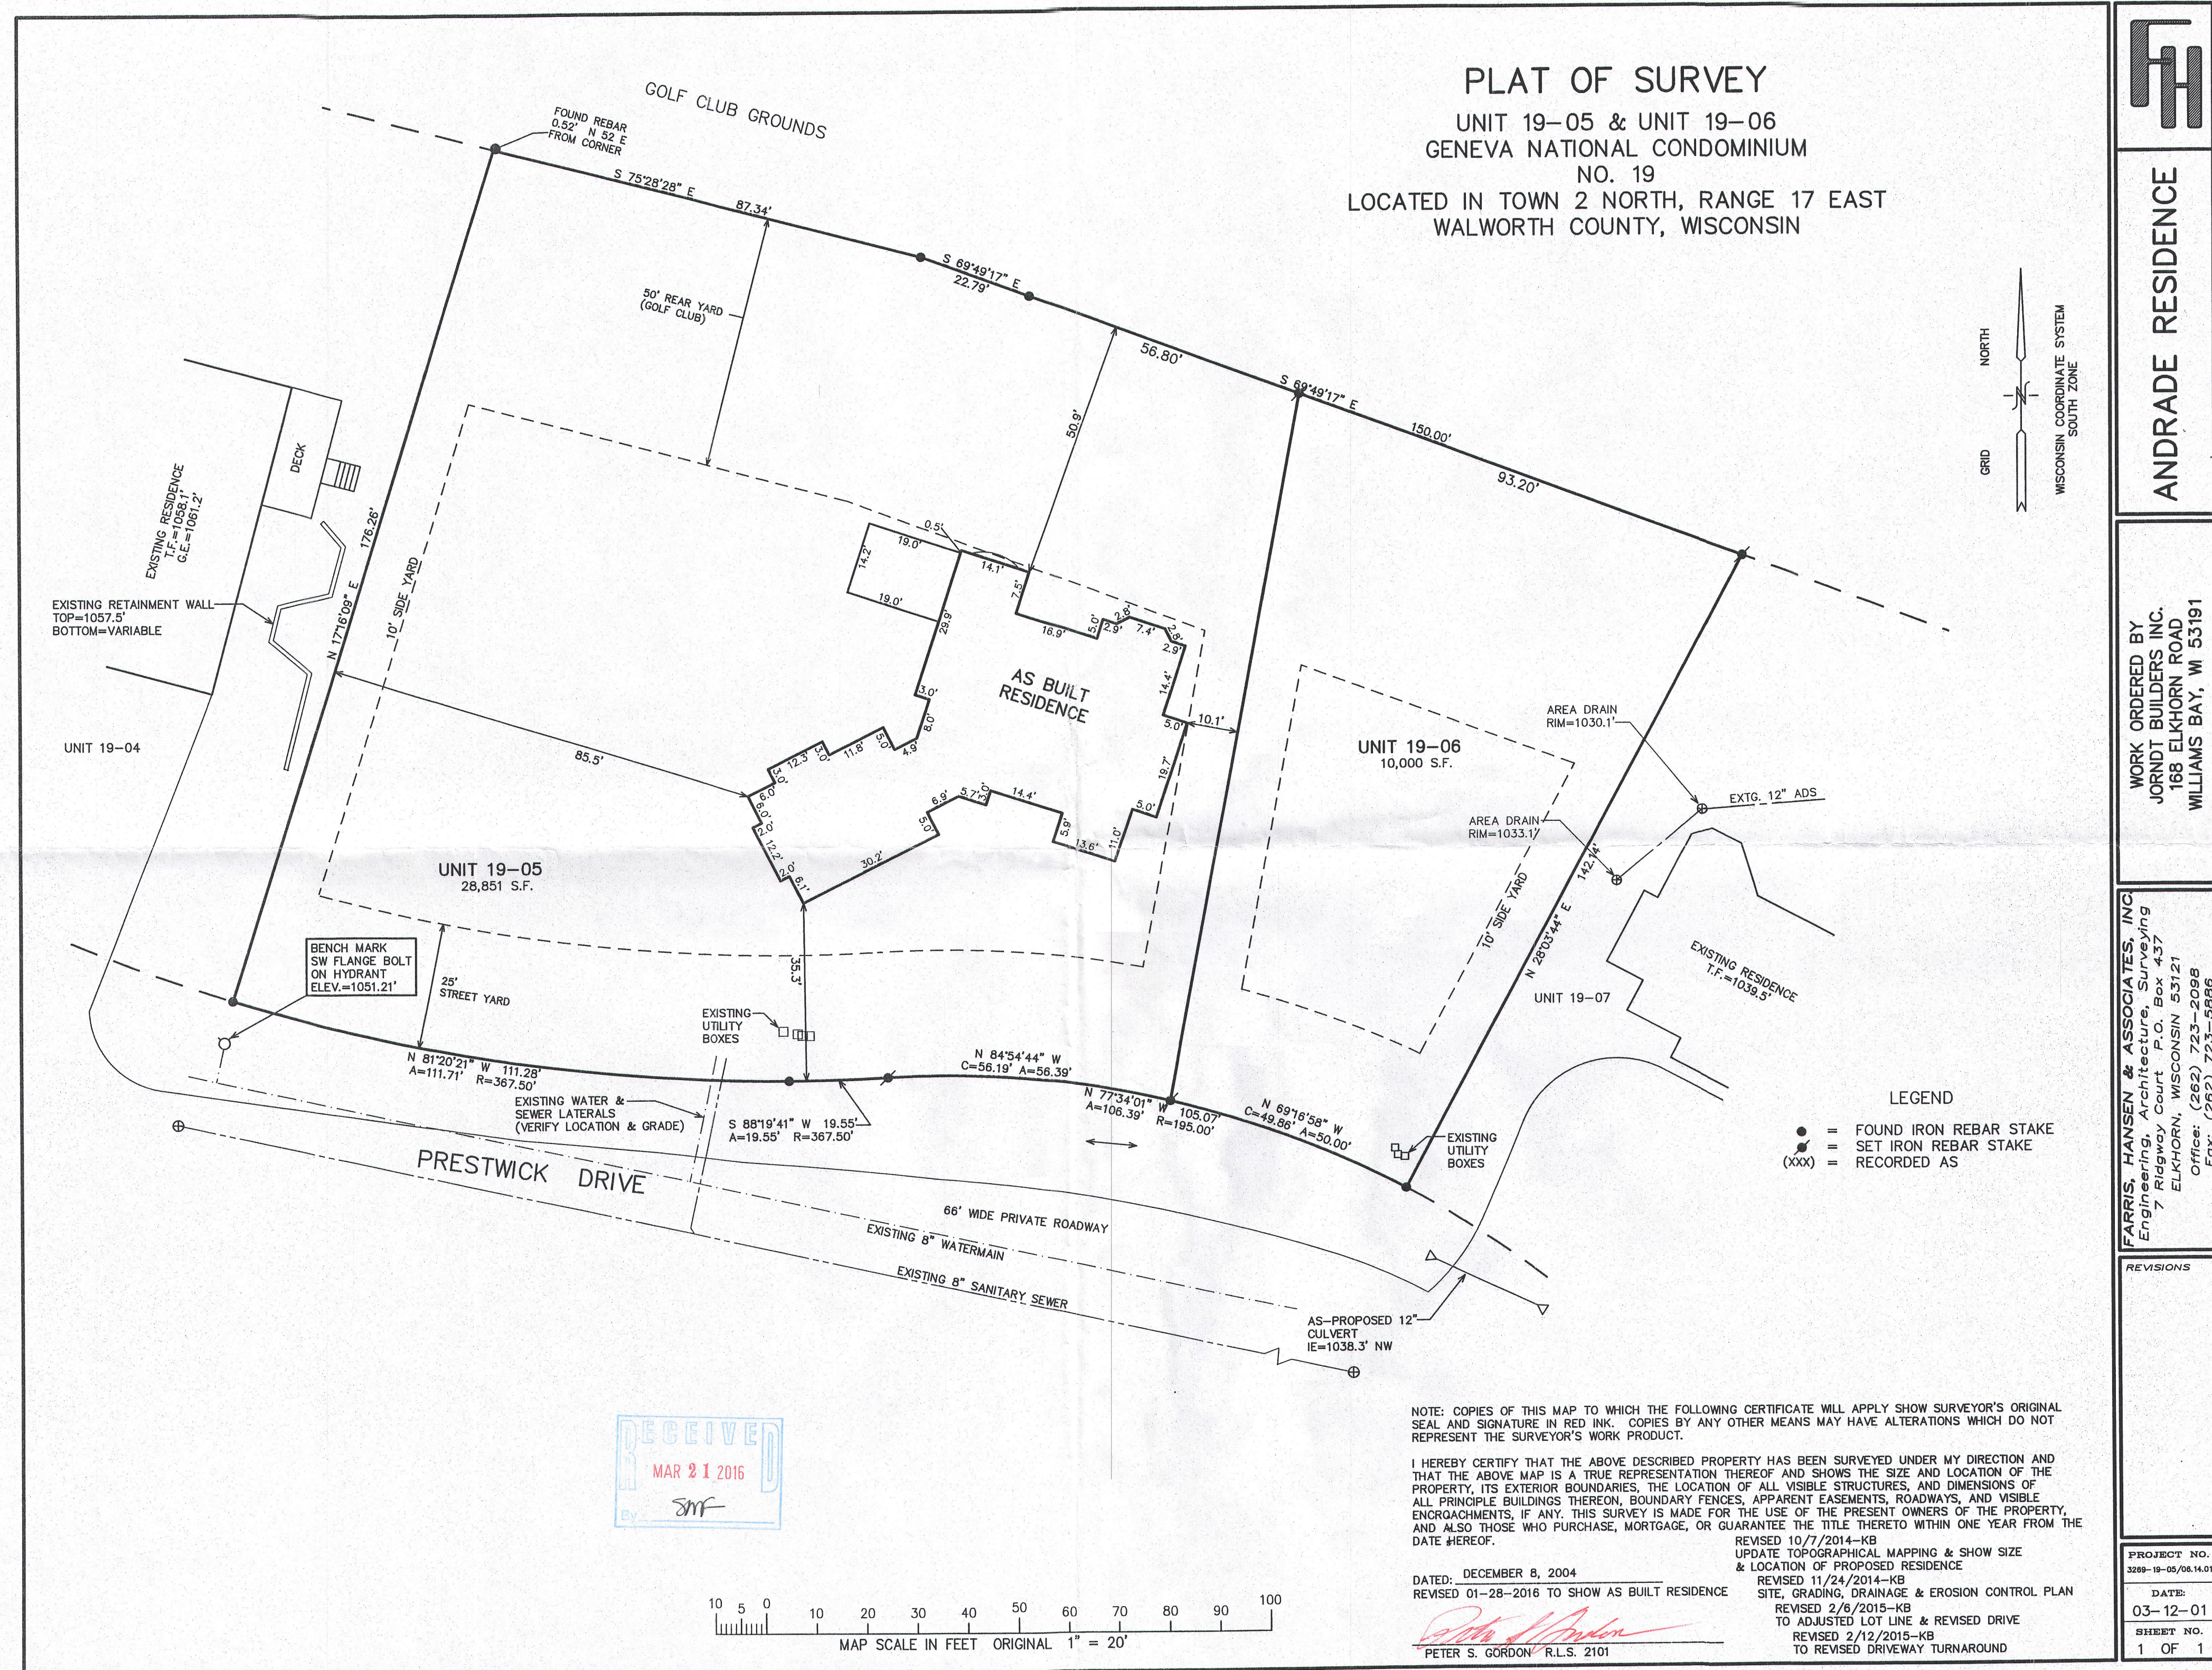

ANDRADE RESIDENCE

WORK ORDERED BY
JORDNT BUILDERS INC.
188 ELKHORN ROAD
WILLIAMS BAY, WI 53191

FARRIS, HANSEN & ASSOCIATES, INC.
Engineering, Architecture, Surveying
7 Ridgeway Court P.O. Box 437
ELKHORN, WISCONSIN 53121
Office: (262) 723-2098
Fax: (262) 723-5886

JCN 19-5 JCN 19-6

217 4186