


NOV 09 2017

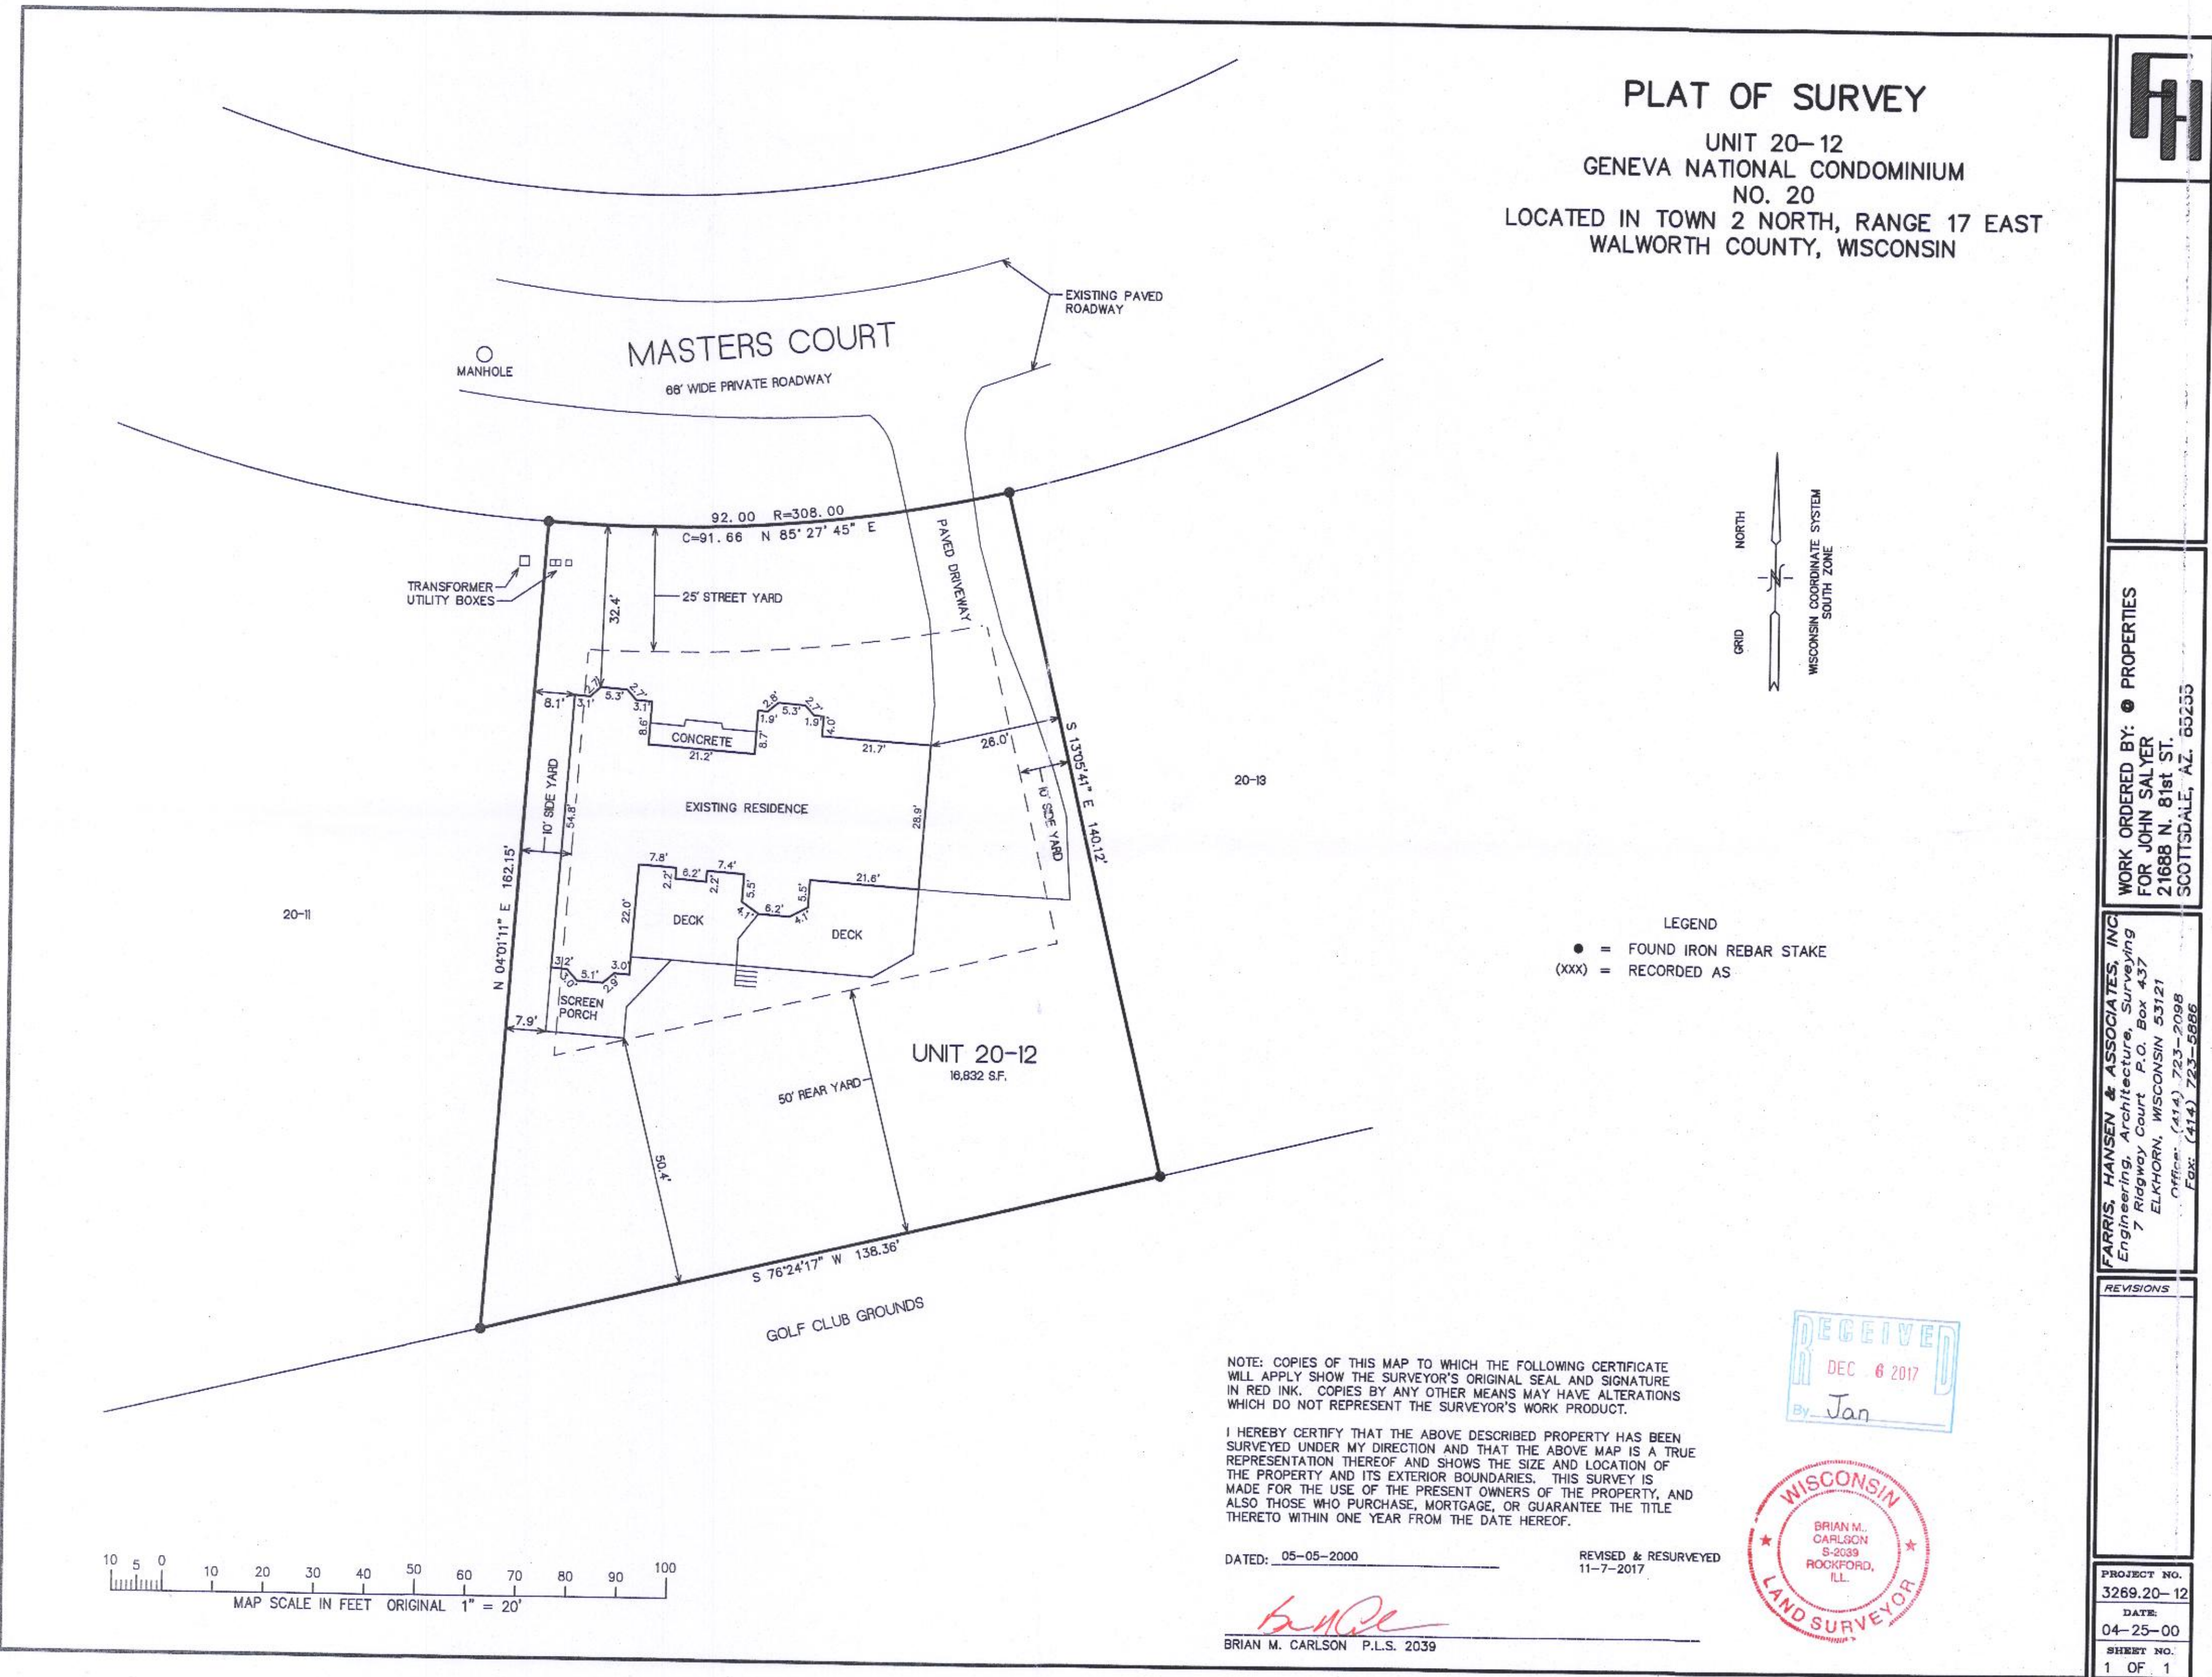

JGN 20-12 217-4390