


—OF—

LOT 2 OF C.S.M. NO. 3827

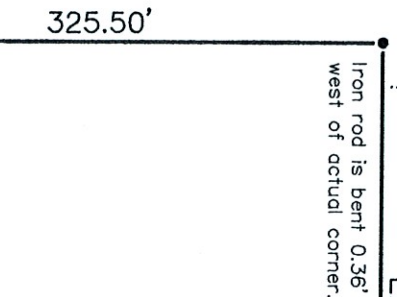


EAST

.....

325.50'

- LOT 3 OF C.S.M. NO. 2394*
5.00 acres including road right-of-way
4.69 acres excluding road right-of-way

M. NO. 2614

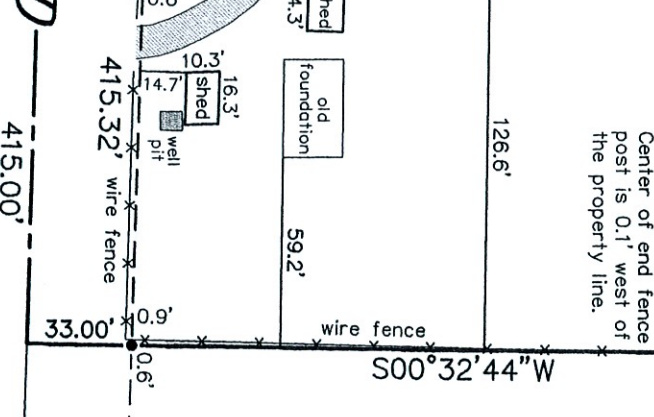

NOTE: REFER TO A CURRENT TITLE REPORT FOR EASEMENTS, RESTRICTIONS OR COVENANTS WHICH MAY AFFECT THIS PROPERTY.

James Z. Sather

THIS IS NOT AN ORIGINAL PRINT
UNLESS THIS SEAL IS RED.

092201

JOB NUMBER