KOLB LAND CONSULTING, INC.

BUILDING STAKE-OUT

ON LOT 3, CERTIFIED SURVEY MAP NUMBER 792

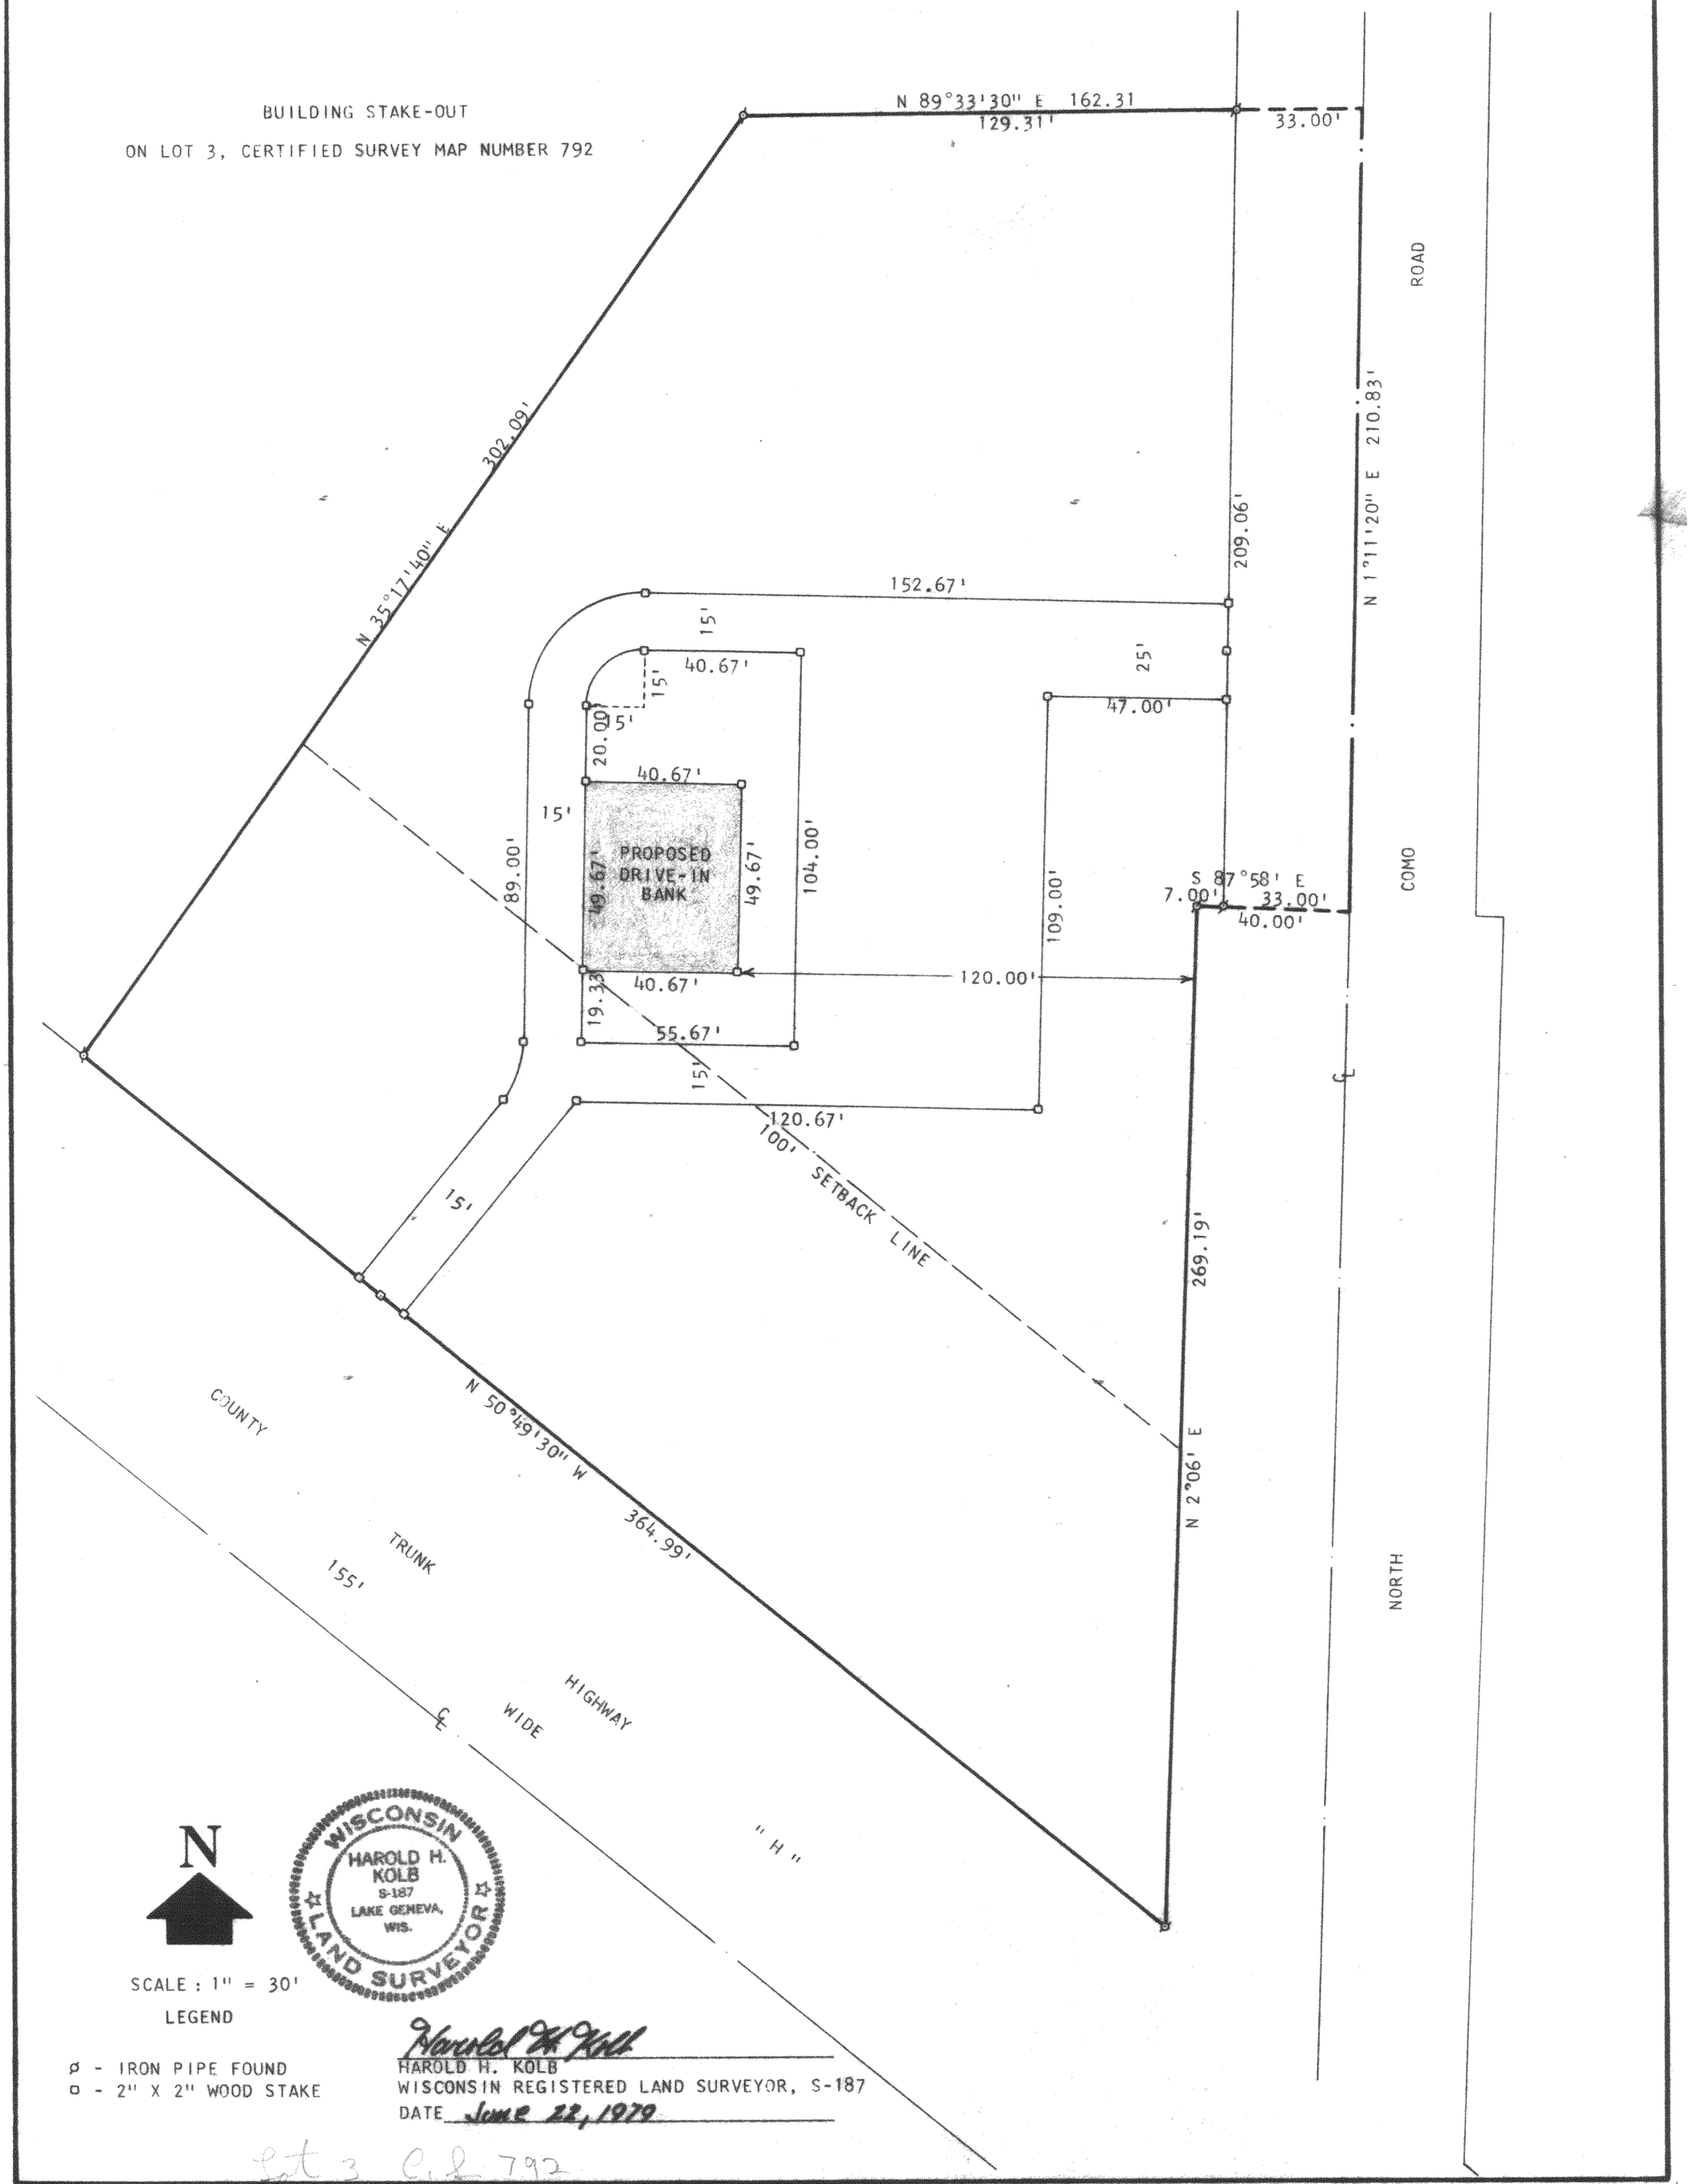

N

SCALE : 1" = 30'

LEGEND

ø - IRON PIPE FOUND
□ - 2" X 2" WOOD STAKE

WISCONSIN
HAROLD H. KOLB
S-187
LAKE GENEVA, WIS.
LAND SURVEYOR

Harold H. Kolb
HAROLD H. KOLB
WISCONSIN REGISTERED LAND SURVEYOR, S-187
DATE June 22, 1979

Lot 3 C.S. 792
Sec 21-2-17

217-560K