


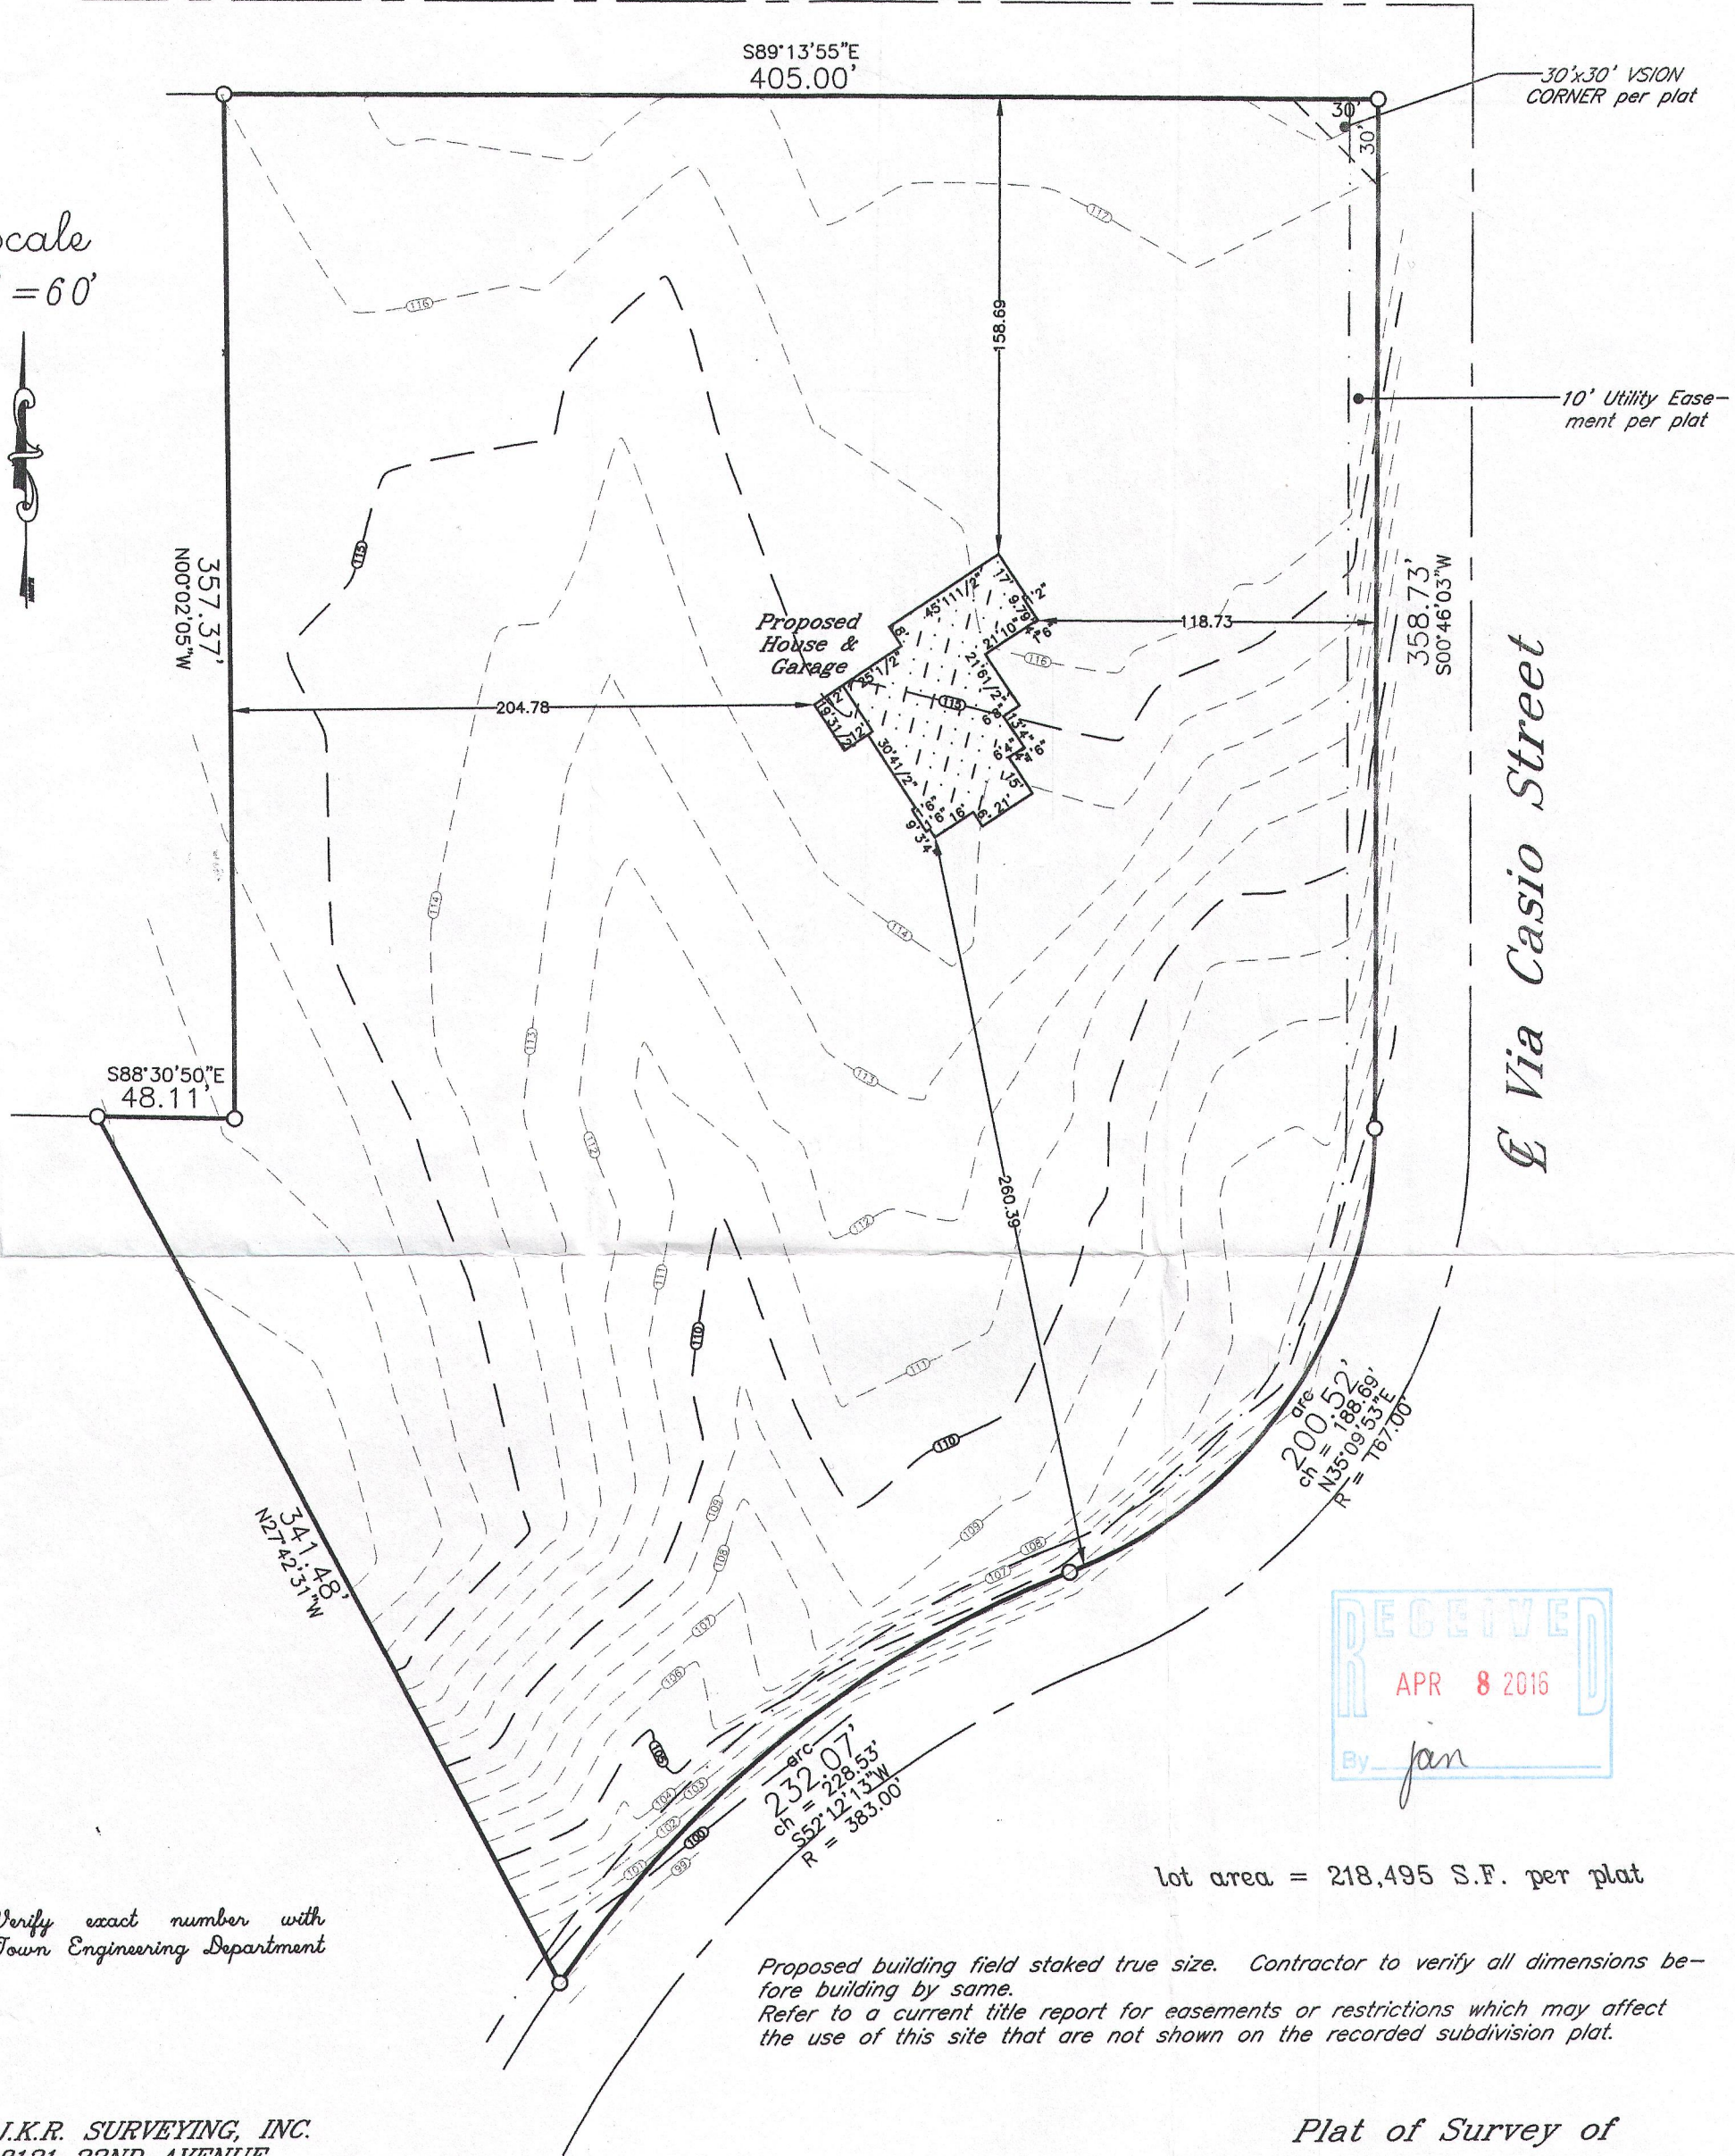

*Proposed building field staked true size. Contractor to verify all dimensions before building by same.
Refer to a current title report for easements or restrictions which may affect the use of this site that are not shown on the recorded subdivision plat.*

A circular professional seal for a Wisconsin Land Surveyor. The outer ring contains the text "WISCONSIN" at the top and "LAND SURVEYOR" at the bottom, separated by two five-pointed stars. The inner circle contains the text "JEFFREY K. RAMPART" in large capital letters, followed by "2141" (the license number), "KENOSHA," (the location), and "WI" (the state abbreviation).

Reg. Land Surveyor
November 2, 2015
Revised 12/9/15

* outside finish grade = EL 119.00
(advisory only) - top of foundation = EL 119.67 (advisory only) unless otherwise determined in writing by Town Engineering Department

Plat of Survey of
LOT 32 IN
TUSCANY OF LAKE GENEVA
in SW1/4 Section 34-2-18
TOWN OF LYONS
WALWORTH COUNTY, WIS.
-for-
Serenity Homes

AT 112-8 218-1928