LOT 141 LAKE GENEVA GOLF HILLS

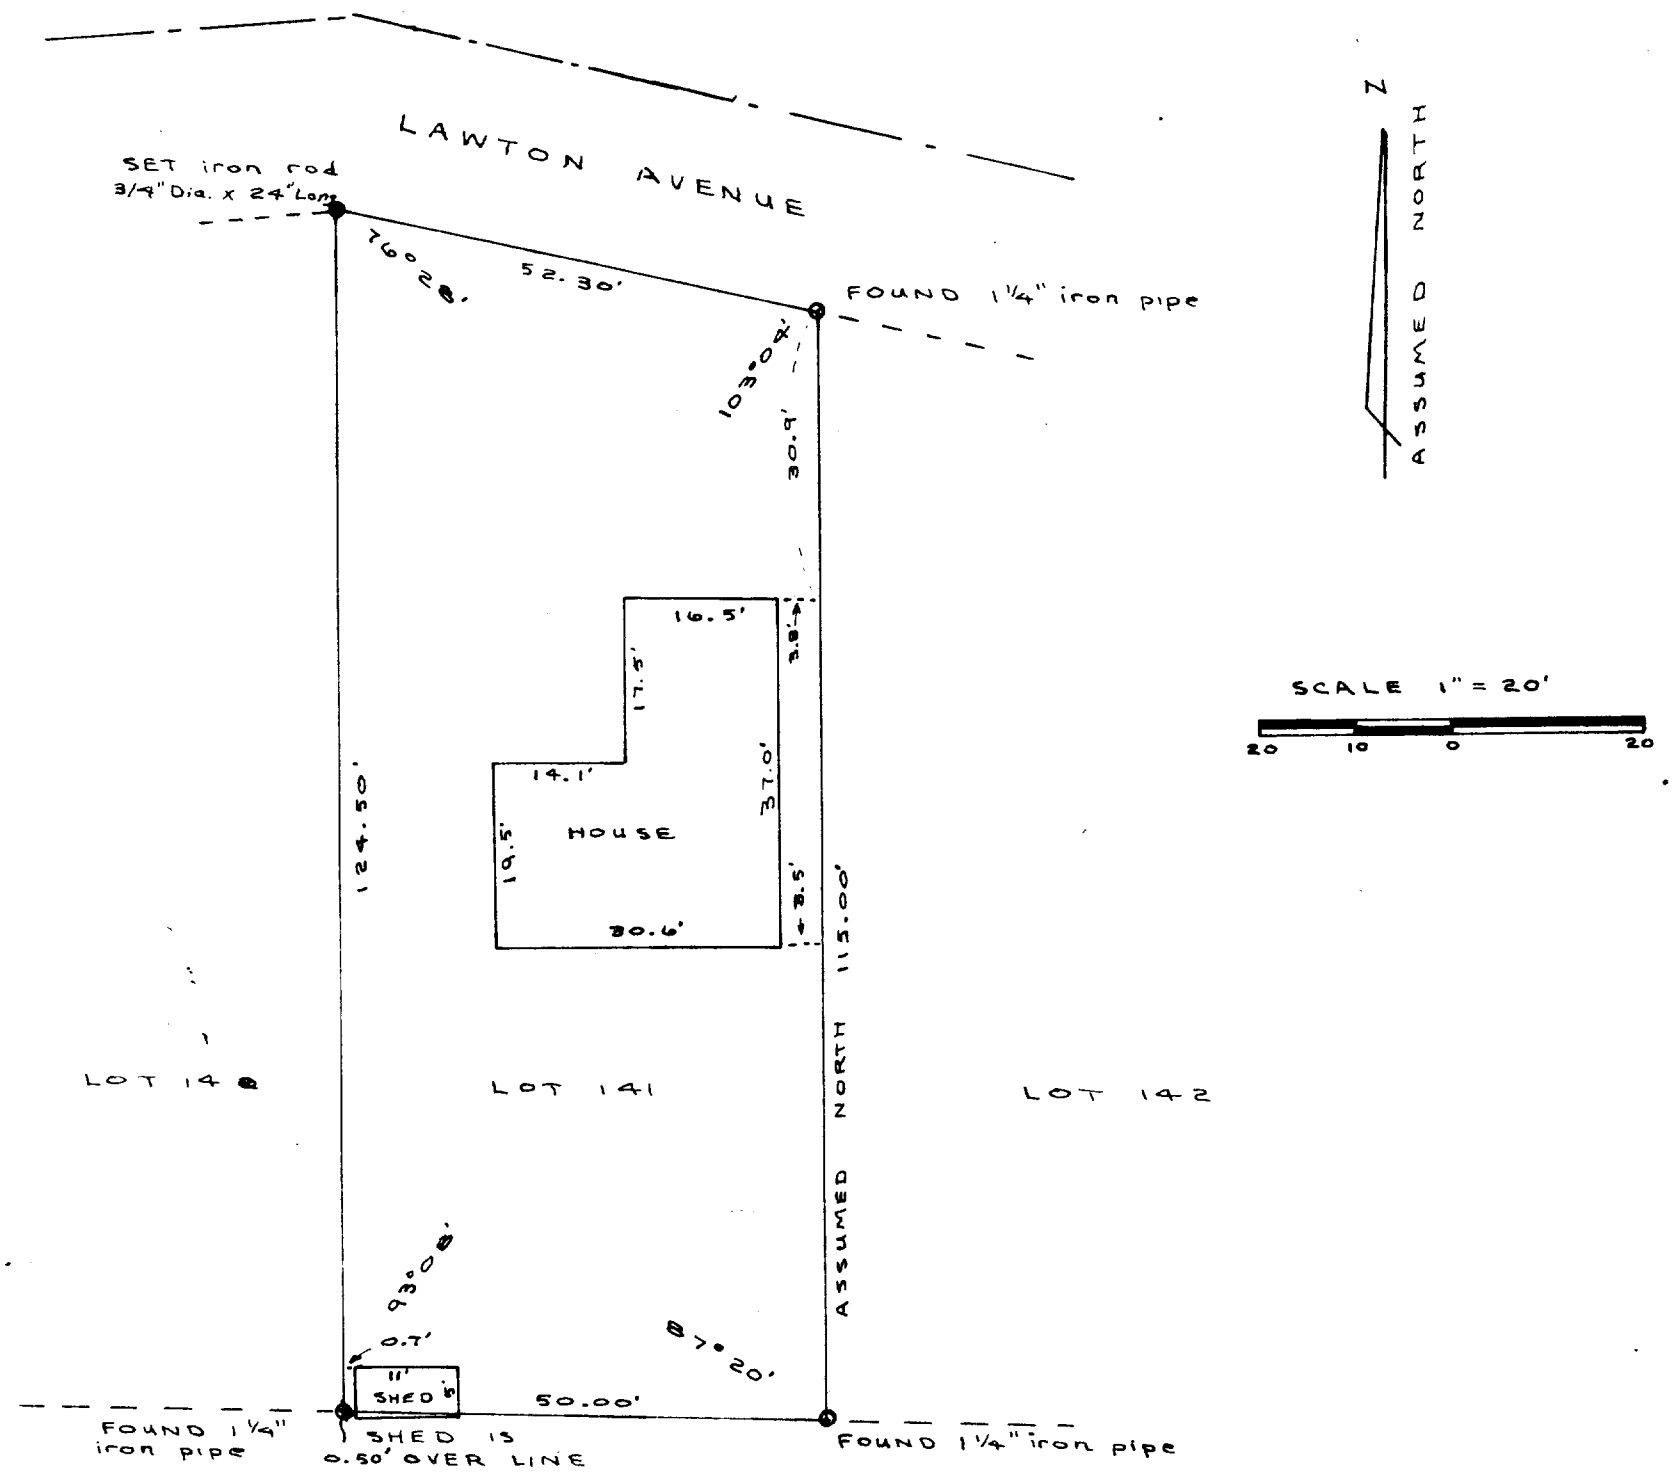

I, Lloyd L. Jensen, Surveyor, hereby certify that Lot 141 of Lake Geneva Golf Hills in Section 31, Town 2 North, Range 18 East, Lyons Township, Walworth County, Wisconsin, has been resurveyed by using the distances as platted by James F. Biagi, R.L.S. No. 272 on July 22, 1968, and that the above map is a true representation thereof and shows the size and location of the property to the best of my knowledge and belief.

Dated this 6th day of October, 1976.

Lloyd L. Jensen, R.L.S. No. S-211

SURVEY AND PLAT FOR Statler Realty

218-221

Job# 1658.068