PREPARED FOR
MAIA WILSON
LAKE GENEVA AREA REALTY, INC.
101 BROAD ST. STE C3
LAKE GENEVA WI. 53147

PLAT OF SURVEY

- OF -

LOT 6 MEADOW HILL FARMS SUBDIVISION, LOCATED IN THE SOUTH 1/2 OF THE SOUTHEAST 1/4 OF SECTION 32 TOWN 2 NORTH, RANGE 18 EAST, WALWORTH COUNTY, WISCONSIN.

PATHFINDER SURVEYING INC.
W2888 KRUEGER RD. UNIT "D"
LAKE GENEVA WI. 53147
(262) 248-3697

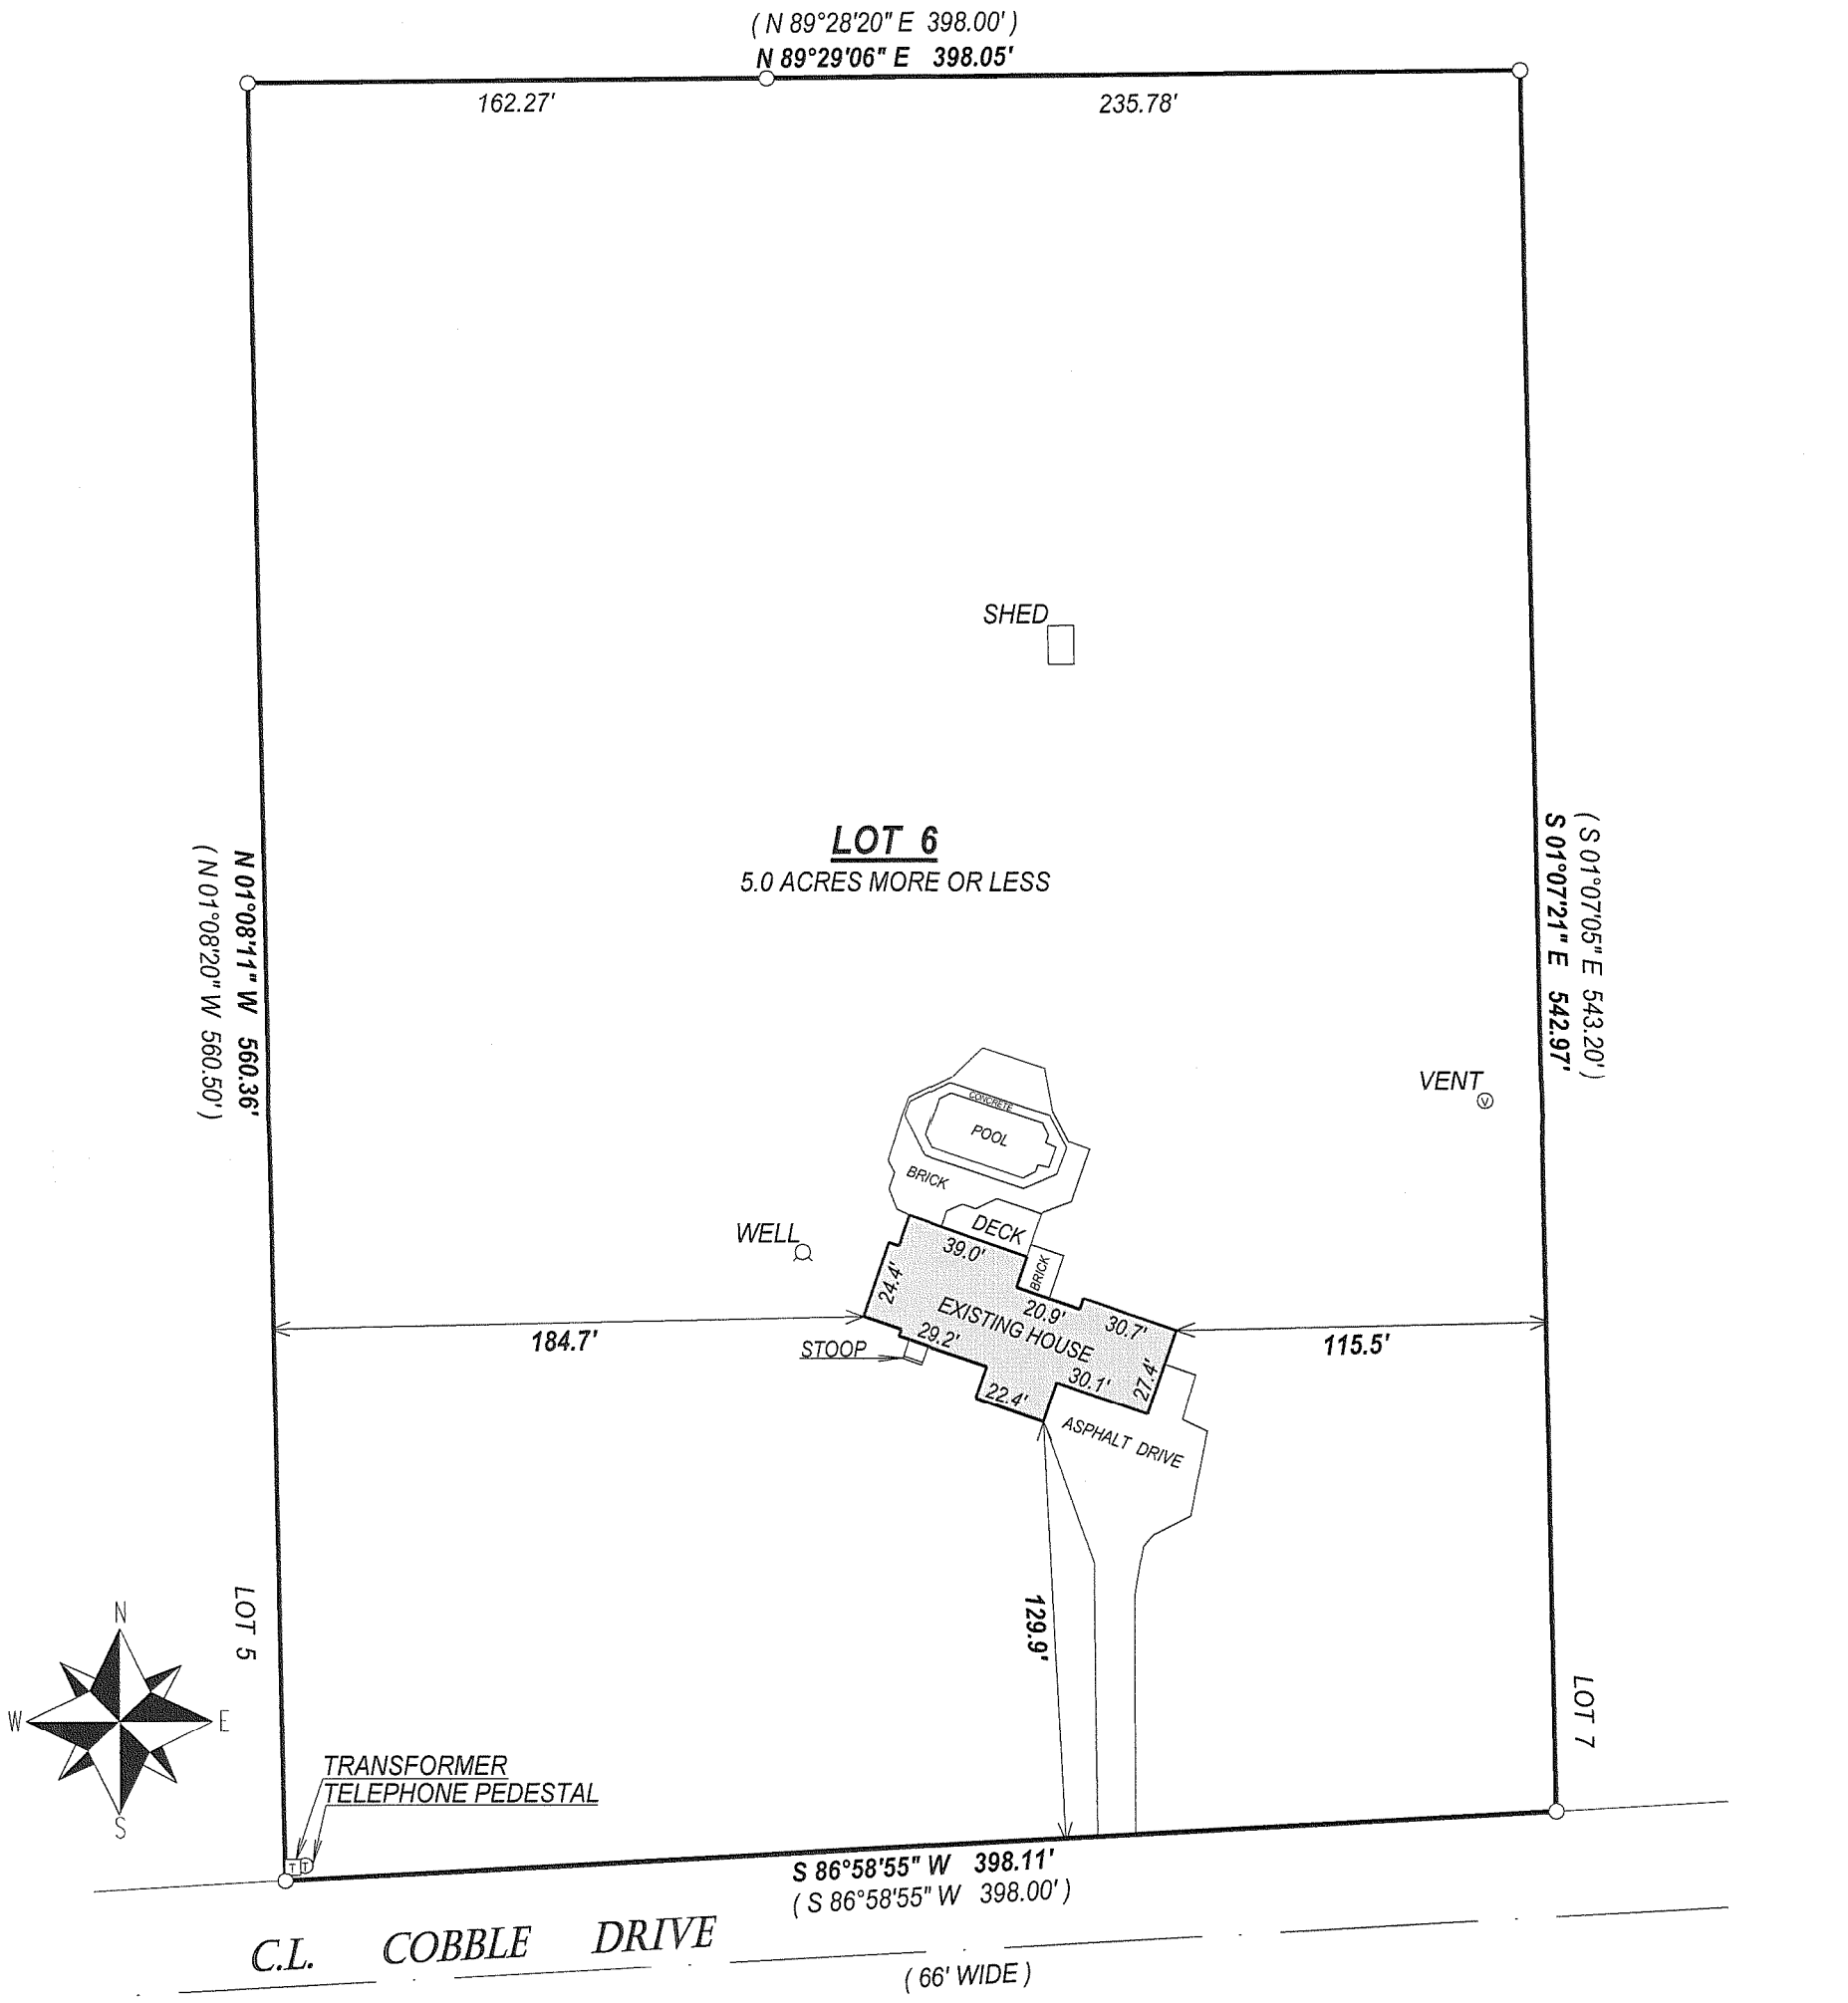

( )= recorded as

□ = found iron bar

○ = found iron pipe

● = set iron pipe

■ = set iron bar

SCALE 1" = 60'

JOB # 07-191

TAX ID # NMH00006

RECEIVED
MAY 30 2007
SMF

COMPARE LEGAL DESCRIPTION ABOVE AND DRAWING WITH DEED. FOR BUILDING RESTRICTIONS AND EASEMENTS NOT SHOWN,REFER TO DEED, ABSTRACT SOURCES AND LOCAL MUNICIPAL CODES. NOTIFY THE SURVEYOR IMMEDIATELY OF ANY DISCREPANCY.

"I hereby certify that I have surveyed the above described property and that the above map, to the best of my knowledge and belief, is a true representation thereof and shows the size and location of all visible structures, apparent easements and encroachmentsif any."
This survey is made for the present owners of the property, and those who purchase, mortgage, or guarentee the title thereto, within one year from the date hereof.

WISCONSIN
JOHN P.
KROTT
S-2258
LAKE GENEVA
WIS.
LAND SURVEYOR

JOHN KROTT S - 2258
Wisconsin Registered Land Surveyor
(original if signed in red)
DATED THIS THE 16th DAY OF MAY 2007.

218 - 1647