PLAT OF SURVEY

–OF–

LOT 18, LYONS HILLSIDE SUBDIVISION, A SUBDIVISION LOCATED IN PART OF THE NORTHWEST 1/4 OF THE SOUTHEAST 1/4 OF SECTION 10, TOWNSHIP 2 NORTH, RANGE 18 EAST, IN THE TOWN OF LYONS, COUNTY OF WALWORTH AND STATE OF WISCONSIN.

SURVEY FOR: STEPHEN CESARZ
SURVEY LOCATION: 5904 CHRISTINE COURT

RECEIVED
SEP 5 2003
DEP

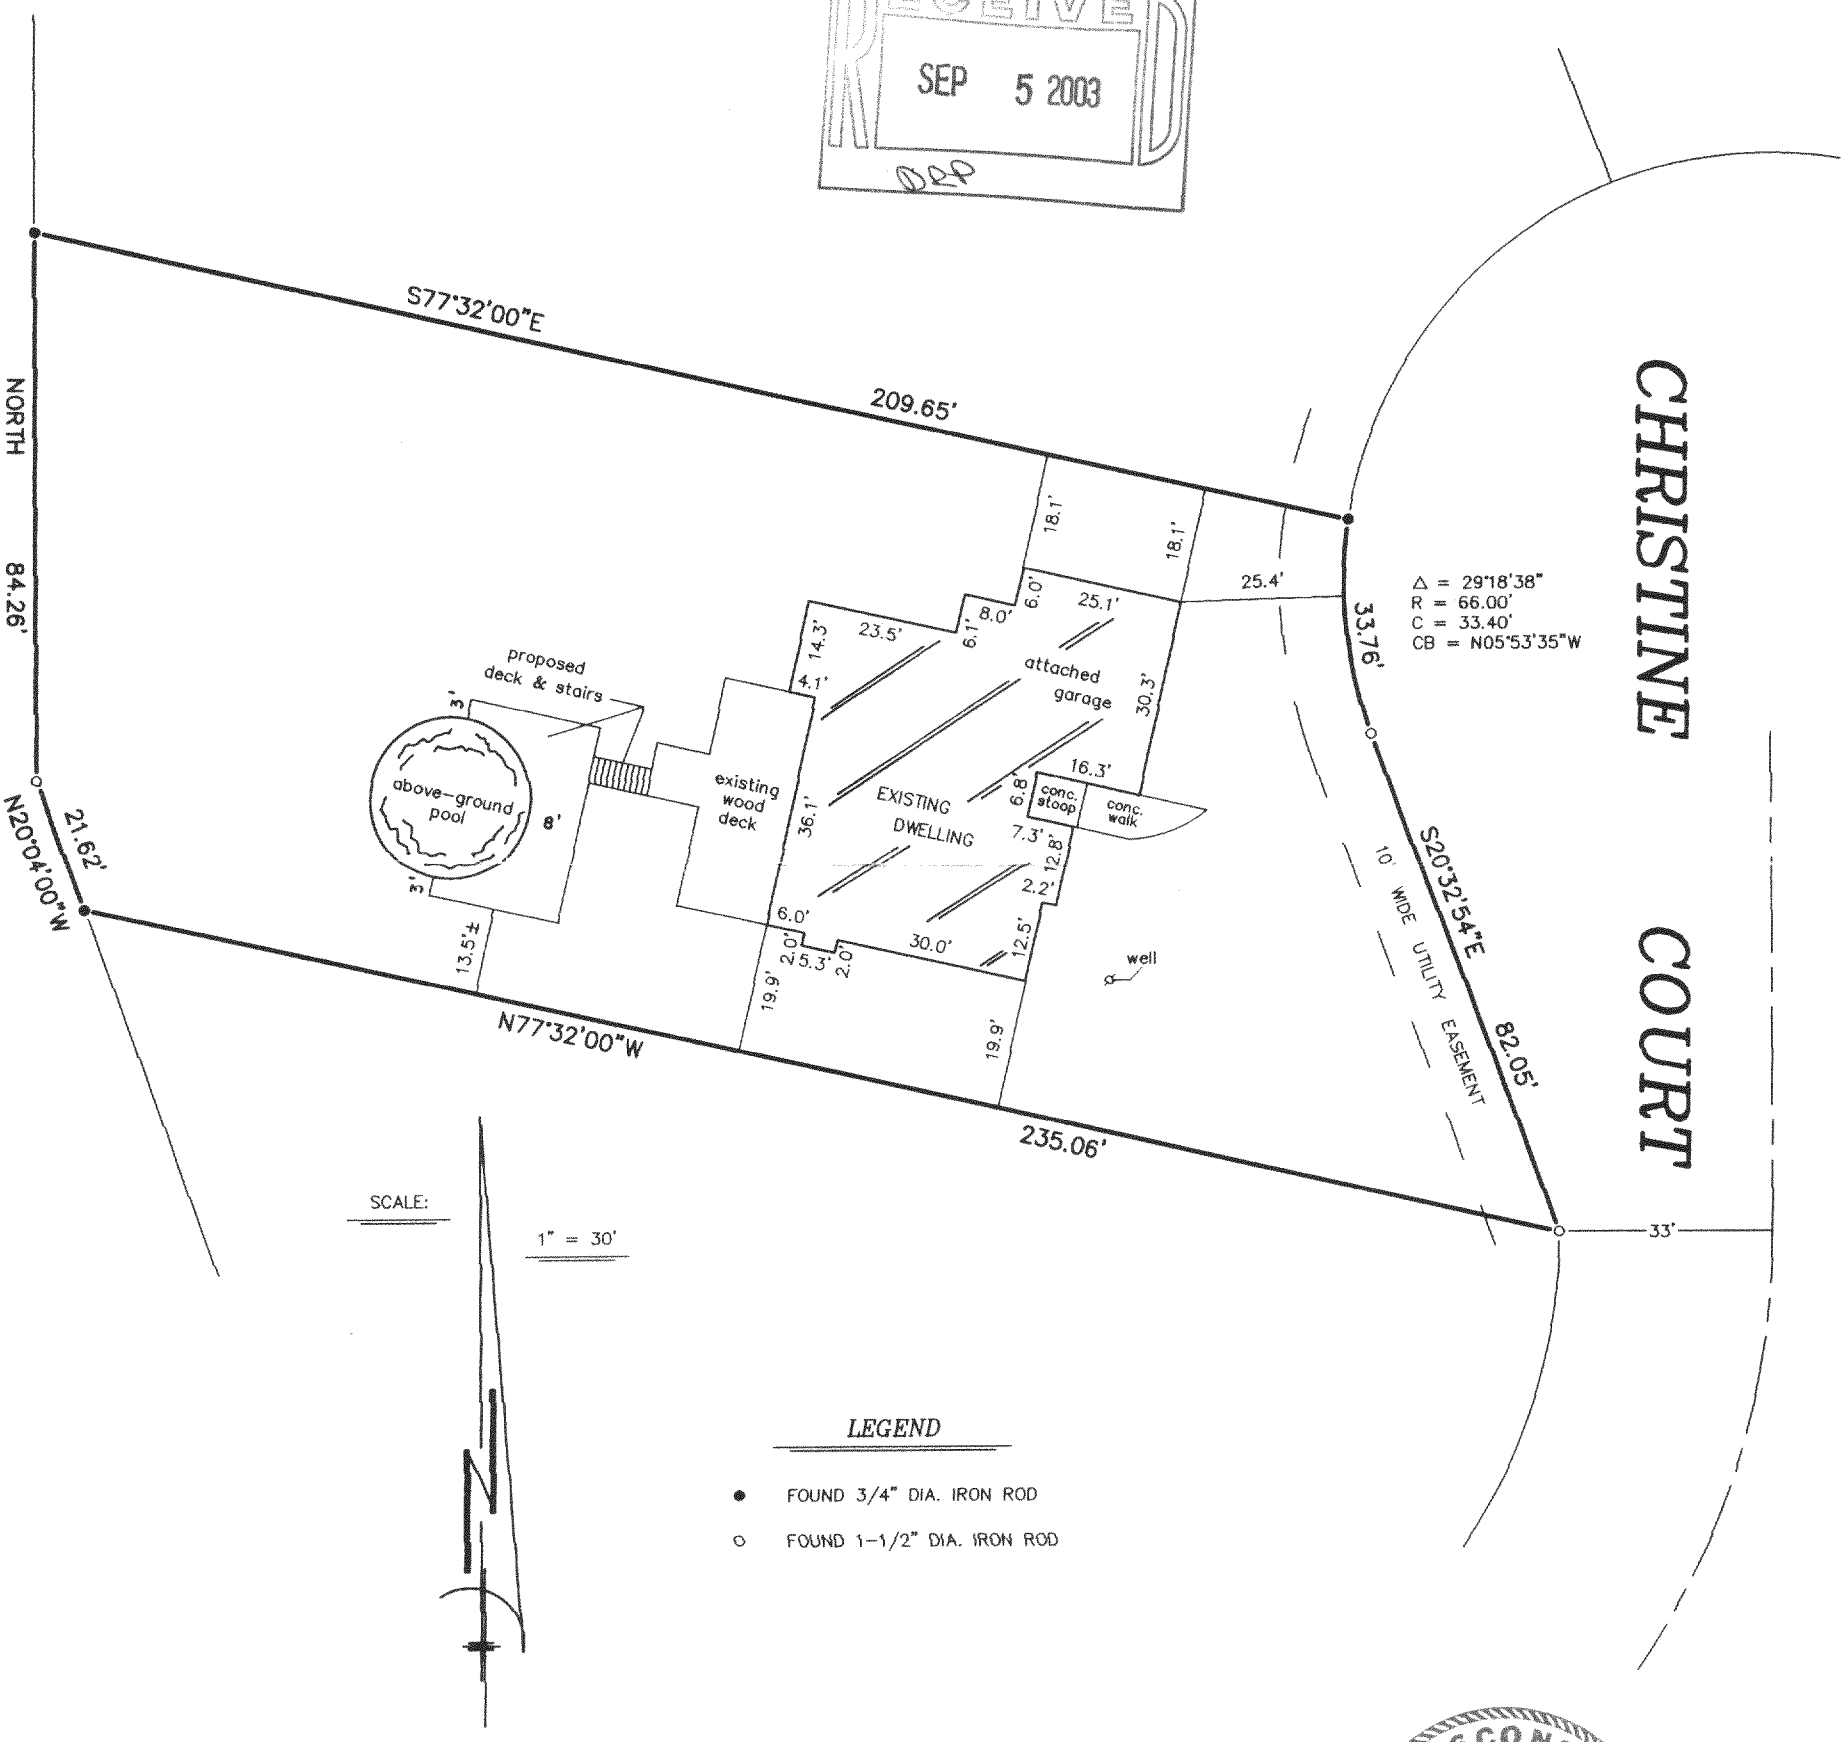

LEGEND

- ● FOUND 3/4" DIA. IRON ROD
- ○ FOUND 1–1/2" DIA. IRON ROD

"I hereby certify that I have surveyed the above described property and that the above map is a correct representation thereof and shows the size and location of the property, its exterior boundaries, the location of all visible structures and dimensions of all principal buildings thereon, boundary fences, apparent easements, roadways and encroachments, if any."

"This survey is made for the use of the present owners of the property, and those who purchase, mortgage, or guarantee the title thereto within one year from date hereof."

WISCONSIN
ROBERT J. WETZEL
S-1778
BURLINGTON WIS.
LAND SURVEYOR

THIS IS NOT AN ORIGINAL PRINT UNLESS THIS SEAL IS RED.

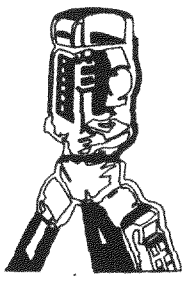

B.W. SURVEYING, INC.
LAND SURVEYS
MAPPING AND PLANNING
412 N. PINE STREET
BURLINGTON, WI 53105
(262)–767–0225

Robert J Wetzel
ROBERT J. WETZEL S–1778

REVISED: JUNE 10, 2003
REVISED: AUGUST 23, 2001
REVISED: JUNE 11, 2001
MAY 16, 2000
DATE

4494
JOB NUMBER

NLH-18

218-1401