#41-67

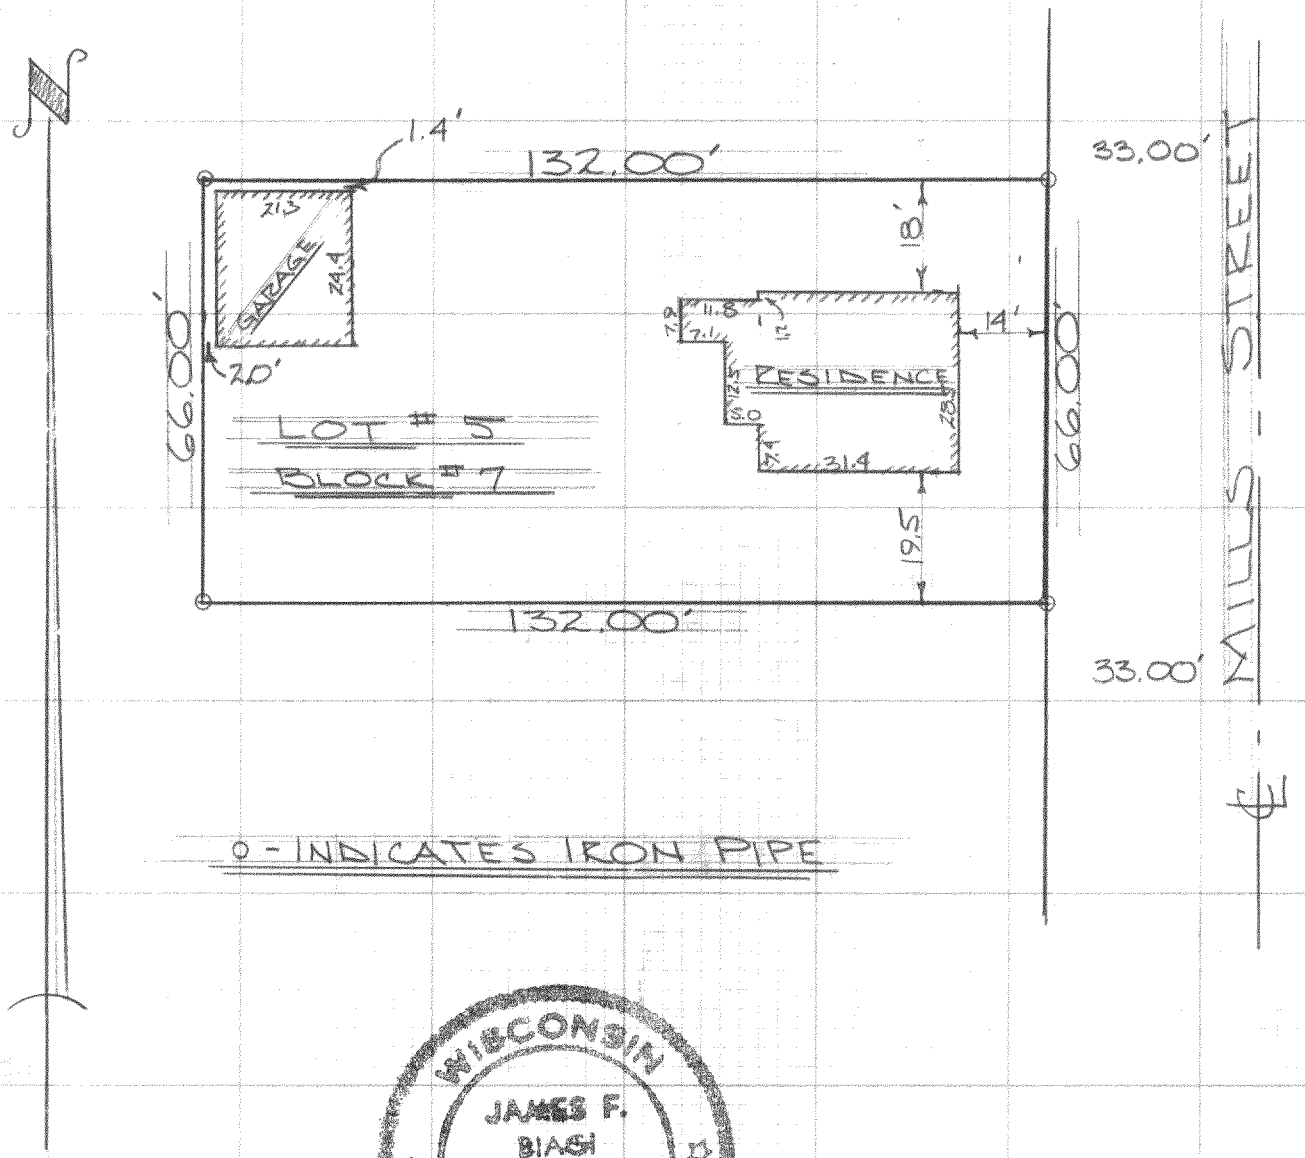

WISCONSIN
JAMES F. BIAGI
WALWORTH WIS.
LAND SURVEYOR

DESCRIPTION: Lot 5, Block 7, Burk and Campbell's Subdivision, being in the Village of Lyons, Walworth County, Wisconsin.

CERTIFICATE: I hereby certify that I have surveyed the above mentioned property and that the hereon portrayed is an accurate survey and a true representation thereof and correctly shows the exterior boundary lines and the location of the buildings and the other improvements thereof.

March 31, 1967

James F. Biagi

James F. Biagi, RLS 272

218-89B