


# Plat of Survey

of  
**Lot 1 of Certified Survey Map No. 560,**

recorded in Vol. 3 of Certified Survey Maps of Walworth County on Page 3 and located in the Northwest 1/4 of Section 15, Town 3 North, Range 15 East, Town of Richmond, Walworth County, Wisconsin.

Surveyed for: **David Lundberg**  
 W8487 County Road A  
 Delavan, Wisconsin. 53115



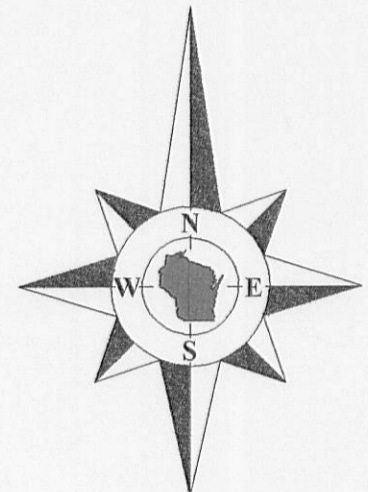


Bearings reference to Certified Survey Map No. 560.

## Legal Description of Proposed Lot Line Adjustment Walworth County to David Lundberg

A parcel of land located in the Northeast 1/4 of Section 16, Town 3 North, Range 15 East, Town of Richmond, Walworth County, Wisconsin, described as follows: Commence at the East 1/4 Corner of said Section 16; thence North 3°13'12" West, along the East line of the Northeast 1/4 of said Section 16, 796.09 feet to the Southwest corner of Lot 1 of Certified Survey Map No. 560 and the Point of Beginning; thence South 87°05'36" West, on the Westerly extension of the South line of said Lot 1, 34.55 feet; thence North 27°38'42" West, 38.44 feet; thence North 78°06'36" East, 51.03 feet to a point on the East line of said Northeast 1/4 of Section 16; thence South 3°13'12" East, along said East line, 42.82 feet to the Point of Beginning.

Said parcel contains 0.039 acre (1,684 sq.ft.) of land, more or less.

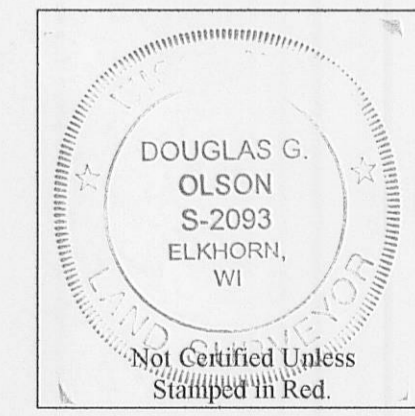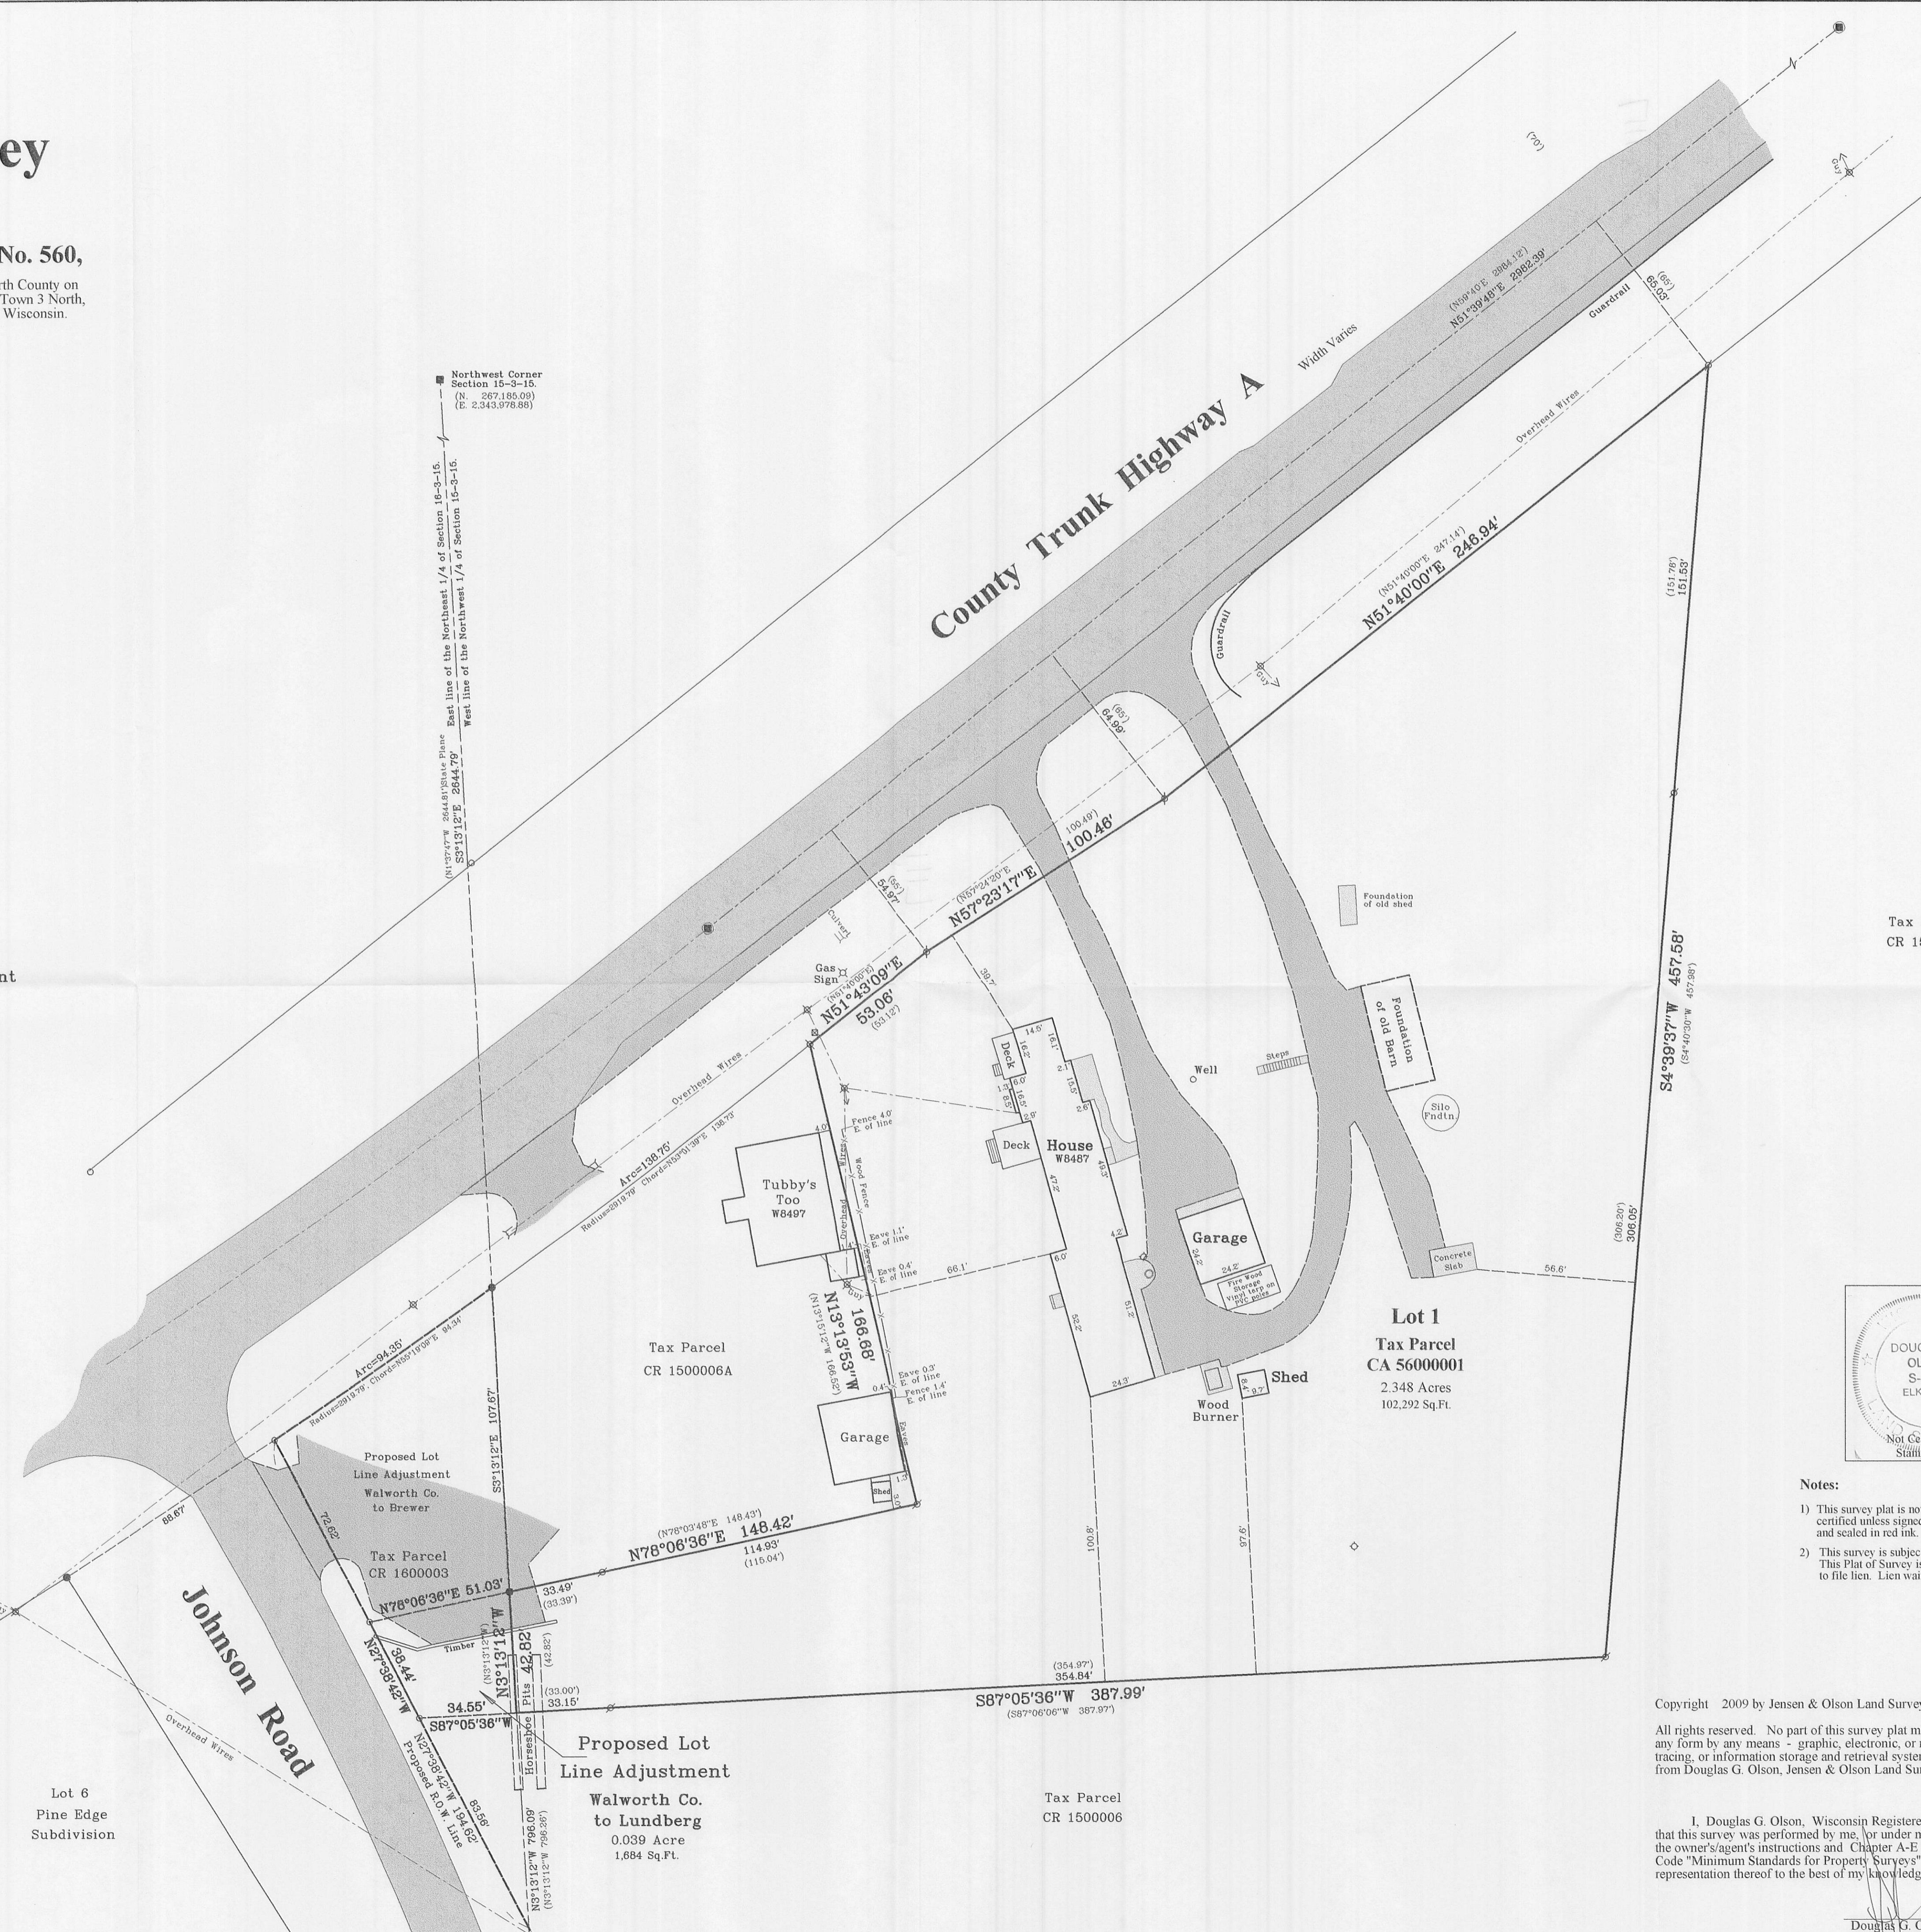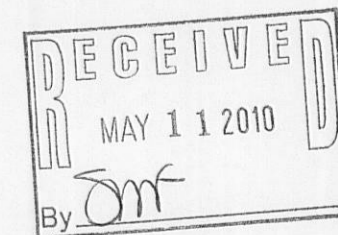

- Notes:**
- 1) This survey plat is not certified unless signed and sealed in red ink.
  - 2) This survey is subject to Wisconsin lien laws. This Plat of Survey is the notice of intent to file lien. Lien waiver required.


Copyright 2009 by Jensen & Olson Land Surveying, LLC.

All rights reserved. No part of this survey plat may be reproduced or transmitted in any form by any means - graphic, electronic, or mechanical, including photocopying, tracing, or information storage and retrieval systems - without permission in writing from Douglas G. Olson, Jensen & Olson Land Surveying, LLC.

I, Douglas G. Olson, Wisconsin Registered Land Surveyor, do hereby certify that this survey was performed by me, or under my direction in full compliance with the owner's/agent's instructions and Chapter A-E-7 of the Wisconsin Administrative Code "Minimum Standards for Property Surveys", and that this map is an accurate representation thereof to the best of my knowledge and belief.

Douglas G. Olson  
 Wisconsin Registered Land Surveyor - 2093

Survey date: November 16, 2009.  
 REVISIONS: No. 1 - Proposed Lot Line Adjustment.

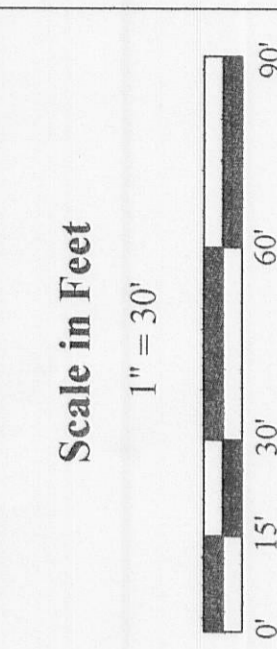

**Jensen & Olson Land Surveying, LLC**  
 45 South Wisconsin Street \* P.O. Box 372 \* Elkhorn, Wisconsin. 53121  
 Telephone: (262) 723-3434 \* Facsimile: (262) 723-8044  
 Email: jensen.olson@elknet.net

- Legend**
- Found County Section Corner
  - Found Concrete Highway Monument
  - Found Iron Pipe
  - Found Iron Bolt
  - Metal R.O.W. Post
  - Recorded Information
  - Utility Pedestal
  - Asphalt Surface
  - Gravel Surface
  - Concrete Surface
  - Utility Pole
  - Manhole

Sheet 1 of 1 Sheets  
 Job Reference Number  
**2009,095**

CA 4281-1 CA 4280-1

315-1117