Plat of Survey

of

Lot 3 of Certified Survey Map No. 2648,

recorded in Vol. 13 of Certified Survey Maps of Walworth County on Page 216 and located in Government Lot 7 in the Southeast 1/4 of Section 9, Town 3 North, Range 15 East, Town of Richmond, Walworth County, Wisconsin.

Surveyed for: **Daniel & Rachel DePorter**
N6651 Lake Lorraine Road
Delavan, Wisconsin. 53115

Bearings referenced to the Northwesterly line of Lot 3, recorded as N59°28'03"E on Certified Survey Map No. 2648.

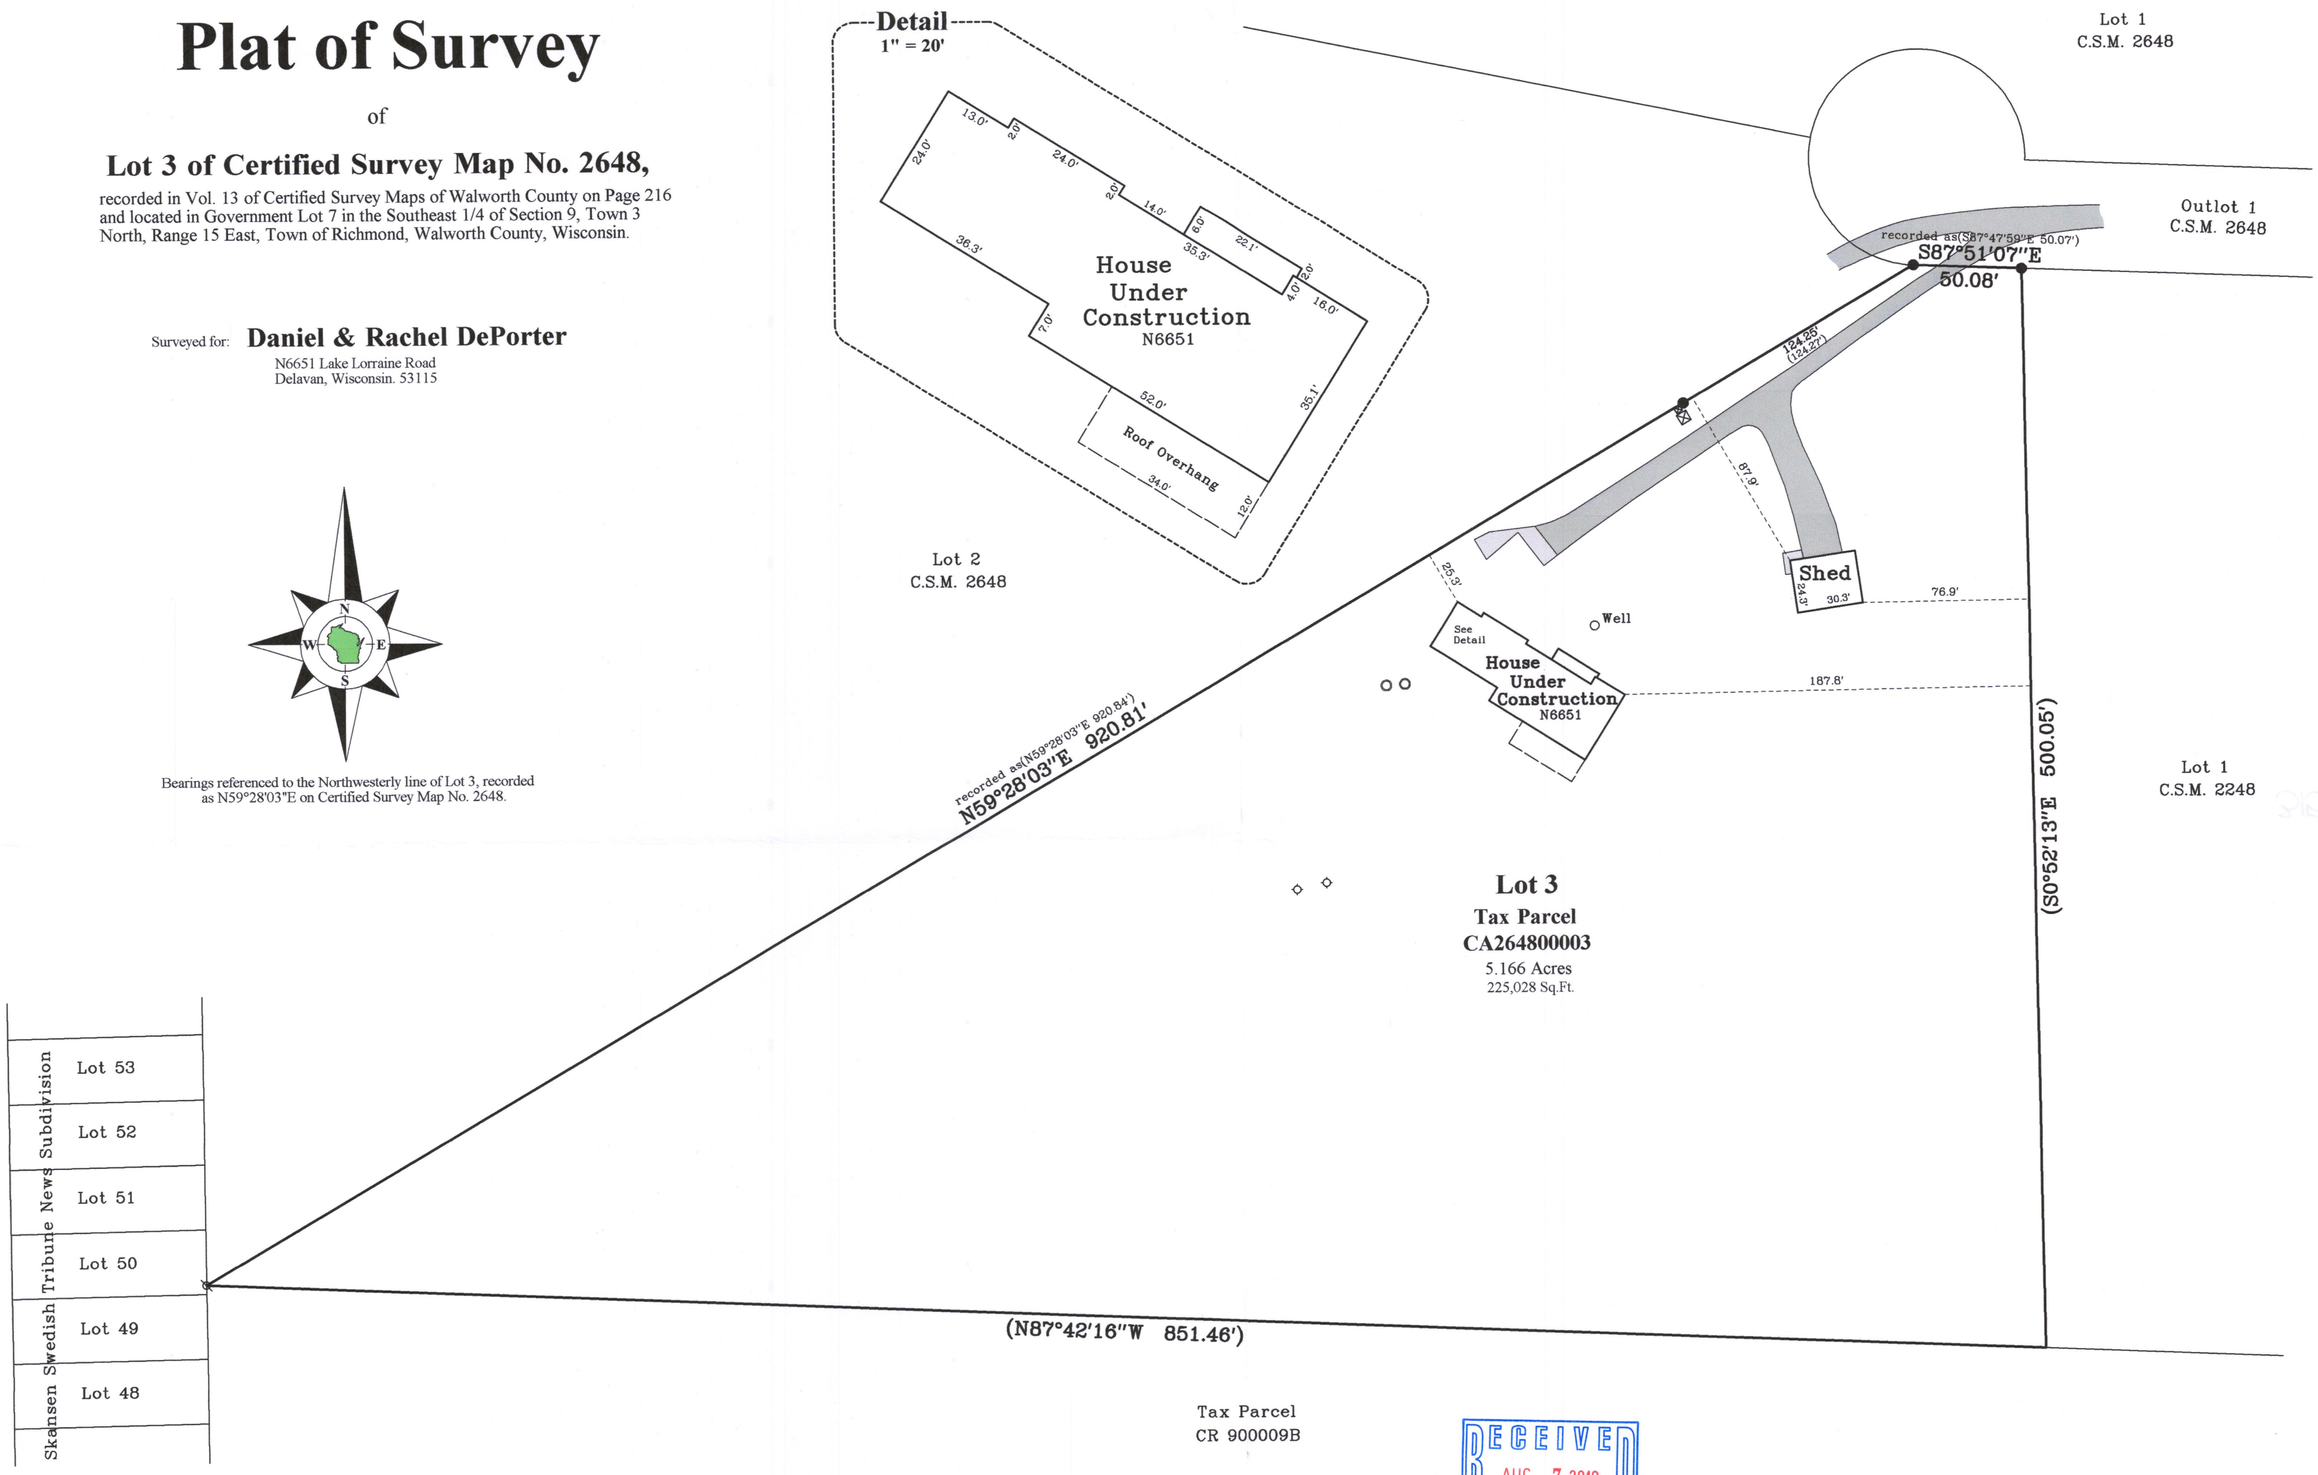

RECEIVED
AUG 7 2019
By SMF

Not Certified Unless Stamped in Red.

Notes:

1) This Plat of Survey is not certified unless signed and sealed in red ink.
2) This survey is subject to Wisconsin lien laws. This Plat of Survey is the notice of intent to file lien. Lien waiver required.
3) The Survey Date shown on this Plat of Survey is the completion date of the field work.

Copyright ©2019 by Olson Land Surveying, LLC.

All rights reserved. No part of this survey plat may be reproduced or transmitted in any form by any means - graphic, electronic, or mechanical, including photocopying, tracing, or information storage and retrieval systems - without permission in writing from Douglas G. Olson, Olson Land Surveying, LLC.

I hereby certify that I have surveyed the above described property in compliance with Chapter A-E 7 of the Wisconsin Administrative Code and that the map hereon is correct to the best of my professional knowledge and belief and shows the size and location of the property, its exterior boundaries, the location and dimensions of all visible structures thereon, boundary fences, apparent easements and roadways and visible encroachments, if any.

This survey is made for the exclusive use of the present owners of the property, and also those who purchase, mortgage or guarantee title thereto, within one year from the date hereof.

Douglas G. Olson
Wisconsin Professional Land Surveyor - 2093

Survey Date: February 11, 2019.
Revisions: No. 1 – Proposed House
No. 2 – House Under Construction

Scale in Feet
1" = 50'
0' 25' 50' 100' 150'

45 South Wisconsin Street | P.O. Box 322
Elkhorn, Wisconsin. 53121
Telephone: (262) 723-3434
Facsimile: (262) 723-8044
Email: doug@olsonsurveying.com
Website: www.olsonsurveying.com

OLSON
LAND SURVEYING, LLC
Rural | Residential | Commercial

Legend of Symbols & Abbreviations

- Found Iron Pipe
- Found Iron Rod
- Recorded Information
- Utility Power Pedestal
- Concrete Cover
- Septic Vent
- Asphalt Surface
- Concrete Surface

N North
S South
E East
W West
In Bearings
° Degrees
' Minutes
" Seconds
In Distances
' Feet
" Inches

Sheet 1 of 1 Sheets

Drawing Name:

Job Reference Number
2019.010

2019.010

CA264800-3

315-1355