


DUNHAM SURVEYING, S.C.
SURVEYING & SUBDIVIDING
DELAVER, WISCONSIN 53115

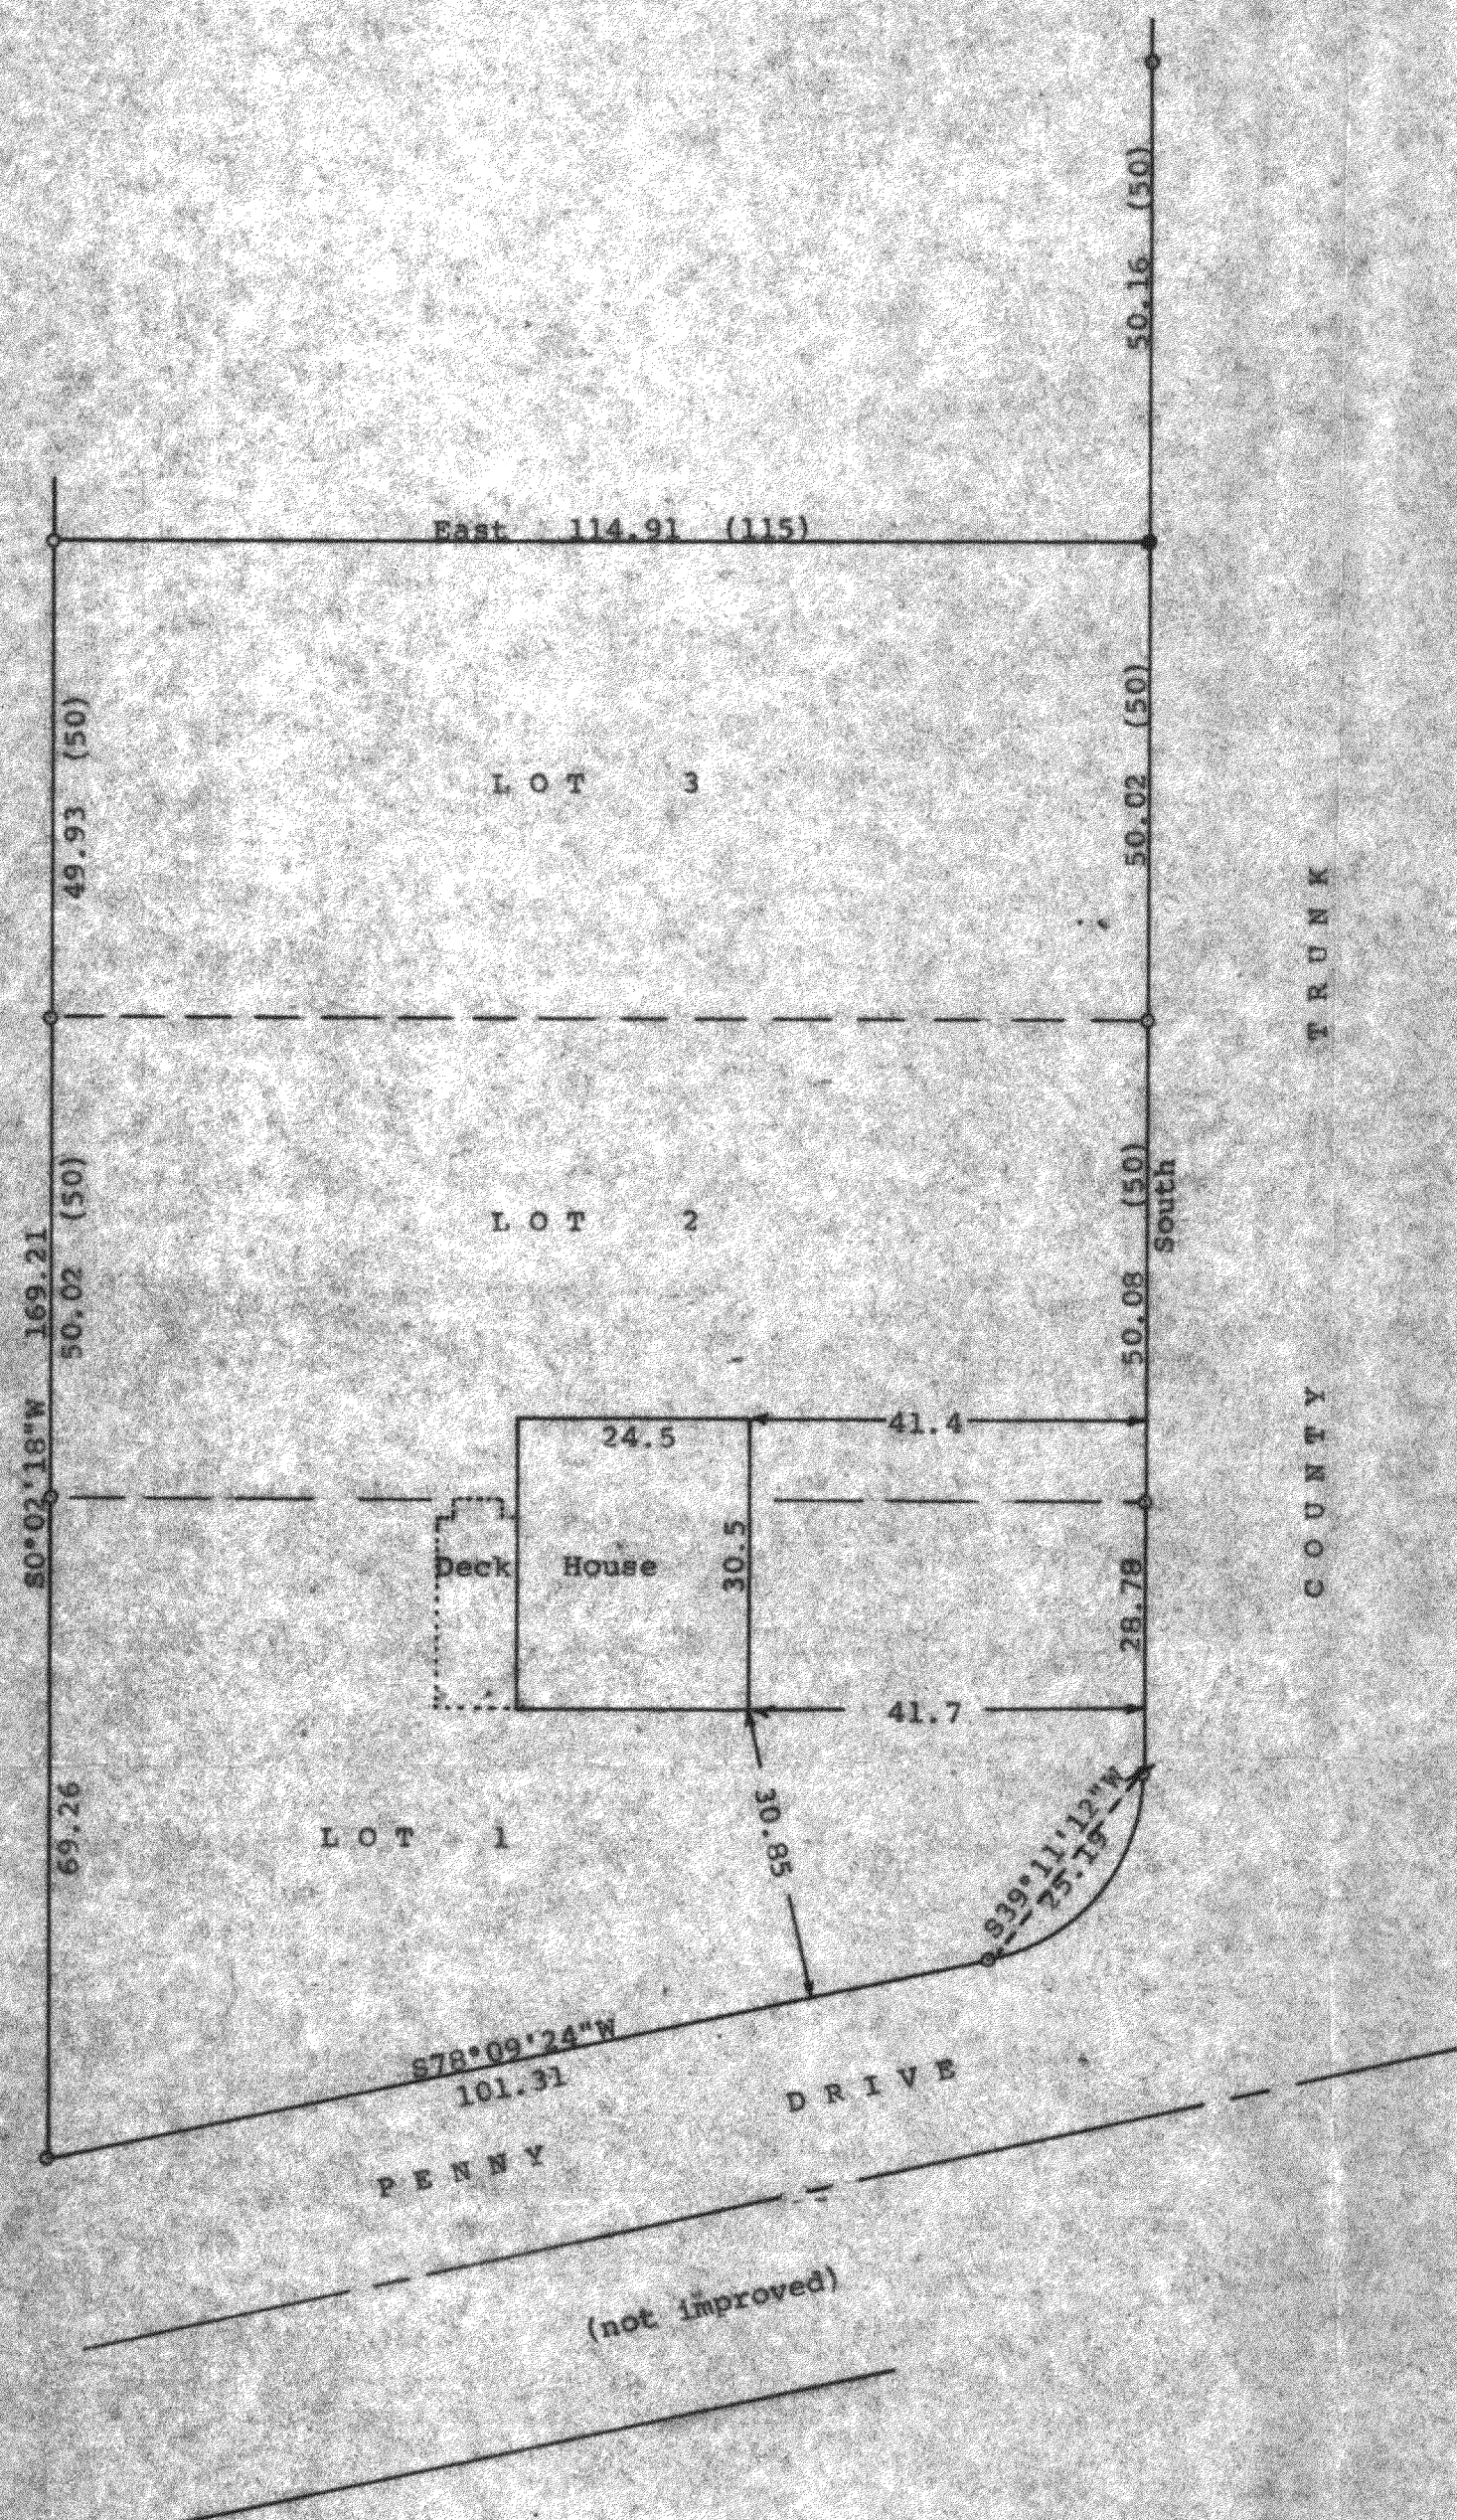

Scale - 1" = 20'

o = 1/4" Iron Rod Found

⊗ = 1/4" Bent Iron Rod Found. Reset 1" X 24" Iron Pipe

● = 1/4" Iron Rod found 26" below ground. Reset 1" X 24" Iron Pipe

(.00) = recorded distance

Bearings are referenced to the assumed bearing of South along the west line of County Trunk Highway "P"

Survey ordered by:

Realty World, Carmin Realtors

811 East Geneva Street

Delavan, WI 53115

STATE OF WISCONSIN) SS
COUNTY OF WALWORTH)

I, George T. Dunham, Surveyor, certify that I have surveyed the property described as follows:

Lots number 1, 2 and 3 in Block E of Crystal Bowl, a subdivision located in Sections 12 and 13, T 3 N, R 15 E, Walworth County, Wisconsin.

and that the plat shown hereon is a correct representation thereof and shows the size and location of the property, its exterior boundaries, the location of all visible structures and dimensions of all principal buildings thereon, boundary fences, apparent easements, roadways and visible encroachments, if any, and that I have surveyed the property hereon described, according to the official records, to the best of my knowledge and belief.

August 22, 1990

George T. Dunham
George T. Dunham, Surveyor

