ABELL
SURVEYING & MAPPING

DELAVAN, WISCONSIN 53115
414-728-6737

ORDERED BY: KEN RYER
ATR BUILDERS
N1495 RYER CT.
WALWORTH, WI 53184

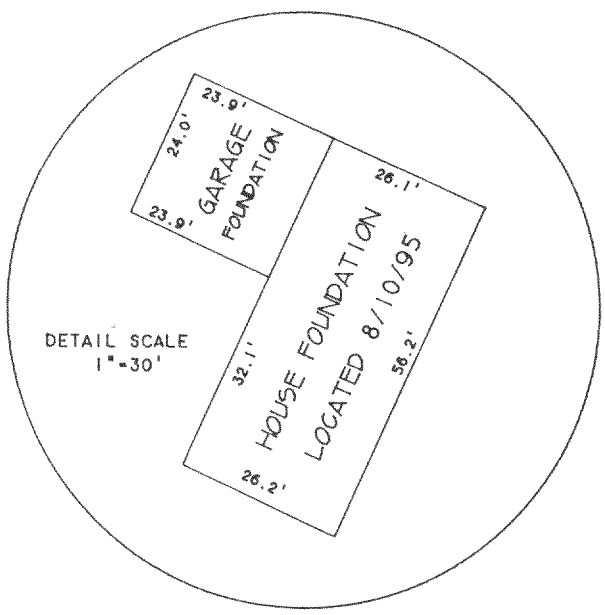

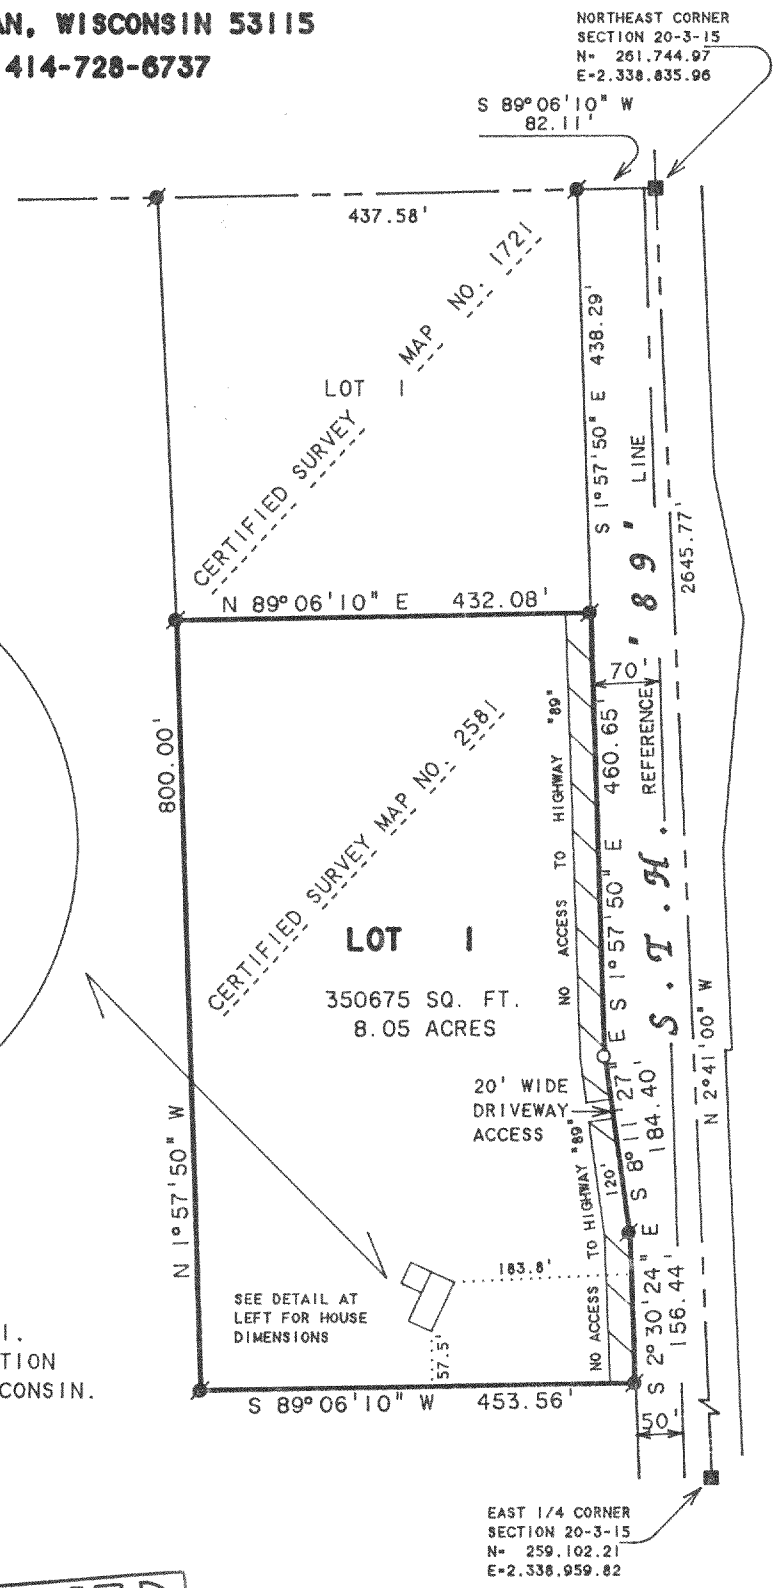

PLAT OF SURVEY OF

LOT 1, CERTIFIED SURVEY MAP NO. 2581,
LOCATED IN THE NORTHEAST 1/4 OF SECTION
20, T3N, R15E, WALWORTH COUNTY, WISCONSIN.

N

SCALE 1"=200'

LEGEND

- -IRON ROD FOUND
- -CONCRETE MONUMENT FOUND

RECEIVED
OCT 9 1995

NOTE: BEARINGS ARE REFERENCED TO
CERTIFIED SURVEY MAP NO. 2581.

I, DAVID F. ABELL, DO HEREBY CERTIFY THAT I HAVE SURVEYED THE PROPERTY HEREON DESCRIBED ACCORDING TO THE OFFICAL RECORDS AND THAT THE PLAT HEREON IS A CORRECT REPRESENTATION OF THE PROPERTY LINES TO THE BEST OF MY KNOWLEDGE AND BELIEF.

David F. Abell

DAVID F. ABELL
WISCONSIN REGISTERED LAND SURVEYOR, S-1596

August 11, 1995

DATE JOB NUMBER - 91166

NOTE: THIS IS NOT A CERTIFIED COPY UNLESS SEALED.

CA-2581-1

315-501