FARRIS, HANSEN & ASSOCIATES, INC.

ENGINEERING, ARCHITECTURE, SURVEYING

7 RIDGEWAY COURT – P.O. BOX 437, ELKHORN, WISCONSIN, 53121

PHONE: (414) 723–2098 FAX: (414) 723–5886

PLAT OF SURVEY

LOT 2 OF CERTIFIED SURVEY MAP NO. 2601
LOCATED IN THE SE 1/4 OF SEC. 11
TOWN 3 NORTH, RANGE 15 EAST
WALWORTH COUNTY, WISCONSIN

LEGEND

- O = FOUND IRON PIPE STAKE
- ● = FOUND IRON REBAR STAKE
- = SET IRON REBAR STAKE
- = POWER POLE
- (XXX) = RECORDED AS

WORK ORDERED BY: MARILYN HALOUP
N 6676 HOLIDAY DRIVE
DELAVAN, WI. 53115

100 50 0 100 200 300 400 500

MAP SCALE IN FEET ORIGINAL 1" = 80'

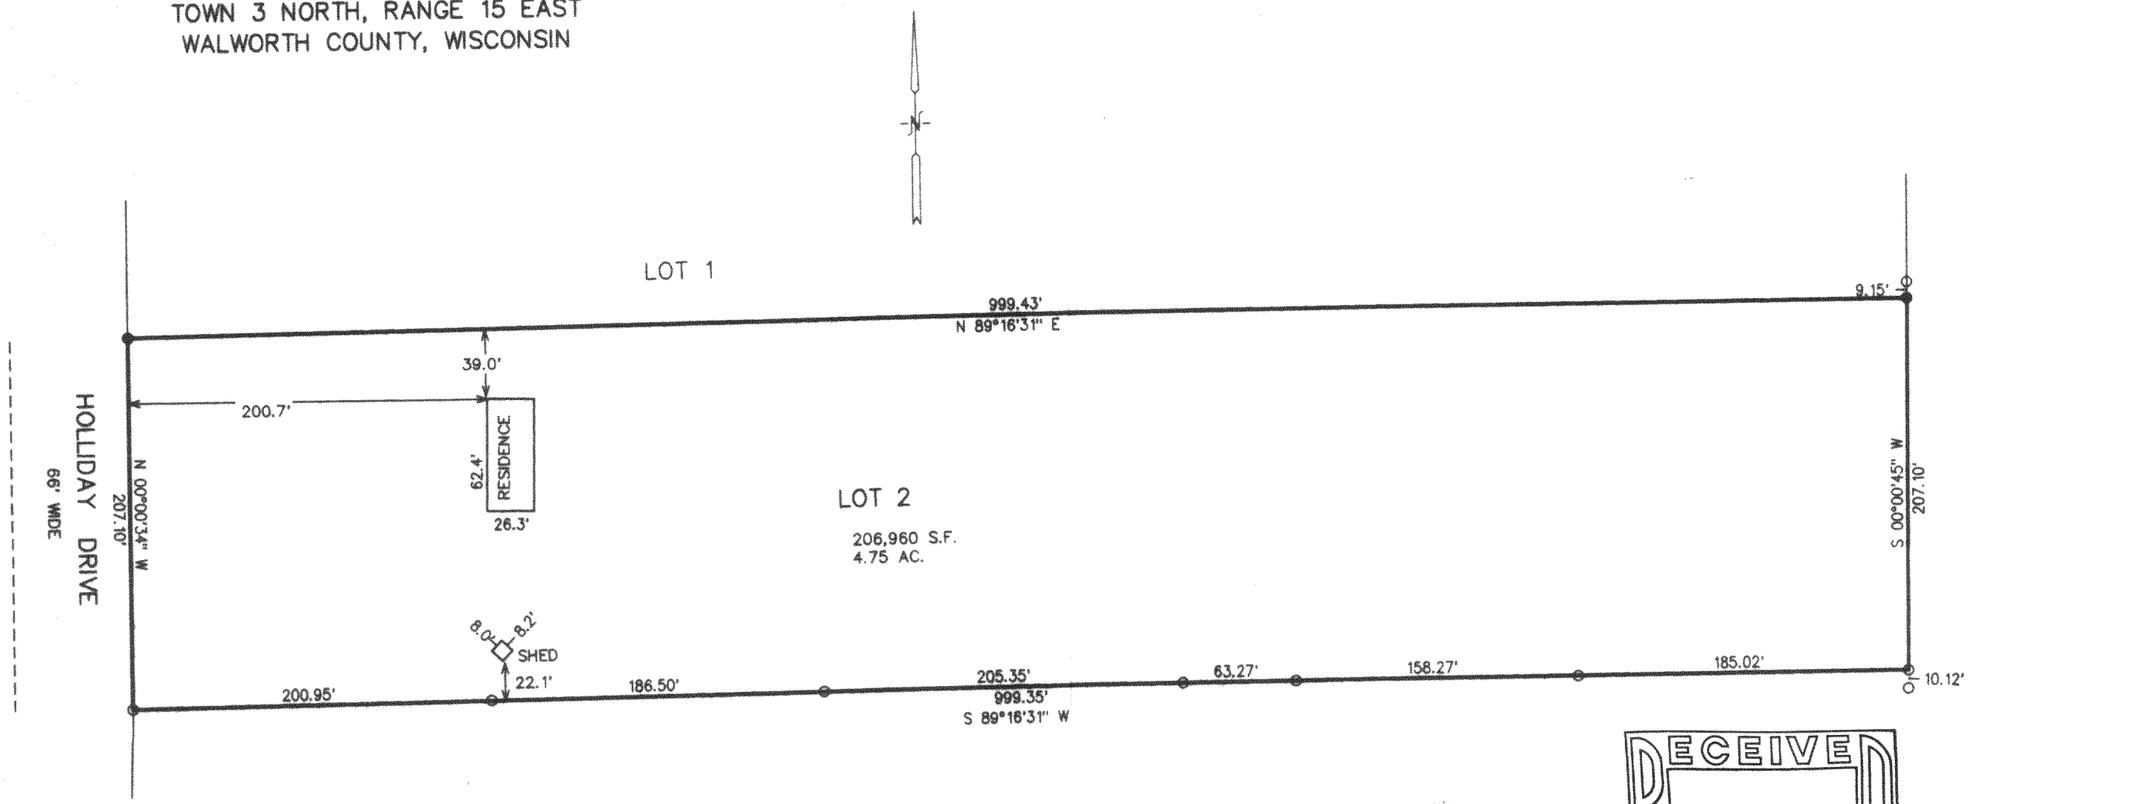

NOTE: COPIES OF THIS MAP TO WHICH THE FOLLOWING CERTIFICATE WILL APPLY ARE BLUE LINE PRINTS SHOWING SURVEYOR'S ORIGINAL SEAL AND SIGNATURE IN BLACK INK. COPIES BY ANY OTHER MEANS MAY HAVE ALTERATIONS WHICH DO NOT REPRESENT THE SURVEYOR'S WORK PRODUCT.

I HEREBY CERTIFY THAT THE ABOVE DESCRIBED PROPERTY HAS BEEN SURVEYED UNDER MY DIRECTION AND THAT THE ABOVE MAP IS A TRUE REPRESENTATION THEREOF AND SHOWS THE SIZE AND LOCATION OF THE PROPERTY AND ITS EXTERIOR BOUNDARIES. THIS SURVEY IS MADE FOR THE USE OF THE PRESENT OWNERS OF THE PROPERTY, AND ALSO THOSE WHO PURCHASE, MORTGAGE, OR GUARANTEE THE TITLE THERETO WITHIN ONE YEAR FROM THE DATE HEREOF.

DATED: 4/27/98

PETER S. GORDON R.L.S. 2101

CA-2601-2

315-619

WISCONSIN
PETER S. GORDON
S-2101
ELKHORN, WI
LAND SURVEYOR

RECEIVED
MAY 18 1998

PROJECT 4290.98

SHEET 1 OF 1