



Of

Surveyed for: **Jeffrey A. Lois**
N6779 Walnut Drive
Elkhorn, Wisconsin. 53121

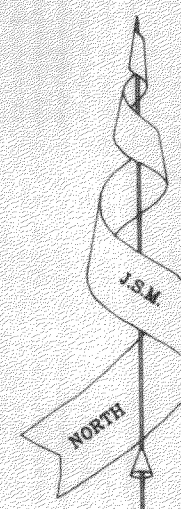

Bearings referenced to the Westerly line of Walnut Road, recorded as N 29°56'11" W on the plat of Interlaken 4th Addition.

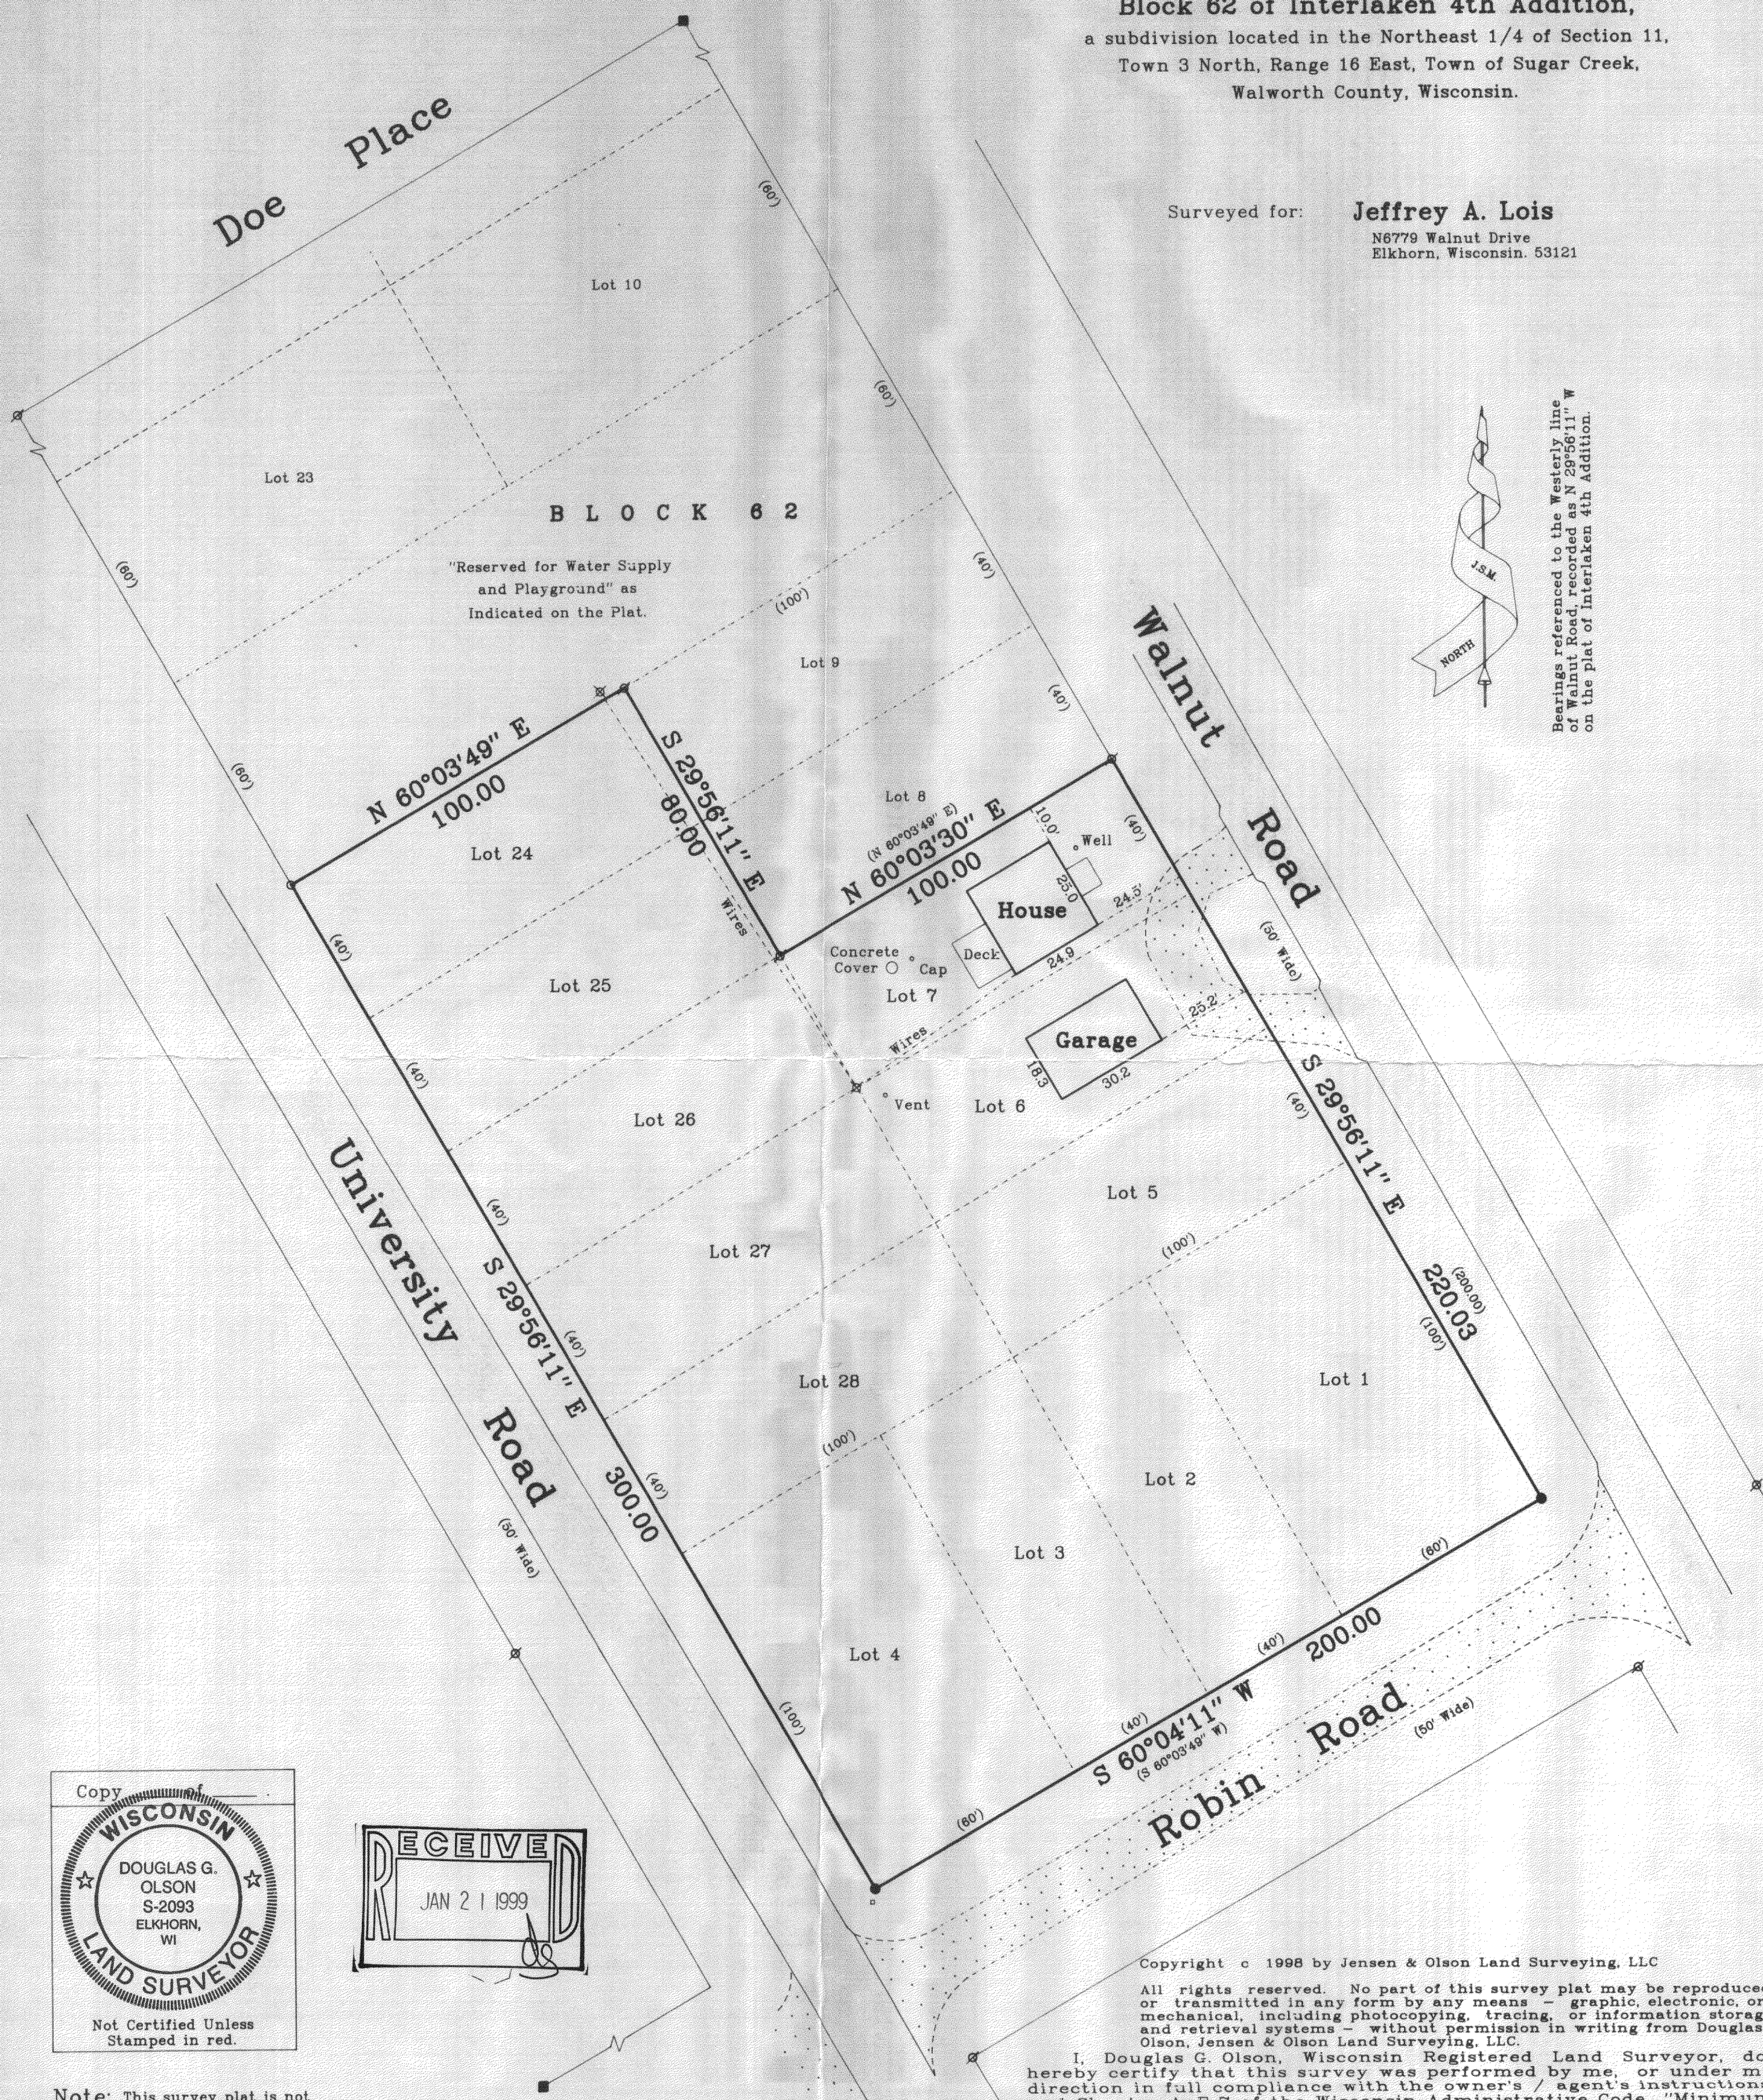

Copy _____

WISCONSIN

★

DOUGLAS G.
OLSON
S-2093
ELKHORN,
WI

★

LAND SURVEYOR

Not Certified Unless
Stamped in red.

RECEIVED
JAN 21 1999

Note: This survey plat is not certified unless signed and sealed in red ink.

Note: This survey is subject to Wisconsin lien laws.
This Plat of Survey is the notice of intent
to file lien. Lien waiver required.

Copyright c 1998 by Jensen & Olson Land Surveying, LLC

All rights reserved. No part of this survey plat may be reproduced or transmitted in any form by any means - graphic, electronic, or mechanical, including photocopying, tracing, or information storage and retrieval systems - without permission in writing from Douglas G. Olson, Jensen & Olson Land Surveying, LLC.

I, Douglas G. Olson, Wisconsin Registered Land Surveyor, do hereby certify that this survey was performed by me, or under my direction in full compliance with the owner's / agent's instructions and Chapter A-E 7 of the Wisconsin Administrative Code "Minimum Standards for Property Surveys"; and that this map is as accurate representation thereof to the best of my knowledge and belief.

Date: 8-29-98

Douglas G. Olson R.L.S. 2093

Sheet 1 of 1 Sheets.

Job Reference Number
1998.057


Legend

- Legend**
- Found Concrete Monument
 - Found Iron Pipe
 - Set Iron, 1 3/16" dia.
 - Set Iron Rod, 3/4" dia.
 - () Recorded Information
 - ⊗ Utility Pole
 - Utility Pedestal
 - Asphalt Surface
 - ⊞ Gravel Surface

Jensen & Olson Land Surveying, LLC

45 South Wisconsin Street P.O. Box 322
Elkhorn, Wisconsin. 53121
Telephone: (414) 723-3434
Facsimile: (414) 723-8044

Scale in Feet
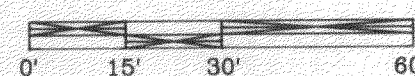
$$1'' = 30'$$


Mapping date: Aug. 29, 1998

Revisions:

1998.057

316-1095