


HAROLD H. KOLB

REGISTERED PROFESSIONAL LAND SURVEYOR
LAKE GENEVA, WISCONSIN

Note: The bearing on the South
line of C.T.H. A is
assumed as platted.


Ordered by: R.E.S.P. Corporation
114 W. Court St.
Elkhorn, Wisc.

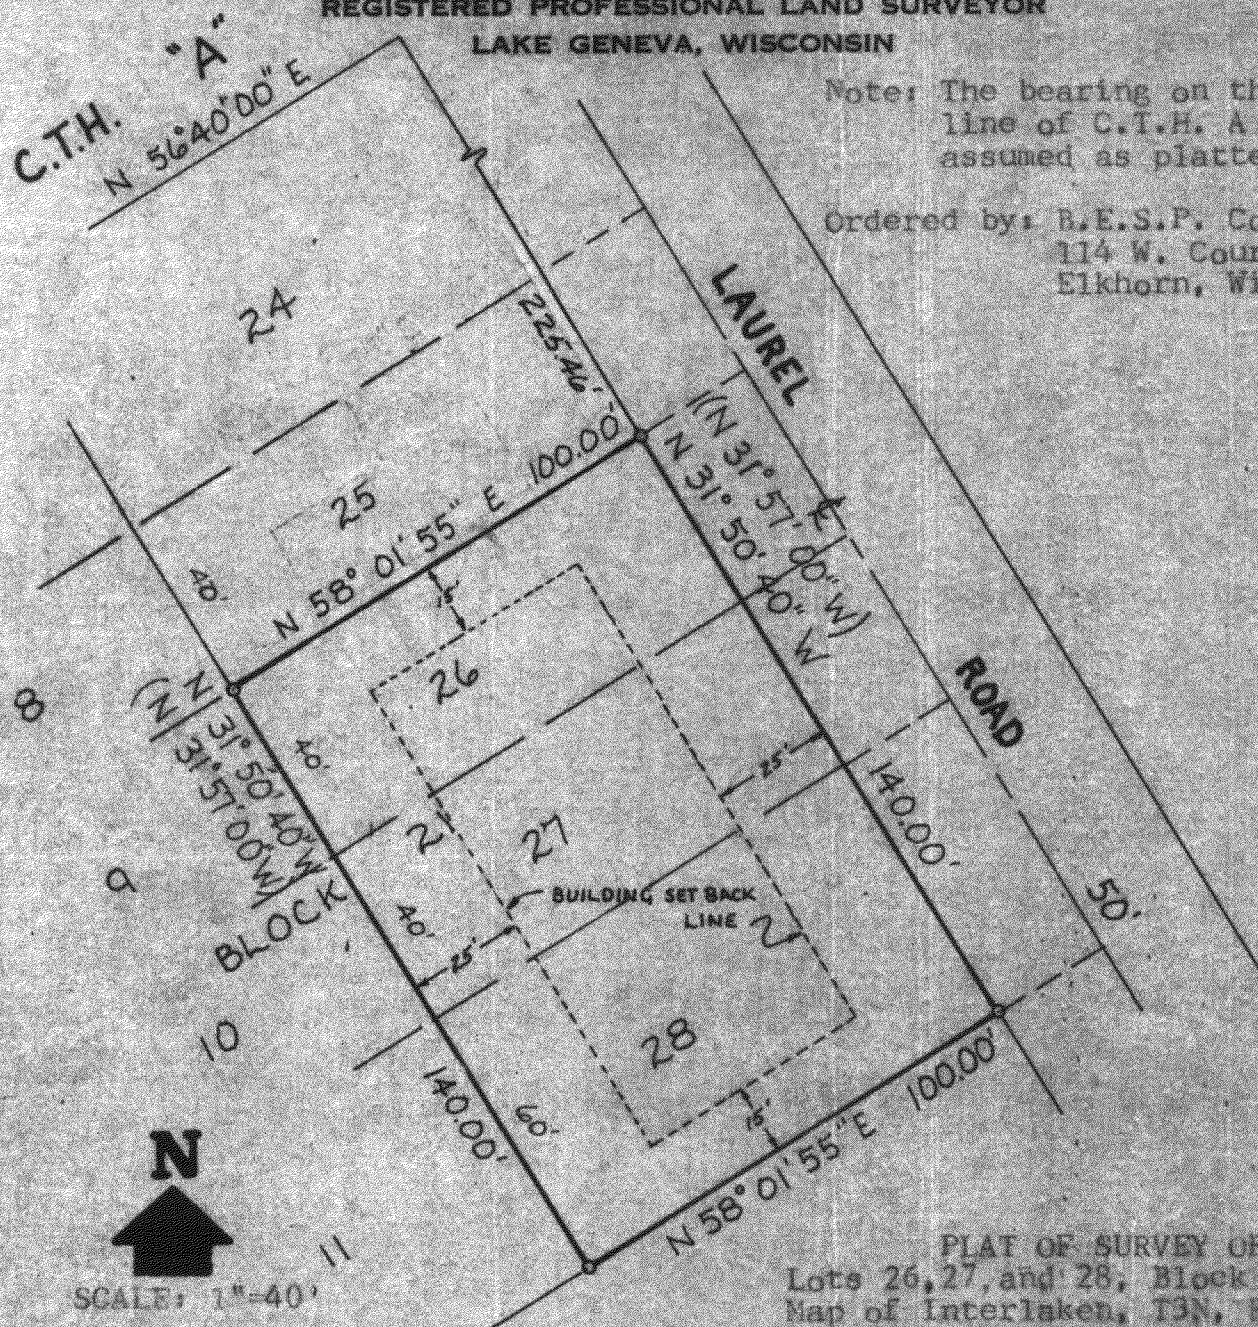

N
SCALE: 1"=40'

LEGEND

- φ - IRON PIPE FOUND
- - IRON PIPE PLACED
- - CONCRETE MONUMENT
- x - SPIKE

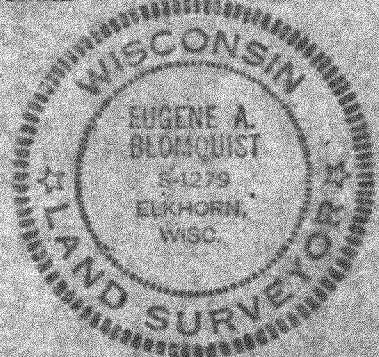

PLAT OF SURVEY OF
Lots 26, 27, and 28, Block 21, 2nd
Map of Interlaken, T3N, R10E,
Walworth County, Wisconsin.

I, EUGENE BLONQUIST DO HEREBY CERTIFY THAT I HAVE
SURVEYED THE PROPERTY HEREON DESCRIBED ACCORDING
TO THE OFFICIAL RECORDS, AND THAT THE PLAT HEREON
IS A CORRECT REPRESENTATION OF THE LOT LINES.

Eugene A. Blomquist
EUGENE A. BLONQUIST
WISCONSIN REGISTERED LAND SURVEYOR, S-1279
DATE Feb 15, 1978

GI-258 B1

316-254