


HAROLD H. KOLB

REGISTERED PROFESSIONAL LAND SURVEYOR
LAKE GENEVA, WISCONSIN

Note: The bearing on the South line of C.T.H. A is assumed as platted.

Ordered by: B.E.S.P. Corporation
114 W. Court St.
Elkhorn, Wisc.

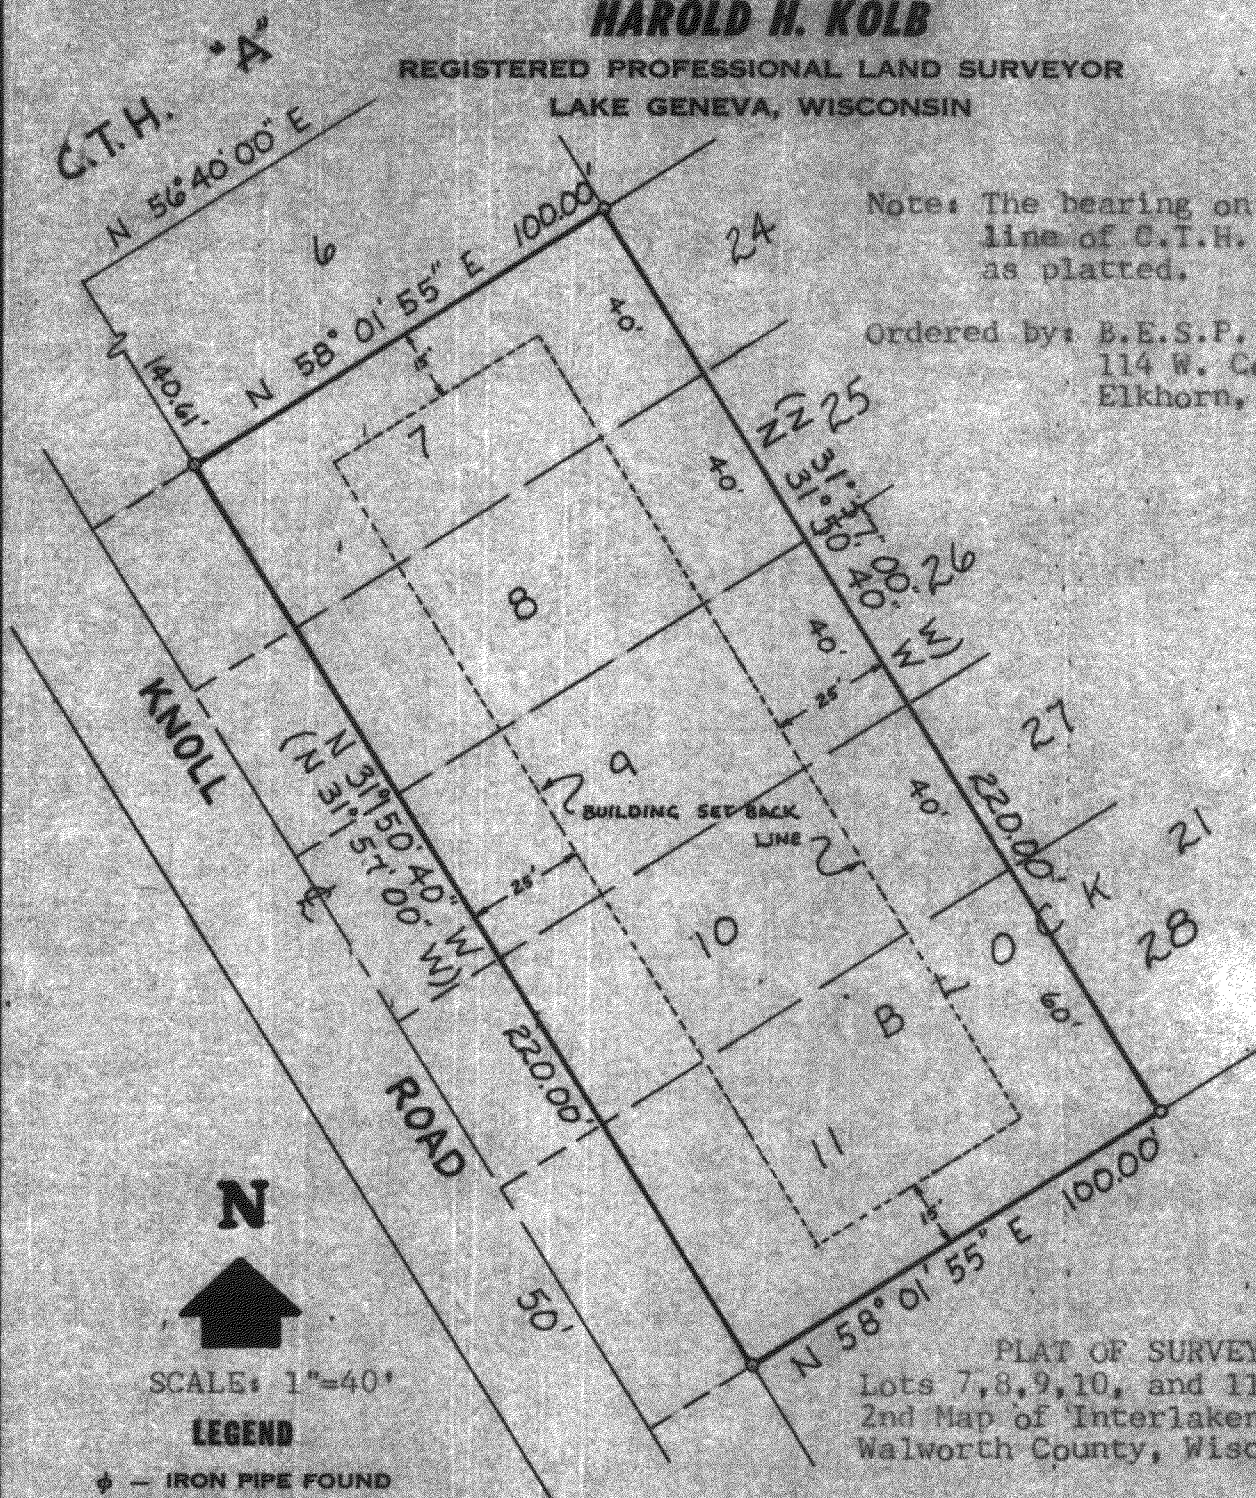


N



SCALE: 1"=40'

LEGEND

- ⊕ - IRON PIPE FOUND
- - IRON PIPE PLACED
- - CONCRETE MONUMENT
- x - SPIKE

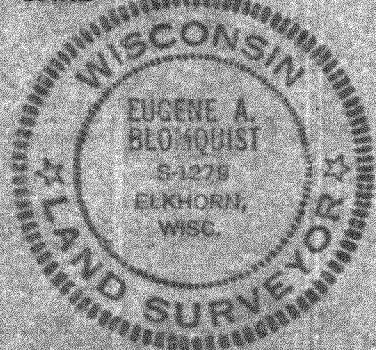

PLAT OF SURVEY OF
Lots 7, 8, 9, 10, and 11, Block 21,
2nd Map of Interlaken, T3N, R16E,
Walworth County, Wisconsin.

I, EUGENE A. BLOMQUIST DO HEREBY CERTIFY THAT I HAVE
SURVEYED THE PROPERTY HEREON DESCRIBED ACCORDING
TO THE OFFICIAL RECORDS, AND THAT THE PLAT HEREON
IS A CORRECT REPRESENTATION OF THE LOT LINES.

EUGENE A. BLOMQUIST
WISCONSIN REGISTERED LAND SURVEYOR, S-1279
DATE FEB 15, 1978

316-39