

HAROLD H. KOLB


REGISTERED PROFESSIONAL LAND SURVEYOR

LAKE GENEVA, WISCONSIN

PLAT OF SURVEY OF
The Easterly 1/2 of Lot 3, and Lots 4,
5, 23, 24, and 25, Block 21, 2nd Map
of Interlaken, T3N, R16E, Walworth
County, Wisconsin.

Ordered by: B.E.S.P. Corporation
114 W. Court St.
Elkhorn, Wisc.

Note: The bearing on the
South line of C.T.H.
"A" is assumed as
platted.

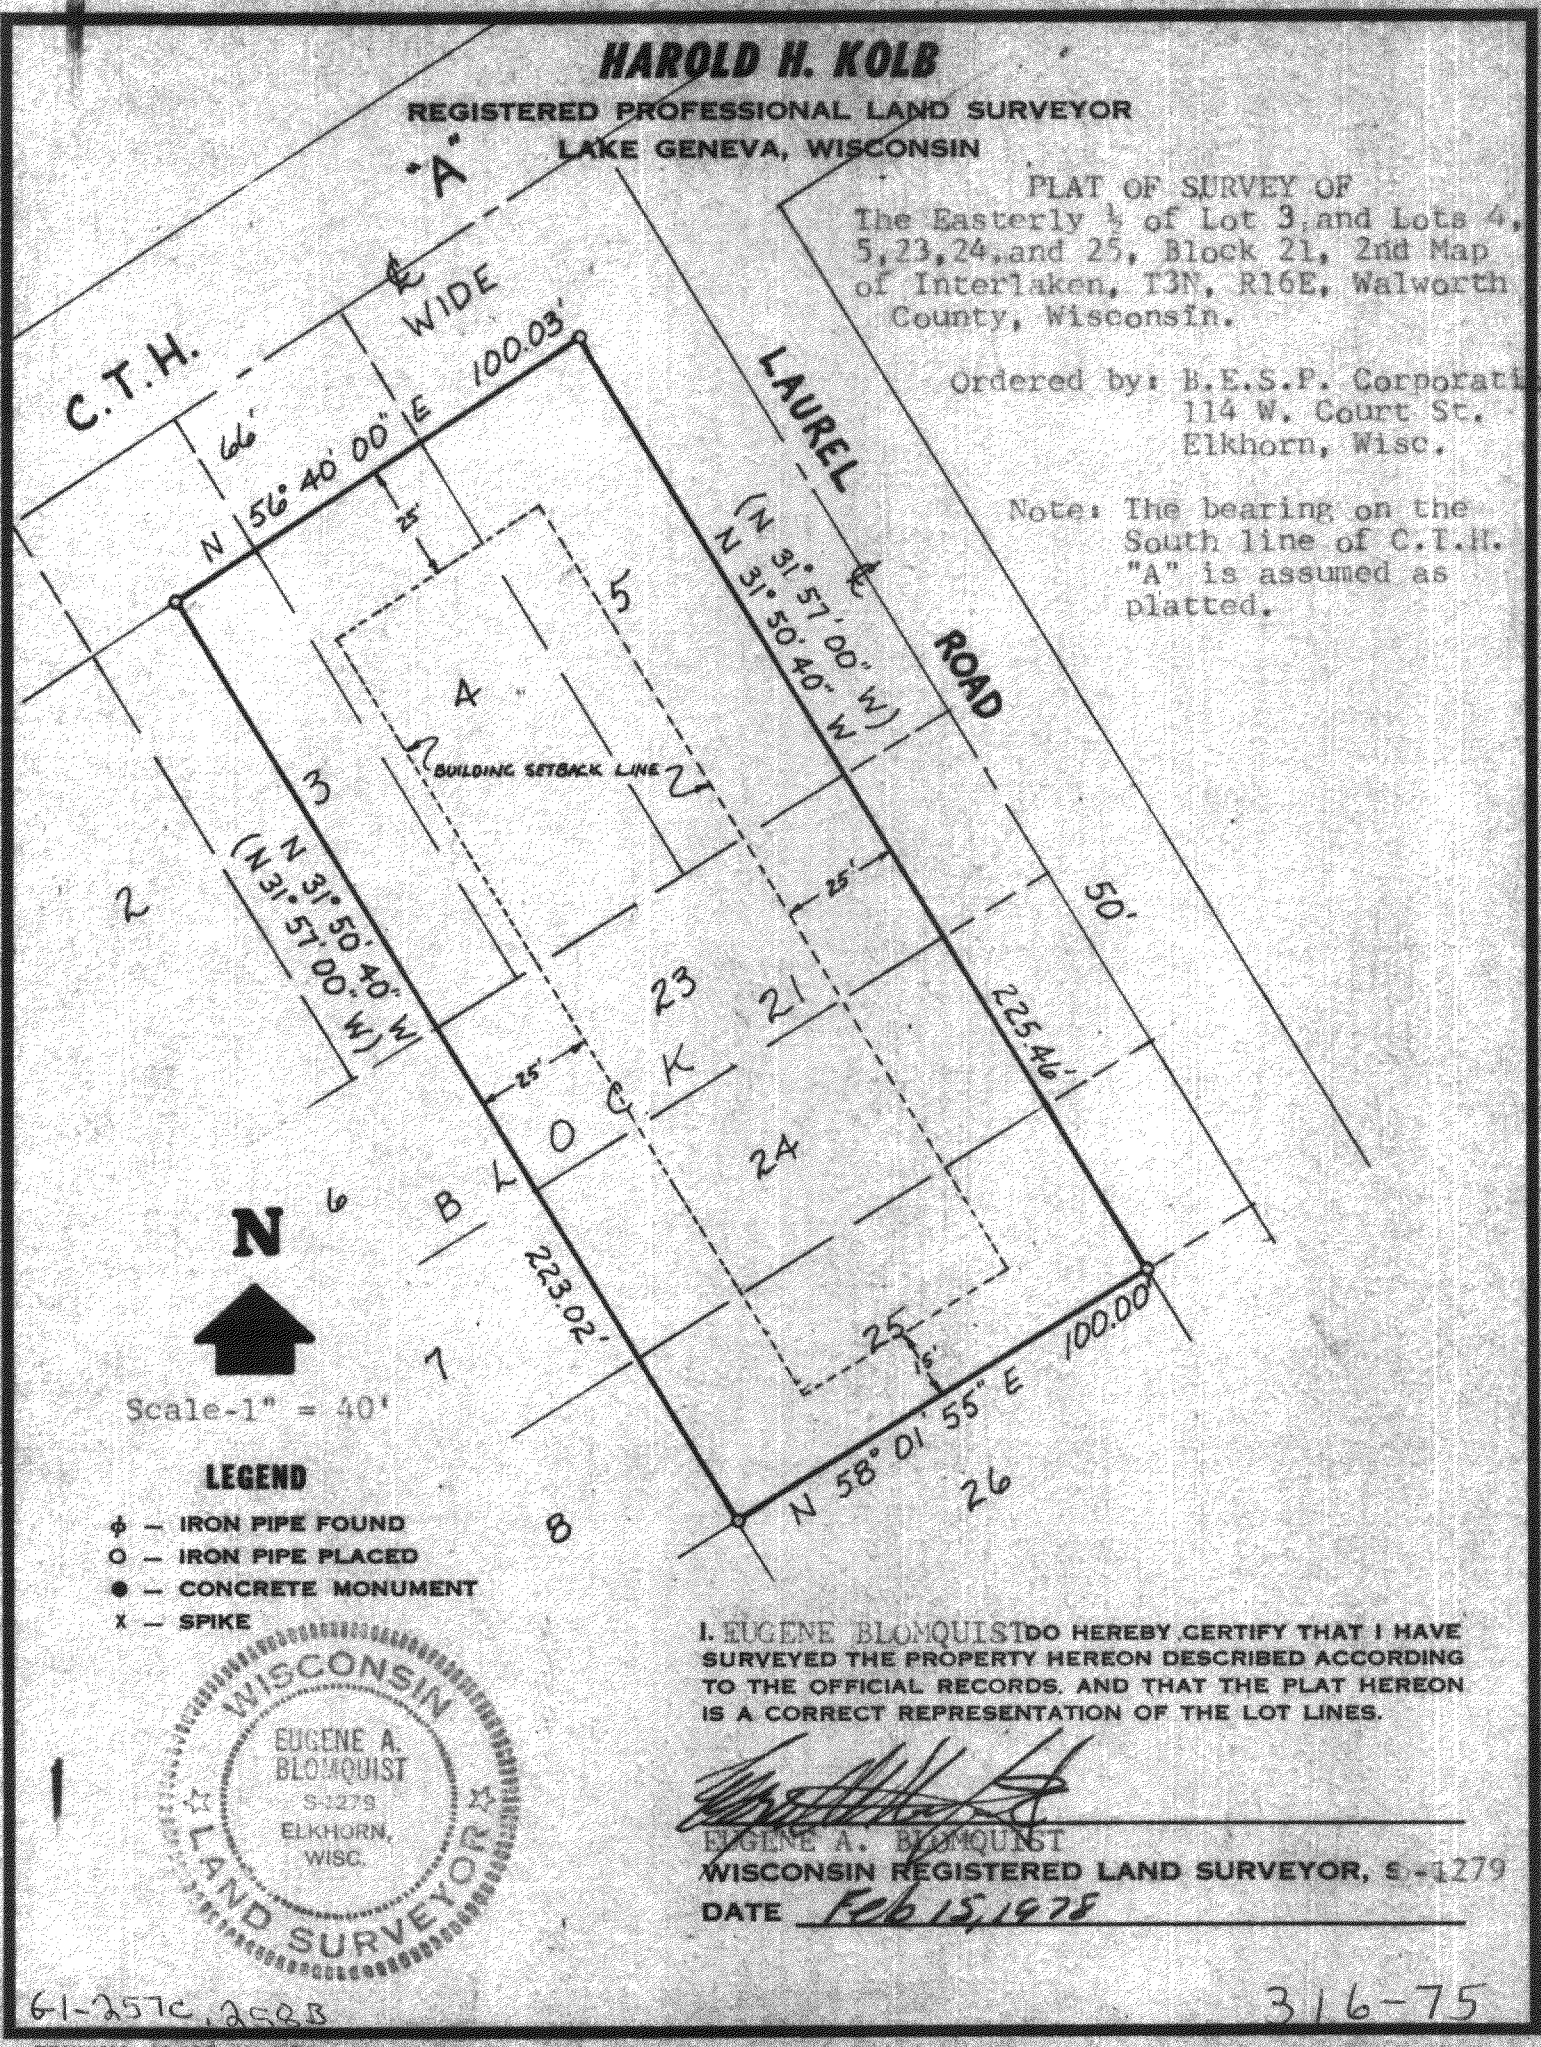


N



Scale-1" = 40'

LEGEND

- φ - IRON PIPE FOUND
- - IRON PIPE PLACED
- - CONCRETE MONUMENT
- x - SPIKE

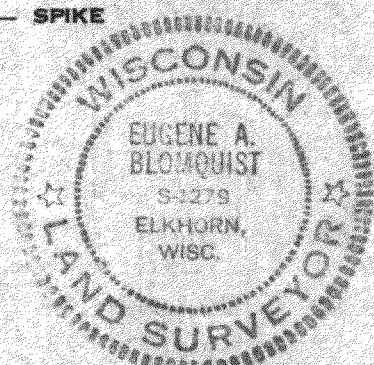

I, EUGENE BLUMQUIST DO HEREBY CERTIFY THAT I HAVE
SURVEYED THE PROPERTY HEREON DESCRIBED ACCORDING
TO THE OFFICIAL RECORDS, AND THAT THE PLAT HEREON
IS A CORRECT REPRESENTATION OF THE LOT LINES.

Eugene A. Blomquist
EUGENE A. BLUMQUIST

WISCONSIN REGISTERED LAND SURVEYOR, S-1279

DATE Feb 15, 1978

61-257C, 258B

316-75