

PLAT OF SURVEY

WORK ORDERED BY ---
GENE SCHILTS
P.O. BOX 378
ELKHORN, WISCONSIN 53121

FARRIS, HANSEN & ASSOCIATES, INC.
Engineering, Architecture, Surveying
7 Ridgway Court P.O. Box 437
ELKHORN, WISCONSIN 53121
Office: (414) 723-2098
Fax: (414) 723-5986

REVISIONS

PROJECT NO.

4643

DATE

11/14/96

SHEET NO.

1 OF 1

PLAT OF SURVEY

LOTS 7 THRU 17 OF BLOCK 36
& LOTS 1 THRU 8, THE WEST 1/2 OF LOT 11, & LOTS 12 THRU 15
OF BLOCK 31
INTERLAKEN SUBDIVISION, ACCORDING TO THE RECORDED PLAT
THEREOF, WALWORTH COUNTY, WISCONSIN


LEGAL DESCRIPTION

LANDS ADDED TO 1996 SURVEY

THE SYMMETRICAL ONE HALF OF LOT 34 ADJOINING LOT 33 AND THE SYMMETRICAL TWO THIRDS OF LOT 33 ADJOINING LOT 34, IN BLOCK 35, ON A MAP ENTITLED: THIRD MAP OF INTERLAKEN, TOWN OF SUGAR CREEK, WALWORTH COUNTY, WISCONSIN, AND RECORDED IN THE OFFICE OF THE REGISTER OF DEEDS FOR SAID COUNTY ON THE 20th DAY OF JUNE, 1929 IN VOLUME NO. 11 OF DEEDS, PAGES 4 AND 5.

AND ALSO
THE SYMMETRICAL ONE THIRD OF LOT 33 ADJOINING LOT 32, AND LOT 32, IN BLOCK 35, ON A MAP ENTITLED: THIRD MAP OF INTERLAKEN, TOWN OF SUGAR CREEK, WALWORTH COUNTY, WISCONSIN, AND RECORDED IN THE OFFICE OF THE REGISTER OF DEEDS FOR SAID COUNTY ON THE 20th DAY OF JUNE, 1929 IN VOLUME NO. 11 OF DEEDS, PAGES 4 AND 5.

AND ALSO THAT PART OF JUNIPER ROAD LYING SOUTH OF WHITTIER ROAD AS ABANDONED IN ROAD VACATION RECORDED IN VOL. 645, ON PAGE 4931 OF WALWORTH COUNTY DEEDS.

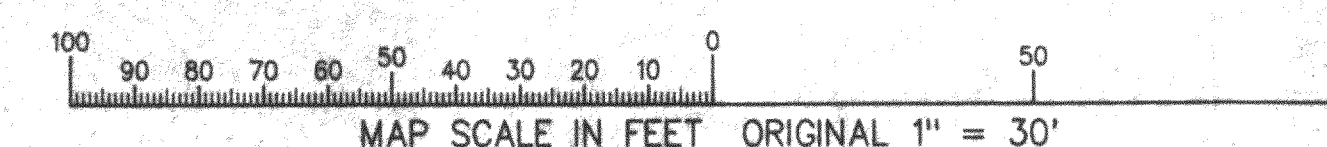



NOTE: COPIES OF THIS MAP TO WHICH THE FOLLOWING CERTIFICATE WILL APPLY ARE BLUE LINE PRINTS SHOWING SURVEYOR'S ORIGINAL SEAL AND SIGNATURE IN BLACK INK. COPIES BY ANY OTHER MEANS MAY HAVE ALTERATIONS WHICH DO NOT REPRESENT THE SURVEYOR'S WORK PRODUCT.

I HEREBY CERTIFY THAT THE ABOVE DESCRIBED PROPERTY HAS BEEN SURVEYED UNDER MY DIRECTION AND THAT THE ABOVE MAP IS A TRUE REPRESENTATION THEREOF AND SHOWS THE SIZE AND LOCATION OF THE PROPERTY AND ITS EXTERIOR BOUNDARIES. THIS SURVEY IS MADE FOR THE USE OF THE PRESENT OWNERS OF THE PROPERTY, AND ALSO THOSE WHO PURCHASE, MORTGAGE, OR GUARANTEE THE TITLE THERETO WITHIN ONE YEAR FROM THE DATE HEREOF.


DATED: 11-14-1996

REV 09-21-98

Peter S. Gordon
PETER S. GORDON R.L.S. 2101

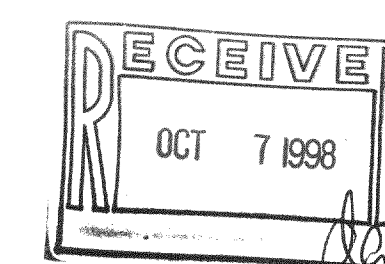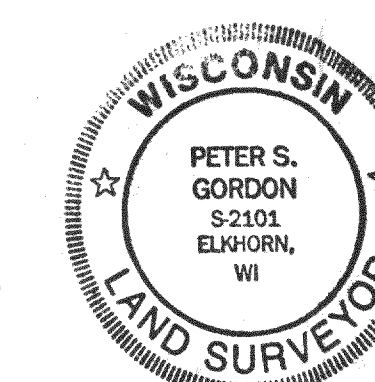

GI-319 GI-378
GI-320 GI-378A
GI-321 GI-380 316-1031

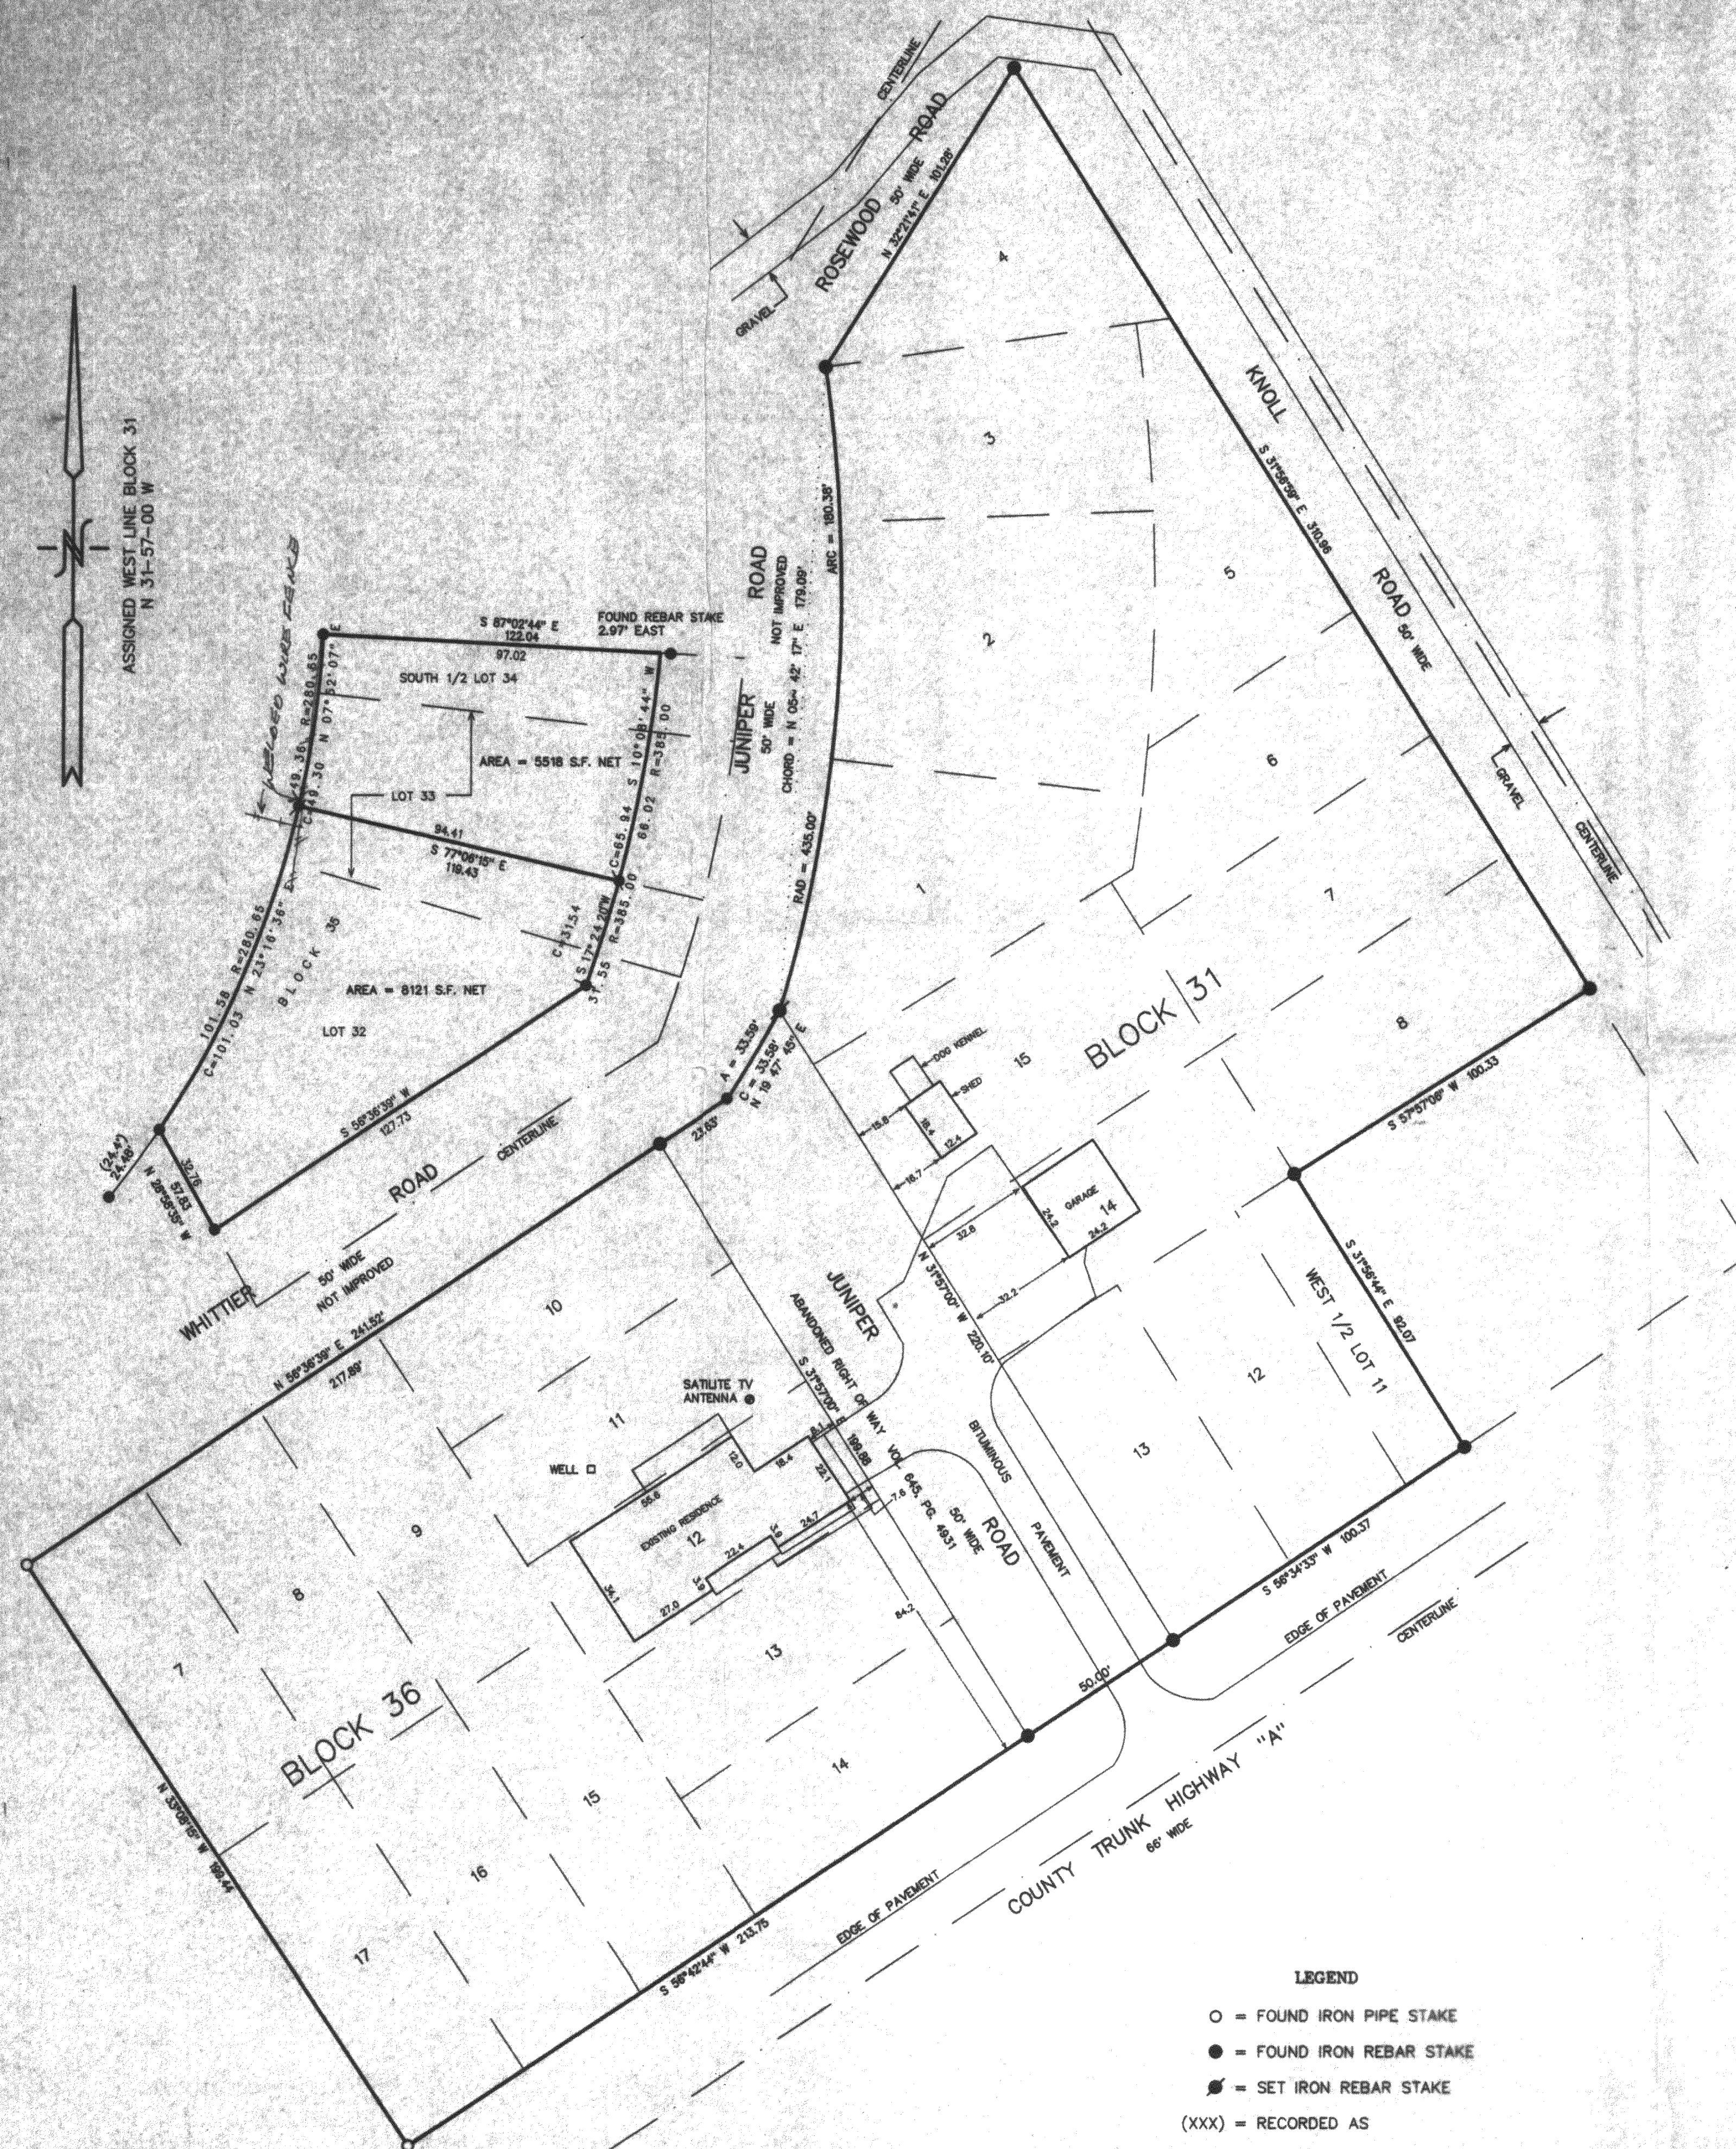

- LEGEND
- = FOUND IRON PIPE STAKE
 - = FOUND IRON REBAR STAKE
 - ✱ = SET IRON REBAR STAKE
 - (XXX) = RECORDED AS