


HAROLD H. KOLB

REGISTERED PROFESSIONAL LAND SURVEYOR
LAKE GENEVA, WISCONSIN

Note: The bearing on the South line of C.T.H. A is assumed as platted.

Ordered by: B.E.S.P. Corporation
114 W. Court St.
Elkhorn, Wisc.

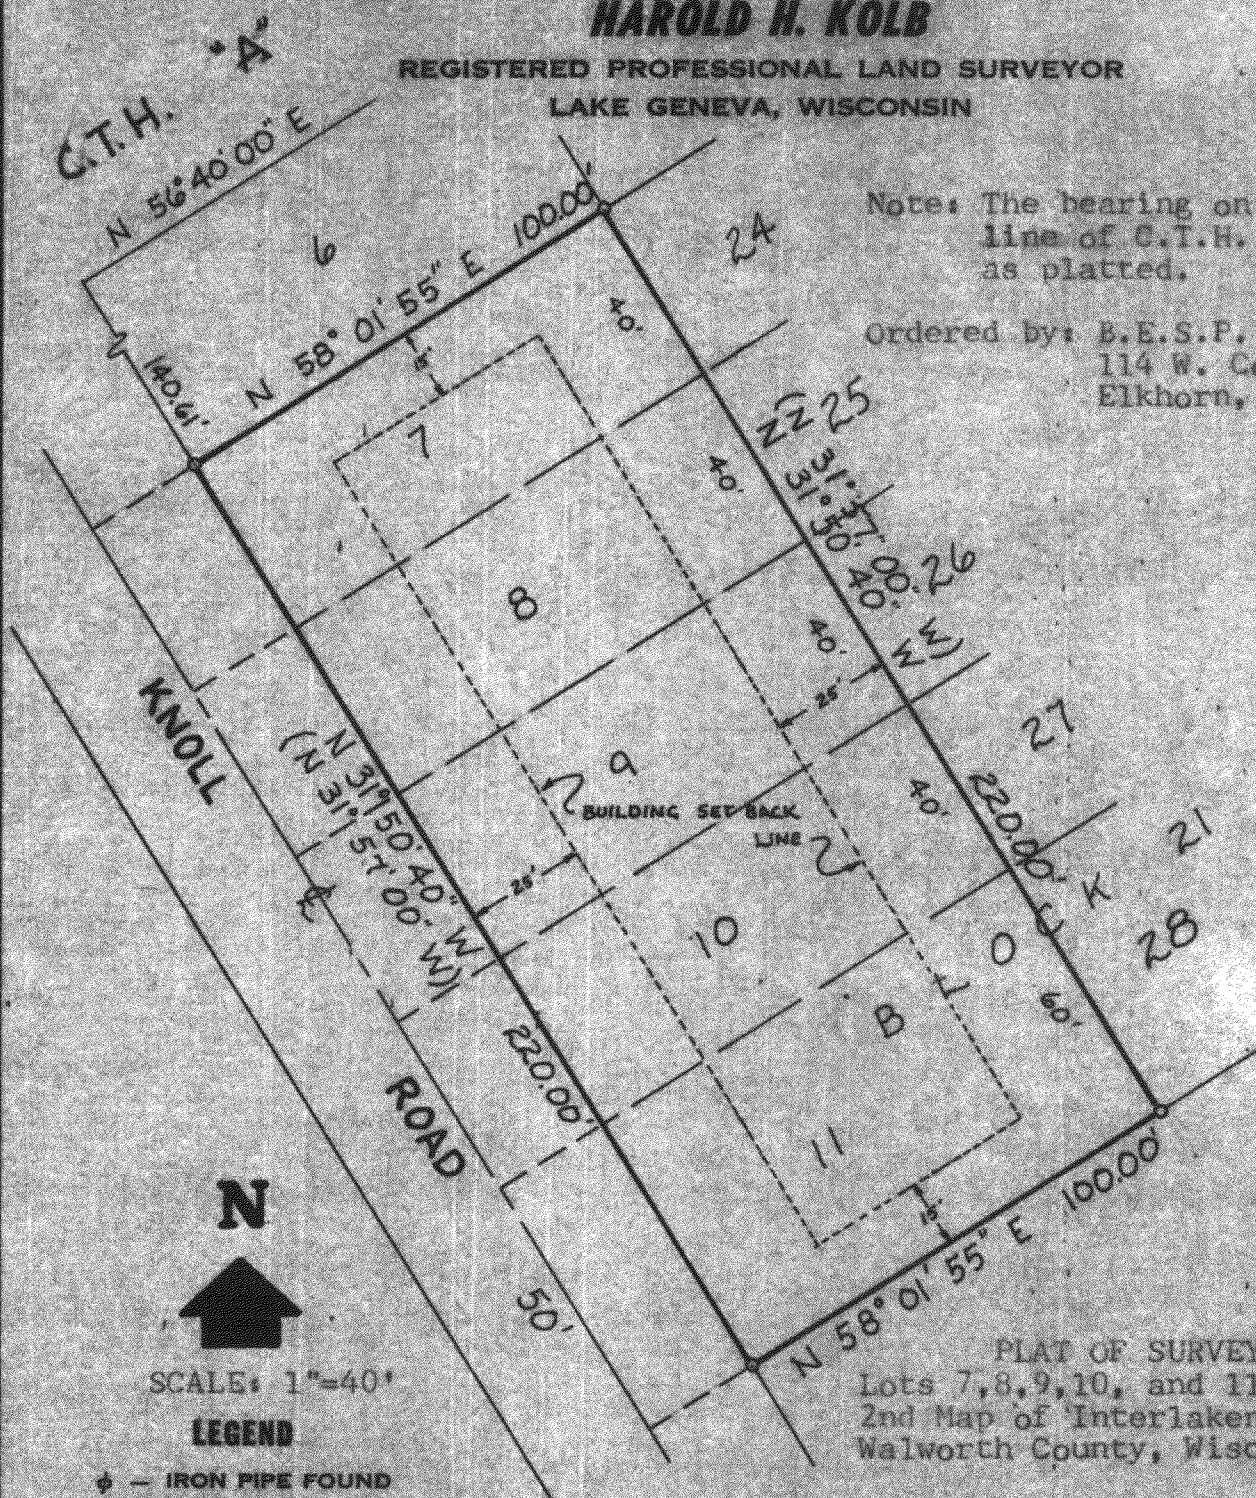


N



SCALE: 1"=40'

LEGEND

- ⊕ - IRON PIPE FOUND
- - IRON PIPE PLACED
- - CONCRETE MONUMENT
- x - SPIKE

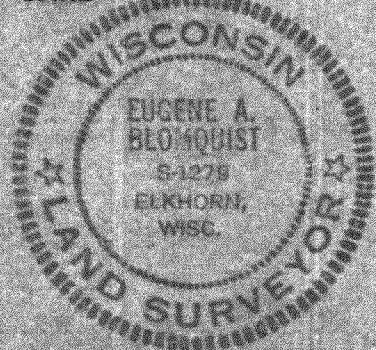

PLAT OF SURVEY OF
Lots 7, 8, 9, 10, and 11, Block 21,
2nd Map of Interlaken, T3N, R16E,
Walworth County, Wisconsin.

I, EUGENE BLOMQUIST DO HEREBY CERTIFY THAT I HAVE
SURVEYED THE PROPERTY HEREON DESCRIBED ACCORDING
TO THE OFFICIAL RECORDS, AND THAT THE PLAT HEREON
IS A CORRECT REPRESENTATION OF THE LOT LINES.

EUGENE A. BLOMQUIST
WISCONSIN REGISTERED LAND SURVEYOR, S-1279
DATE FEB 15, 1978

316-39