



Plat of Survey

of
Lots 8, 9, 10, 33, 34, 35, and 36
 in Block 60 of Interlaken,


a subdivision located in the Northeast 1/4 of Section 11,
 Town 3 North, Range 16 East, Town of Sugar Creek,
 Walworth County, Wisconsin.

Surveyed for: **Robert Dooley**
 N6657 Aspen Road
 Elkhorn, Wisconsin. 53121

Survey Date: July 16, 2012.
 Revisions:

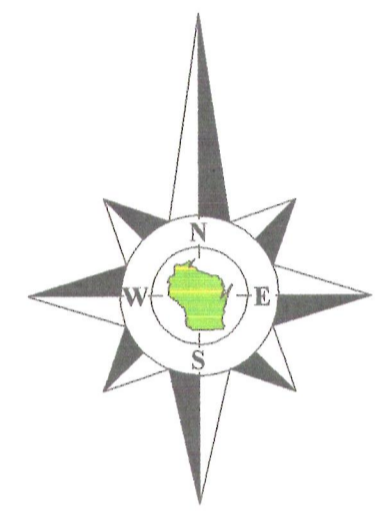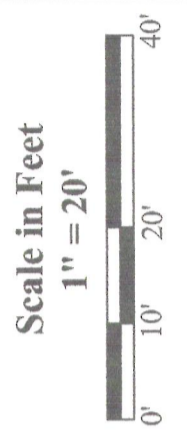


Bearings reference to the plat
 of Interlaken Subdivision.

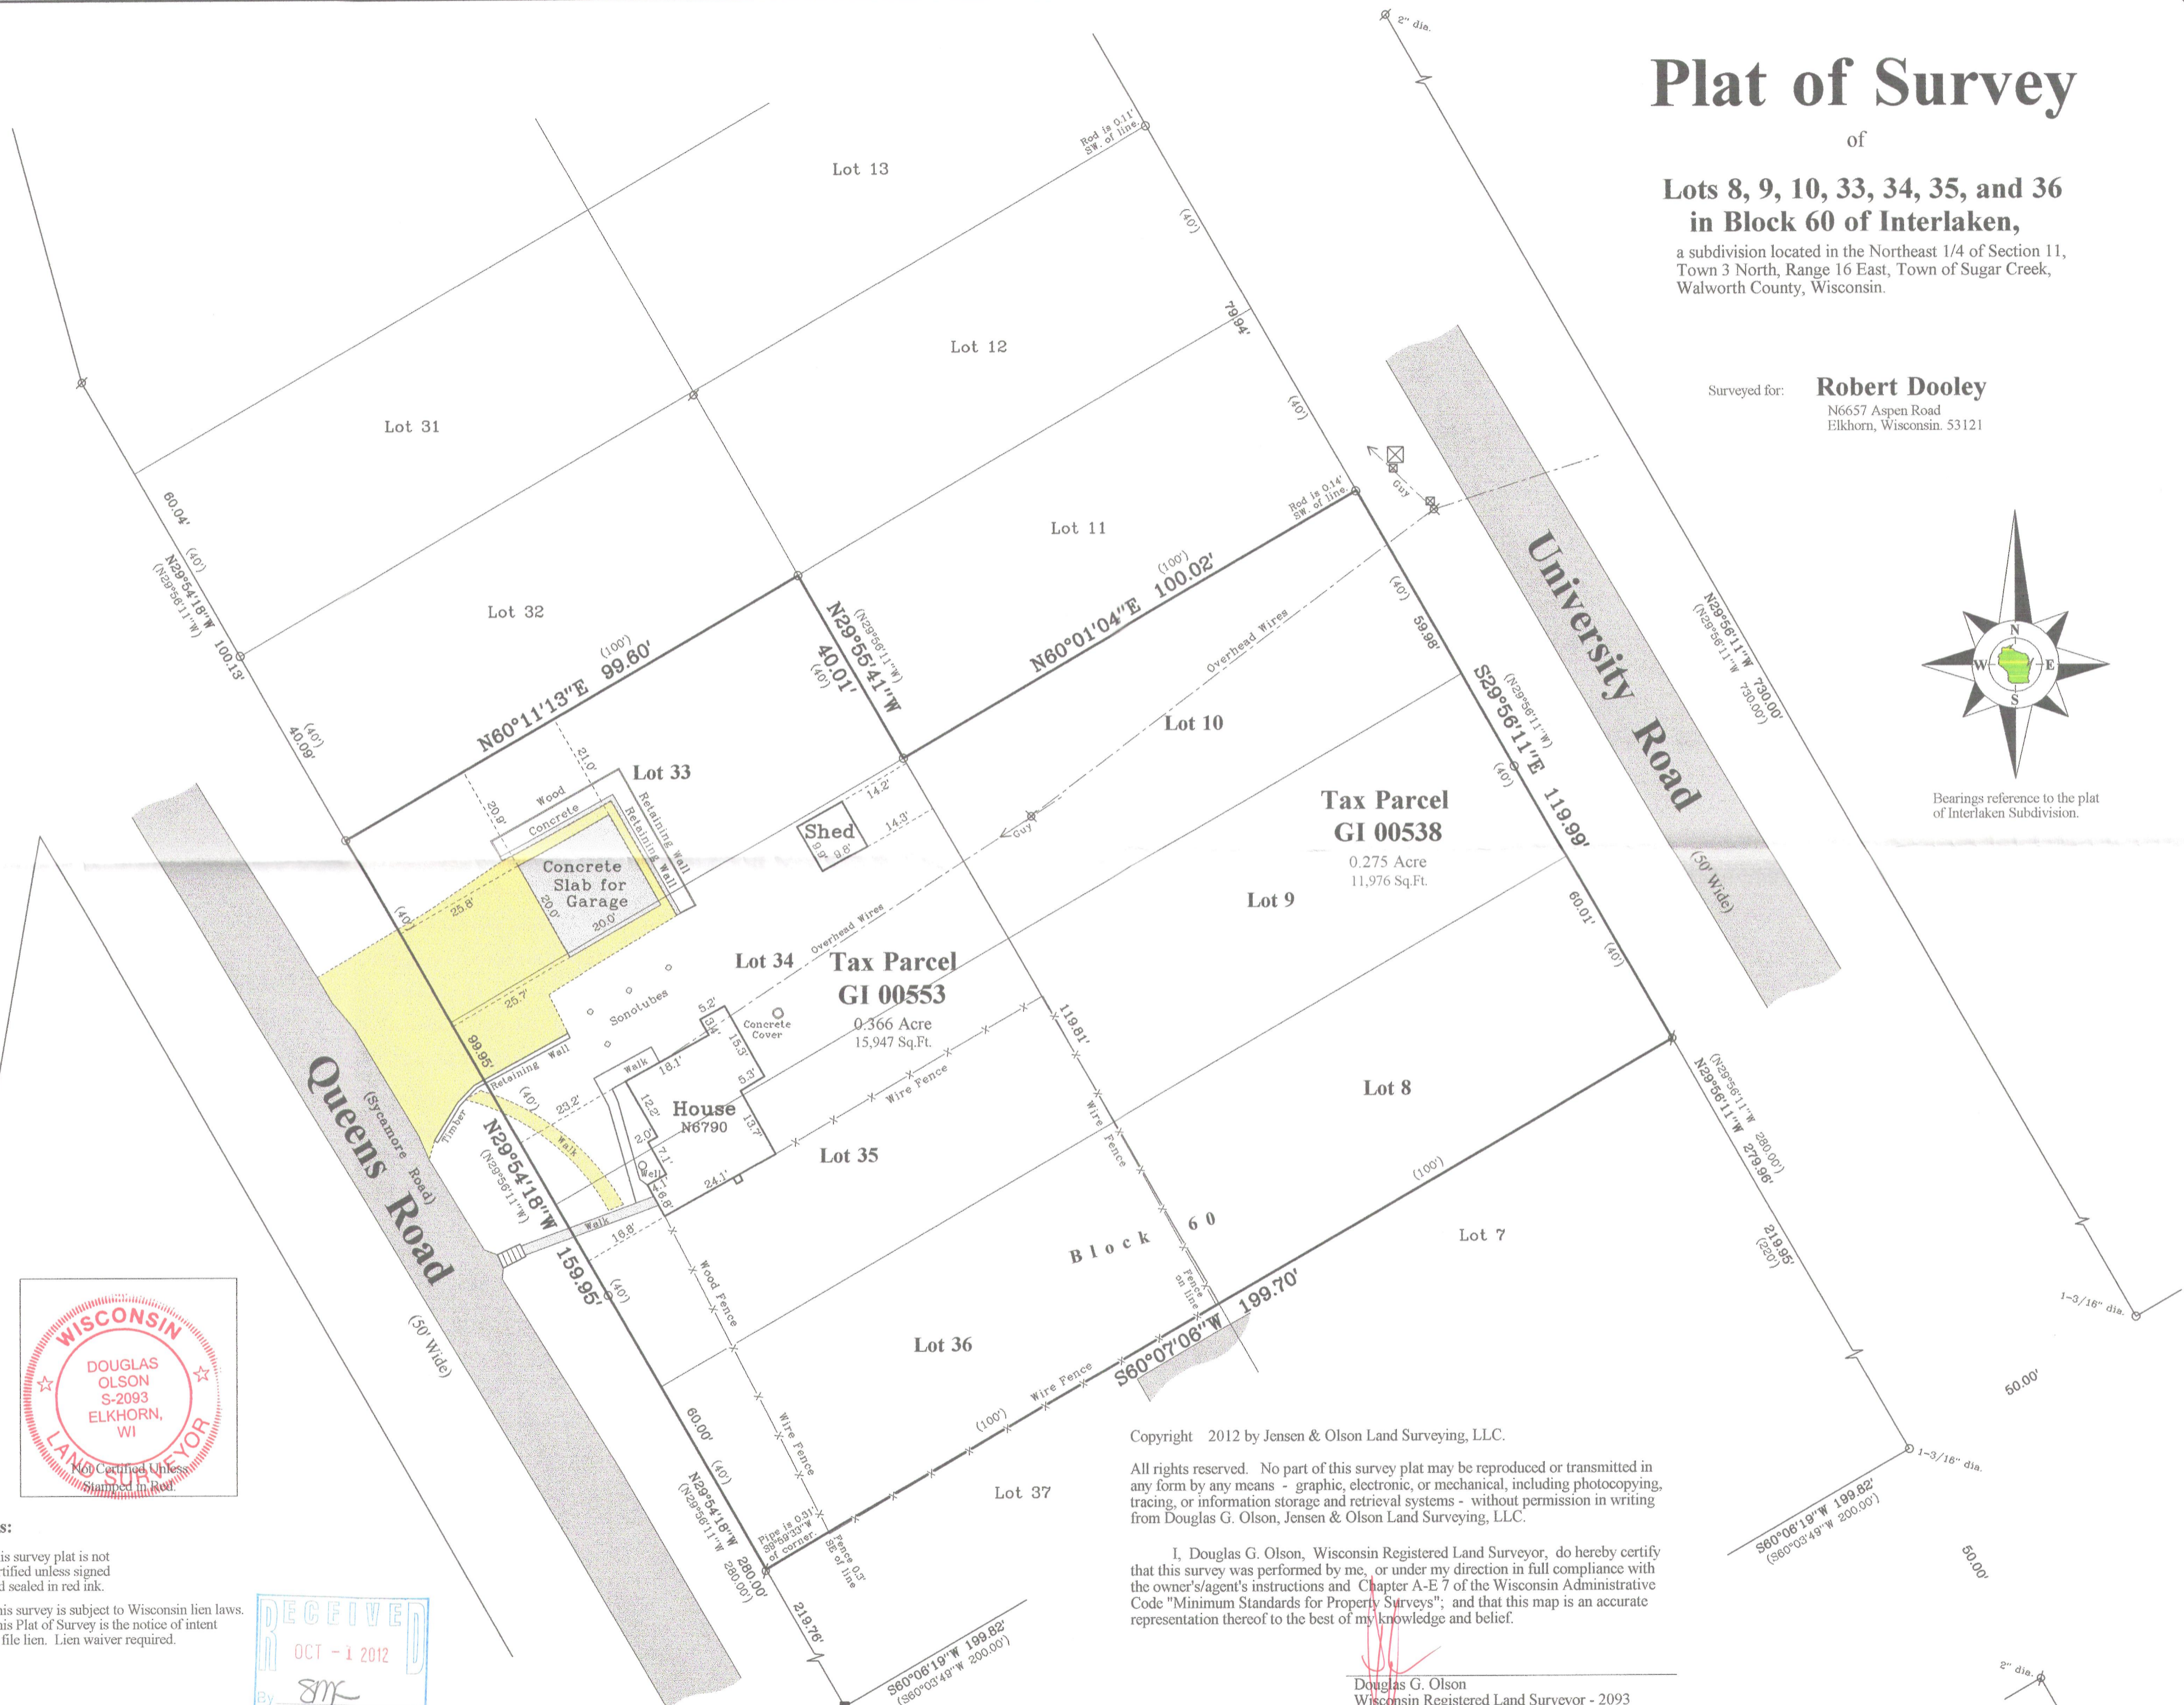

Tax Parcel GI 00538
 0.275 Acre
 11,976 Sq.Ft.

Tax Parcel GI 00553
 0.366 Acre
 15,947 Sq.Ft.

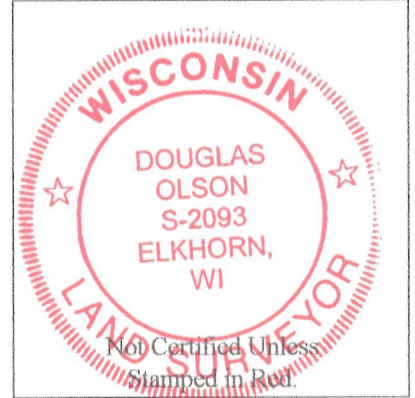

- Notes:**
- 1) This survey plat is not certified unless signed and sealed in red ink.
 - 2) This survey is subject to Wisconsin lien laws. This Plat of Survey is the notice of intent to file lien. Lien waiver required.



Copyright 2012 by Jensen & Olson Land Surveying, LLC.
 All rights reserved. No part of this survey plat may be reproduced or transmitted in any form by any means - graphic, electronic, or mechanical, including photocopying, tracing, or information storage and retrieval systems - without permission in writing from Douglas G. Olson, Jensen & Olson Land Surveying, LLC.

I, Douglas G. Olson, Wisconsin Registered Land Surveyor, do hereby certify that this survey was performed by me, or under my direction in full compliance with the owner's/agent's instructions and Chapter A-E 7 of the Wisconsin Administrative Code "Minimum Standards for Property Surveys"; and that this map is an accurate representation thereof to the best of my knowledge and belief.

Douglas G. Olson
 Wisconsin Registered Land Surveyor - 2093

Jensen & Olson Land Surveying, LLC
 45 South Wisconsin Street * P.O. Box 322 * Elkhorn, Wisconsin. 53121
 Telephone: (262) 723-3434 * Facsimile: (262) 723-8044
 Email: jensen.olson@elknet.net

- Legend**
- Found Concrete Monument
 - Found Iron Pipe
 - Found Iron Rod
 - Recorded Information
 - Utility Pedestal
 - Utility Pole
 - Concrete Surface
 - Asphalt Surface
 - Gravel

Sheet 1 of 1 Sheets
 Drawing Name: C:\16-2012037-2012037\Plat.dwg
 Job Reference Number
2012.037

2012.037

GI 553 GI 538

316-2127