PLAT OF SURVEY
OF
LOTS 30, 31, 32, 33, BLK 20, OF THE 2ND MAP OF INTERLAKEN SUBDIVISION, LOCATED IN THE SE¼ OF SECTION 11, T3N R16E, WALWORTH COUNTY, WIS.

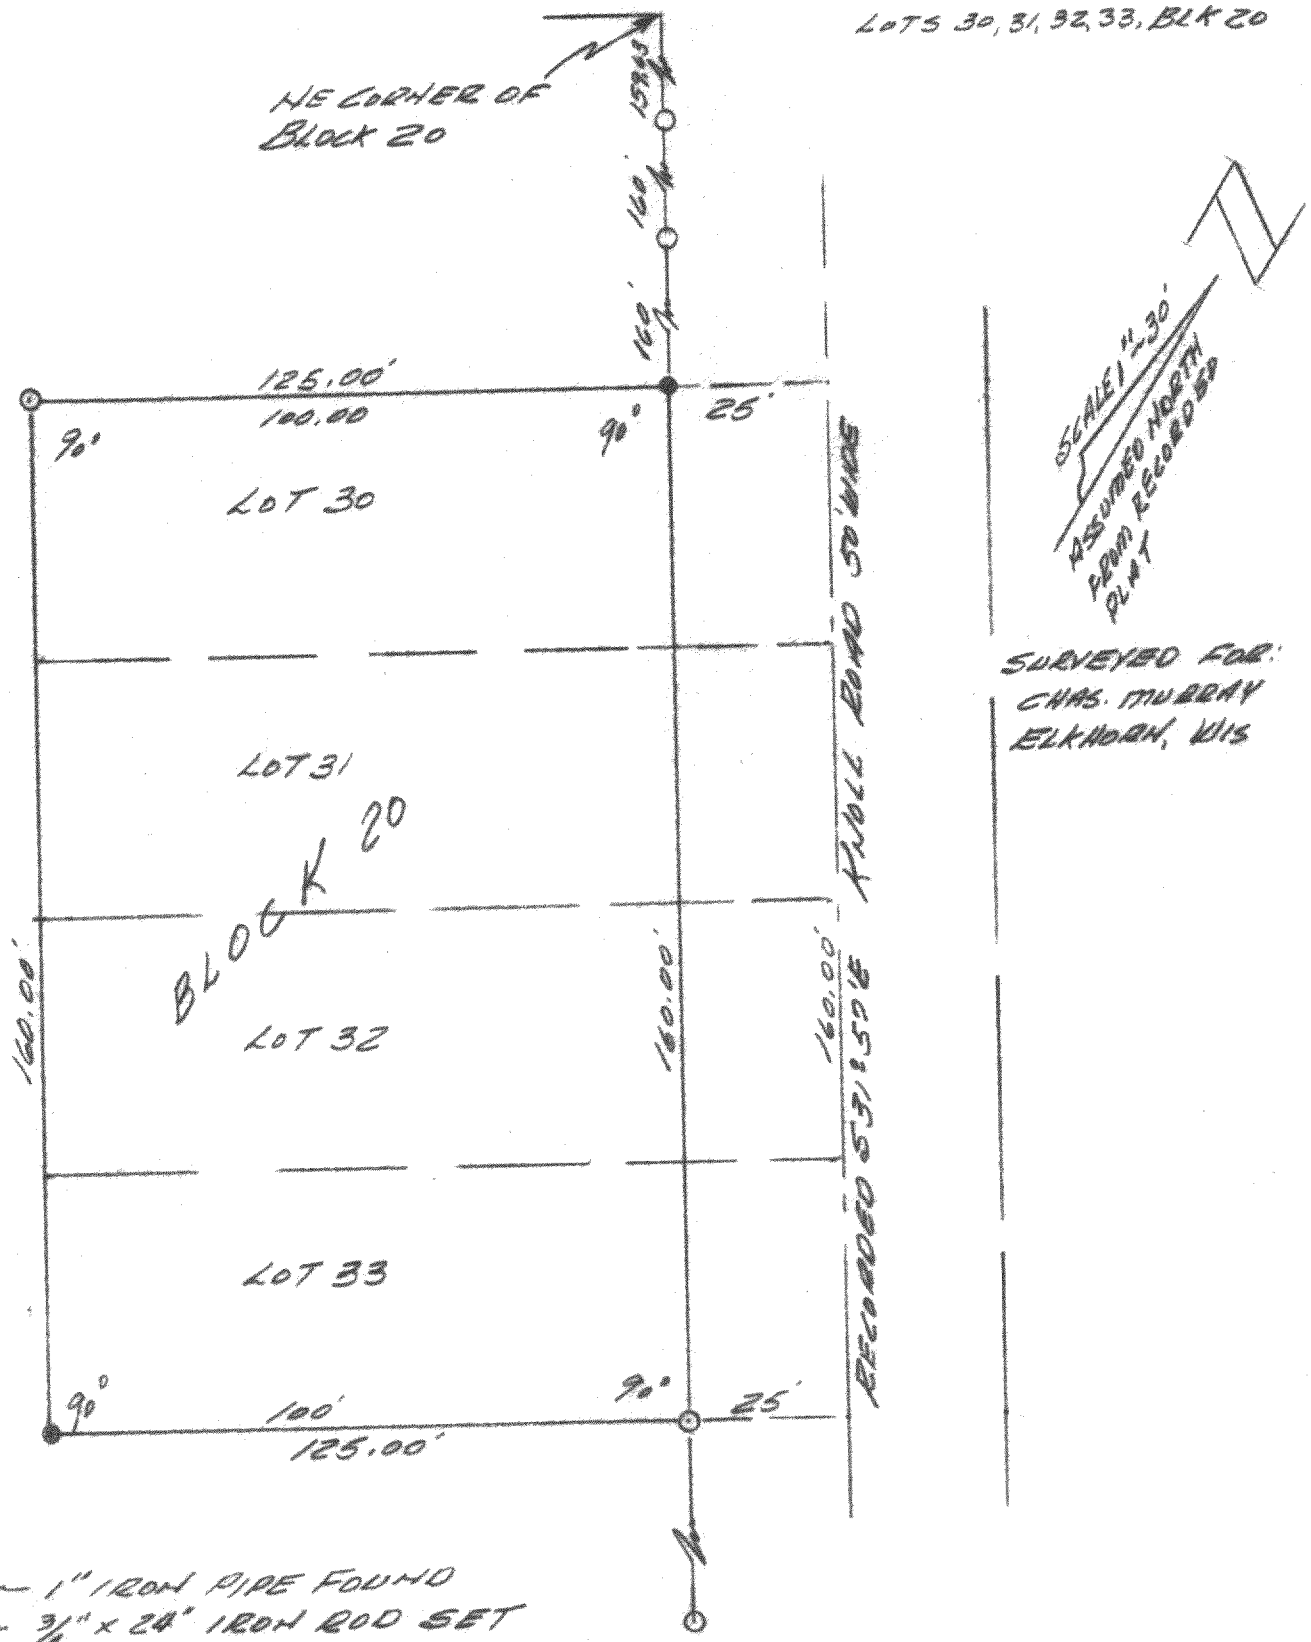

○— 1" IRON PIPE FOUND
●— ¾" x 24" IRON ROD SET

WISCONSIN
THOMAS P. A. JENSEN
S-1084
ELKHORN, WIS.
LAND SURVEYOR

I CERTIFY THAT I SURVEYED THE ABOVE DESCRIBED PROPERTY & THAT THE PLAT SHOWN HEREON IS AN ACCURATE SURVEY & A TRUE REPRESENTATION THEREOF & CORRECTLY SHOWS THE EXTERIOR BOUNDARY LINES & ALL DIVISIONS OF SAID PROPERTY.
APRIL 6, 1977

Thomas P.A. Jensen
THOMAS P.A. JENSEN, R.L.S. #1084
JENSEN SURVEYING & MAPPING
ELKHORN, WIS

61-257A

316-223