ABELL
SURVEYING & MAPPING
DELAVAN, WISCONSIN 53115
414-728-6737

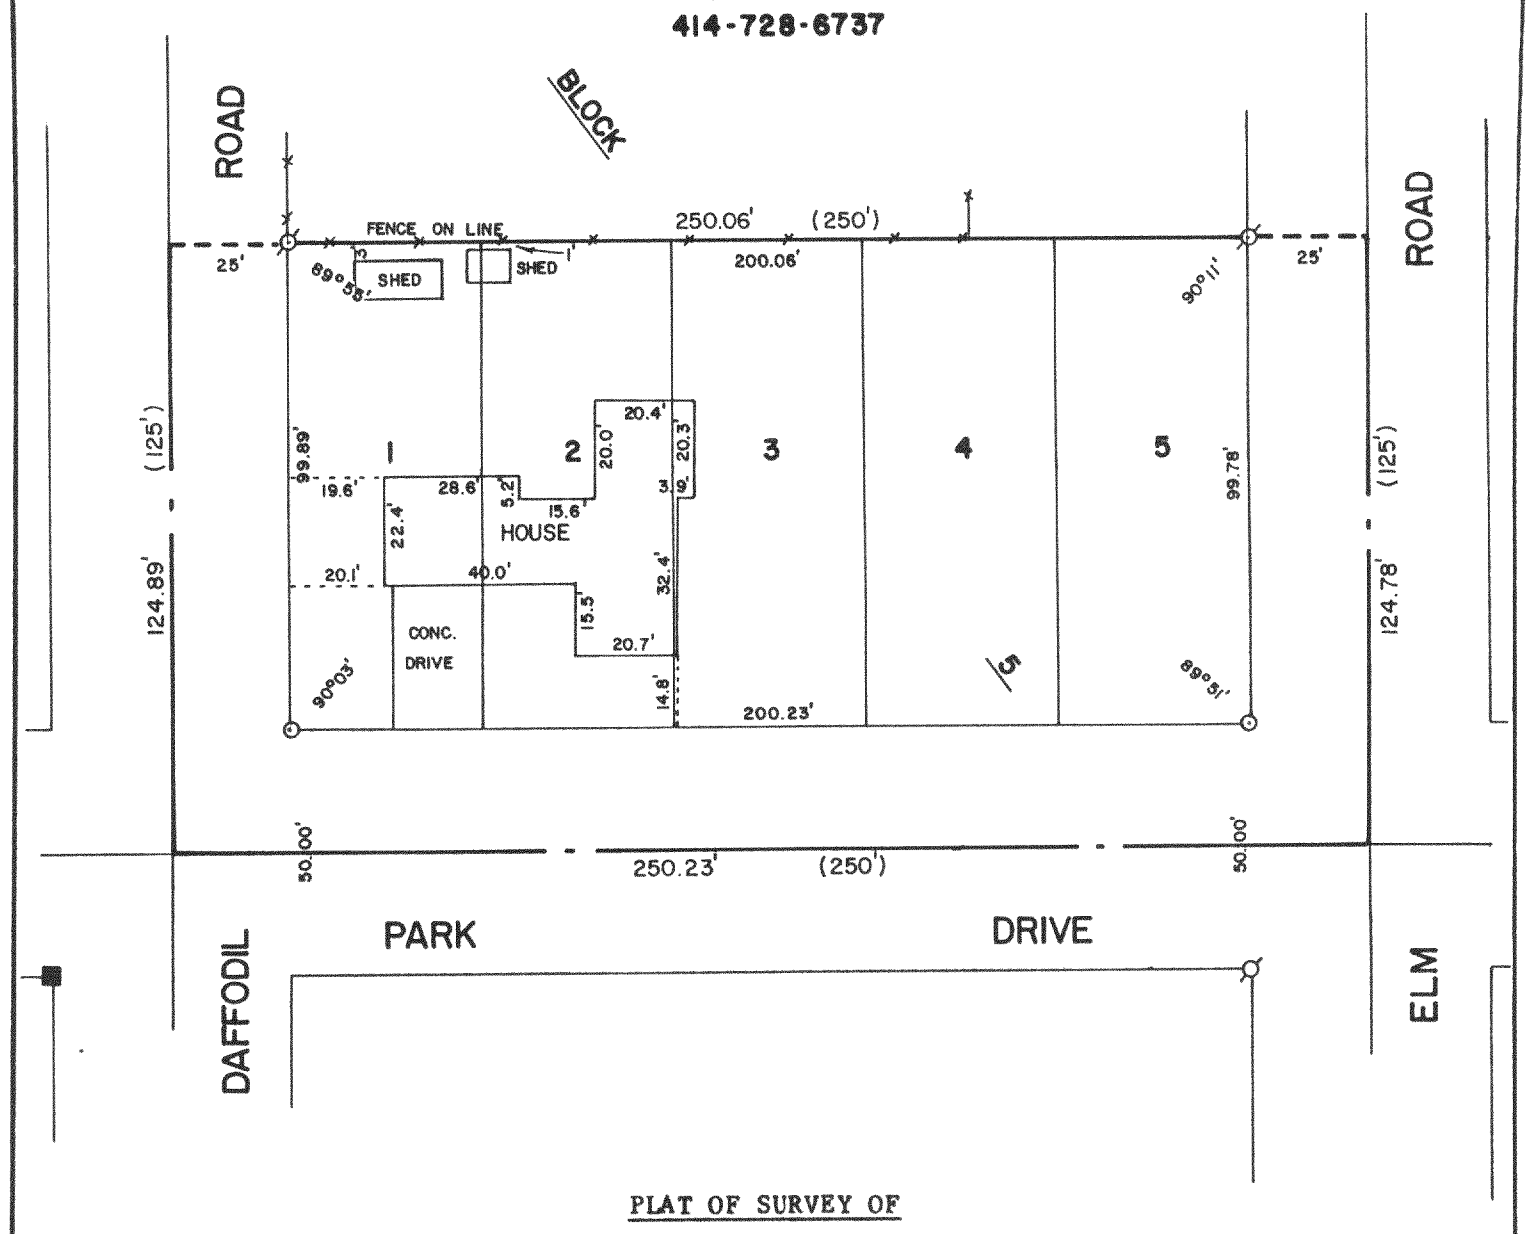

PLAT OF SURVEY OF

LOTS 1-5, BLOCK 5, INTERLAKEN SUBDIVISION,
T3N,R16E, WALWORTH COUNTY, WISCONSIN.

ORDERED BY: CENTURY 21 - WALTON REALTY
704 N. LINCOLN
ELKHORN, WI. 53121

RECEIVED

N

SCALE - 1"=40'

LEGEND
- ø - IRON PIPE FOUND
- ■ - CONCRETE MONUMENT FOUND
- o - IRON ROD SET
- ( ) - RECORDED AS

I, DAVID F. ABELL, DO HEREBY CERTIFY THAT I HAVE SURVEYED THE PROPERTY HEREON DESCRIBED ACCORDING TO THE OFFICIAL RECORDS AND THAT THE PLAT HEREON IS A CORRECT REPRESENTATION OF THE PROPERTY LINES TO THE BEST OF MY KNOWLEDGE AND BELIEF.

David F. Abell
DAVID F. ABELL
WISCONSIN REGISTERED LAND SURVEYOR, S-1596

December 28, 1987
DATE JOB NUMBER - 87212

NOTE: THIS IS NOT A CERTIFIED COPY UNLESS SEALED.

316-410