ABELL
SURVEYING & MAPPING

DELAVAN, WISCONSIN 53115

414-728-6737

NOTE: BEARINGS ARE REFERENCED TO THE RECORDED SUBDIVISION PLAT.

SCALE 1"=30'

LEGEND

- -IRON PIPE FOUND
- -IRON ROD FOUND
- -IRON PIPE SET
- -SOIL BORING
- -60d SPIKE SET
- ( )-RECORDED AS

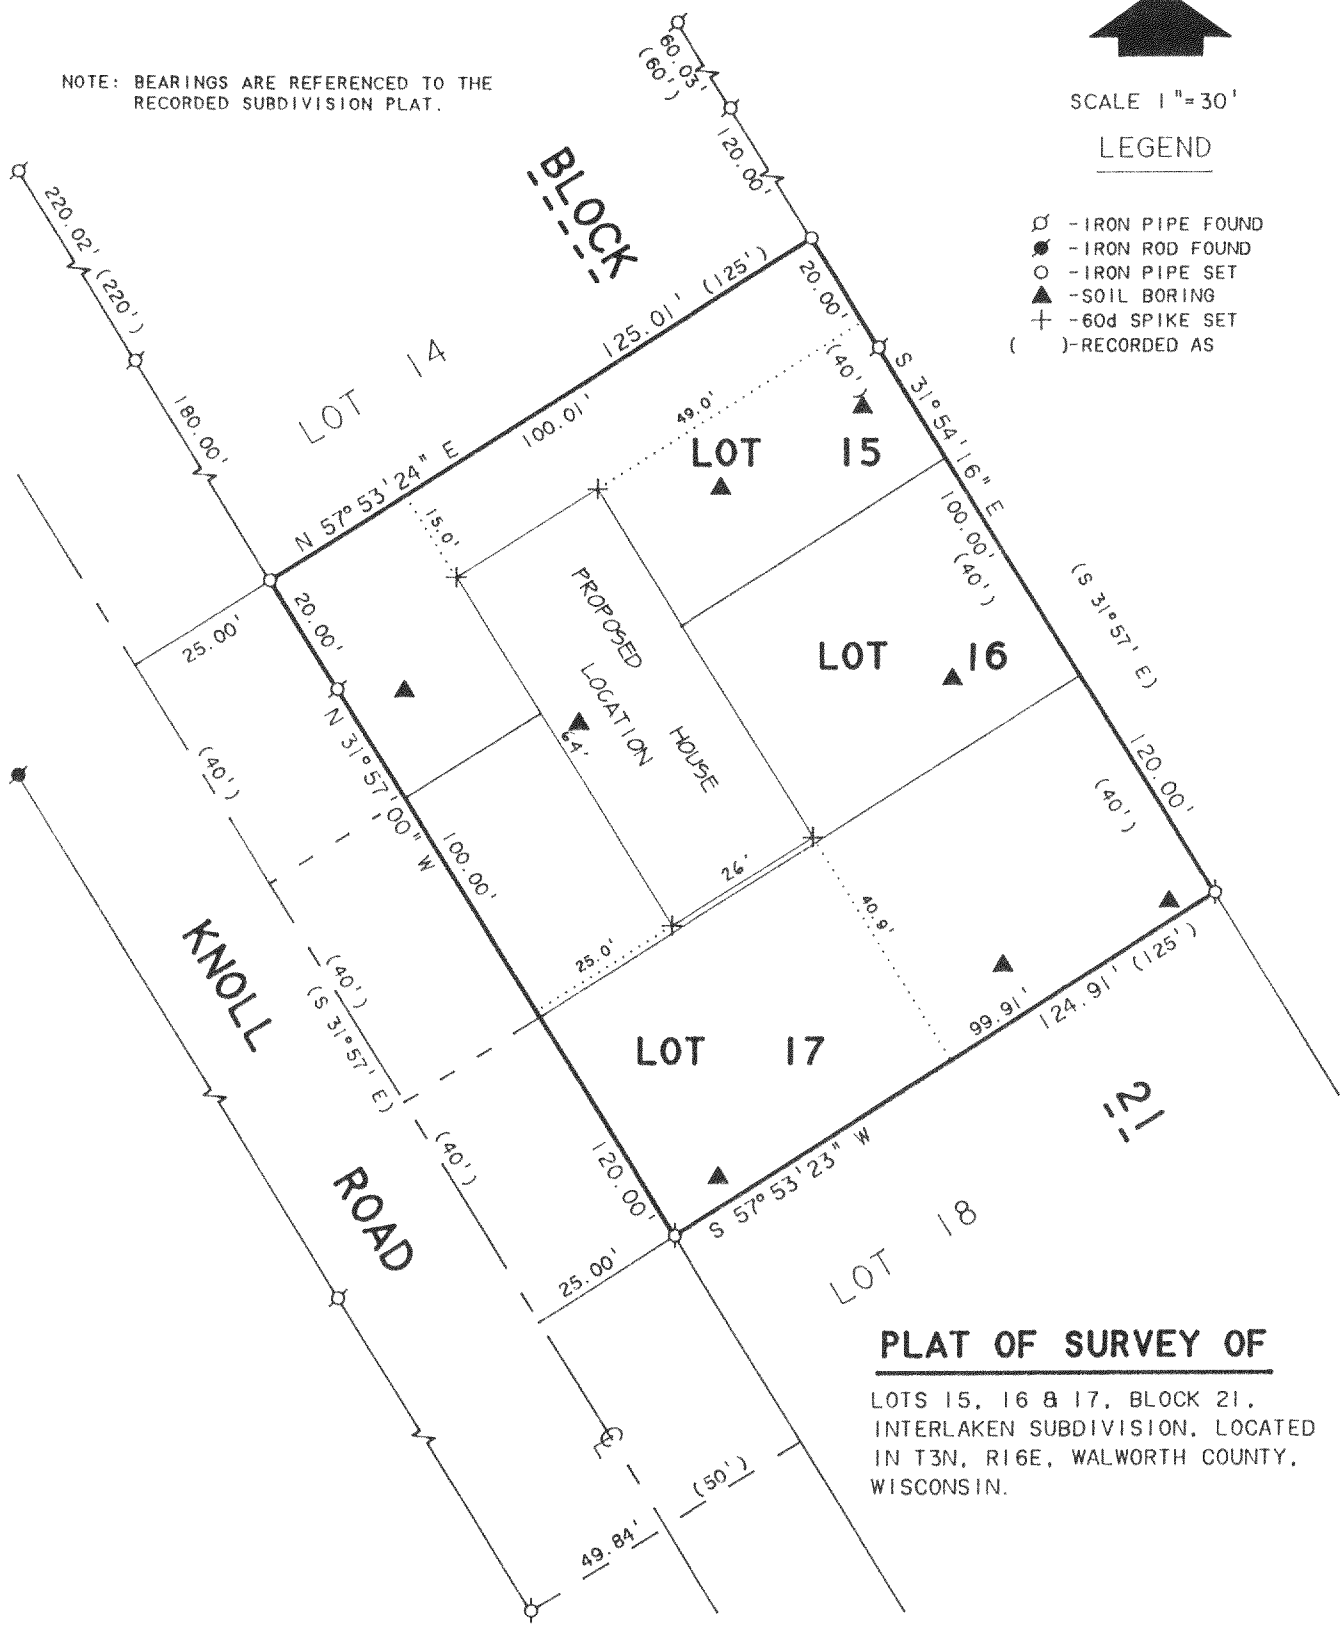

PLAT OF SURVEY OF

LOTS 15, 16 & 17, BLOCK 21, INTERLAKEN SUBDIVISION, LOCATED IN T3N, R16E, WALWORTH COUNTY, WISCONSIN.

ORDERED BY: JOHN DAMORE
511 PHOENIX ST
DELAVAN, WI 53115

I, DAVID F. ABELL, DO HEREBY CERTIFY THAT I HAVE SURVEYED THE PROPERTY HEREON DESCRIBED ACCORDING TO THE OFFICAL RECORDS AND THAT THE PLAT HEREON IS A CORRECT REPRESENTATION OF THE PROPERTY LINES TO THE BEST OF MY KNOWLEDGE AND BELIEF.

David F. Abell

DAVID F. ABELL
WISCONSIN REGISTERED LAND SURVEYOR, S-1596

RECEIVED
FEB 12 1993

OCTOBER 6, 1992 — REVISED DATE: OCTOBER 22, 1992

DATE — JOB NUMBER - 92219

NOTE: THIS IS NOT A CERTIFIED COPY UNLESS SEALED.

G1-258A1

316-600