ABELL
SURVEYING & MAPPING

DELAVAN, WISCONSIN 53115

414-728-6737

ORDERED BY: FIVE LAKES BUILDERS
39 MILL STREET
EVANSVILLE, WI 53536

MAY 29, 1996 - STAKED PROPOSED HOUSE WITH 60d SPIKES.

NOTE: BEARINGS ARE REFERENCED TO THE RECORDED SUBDIVISION PLAT.

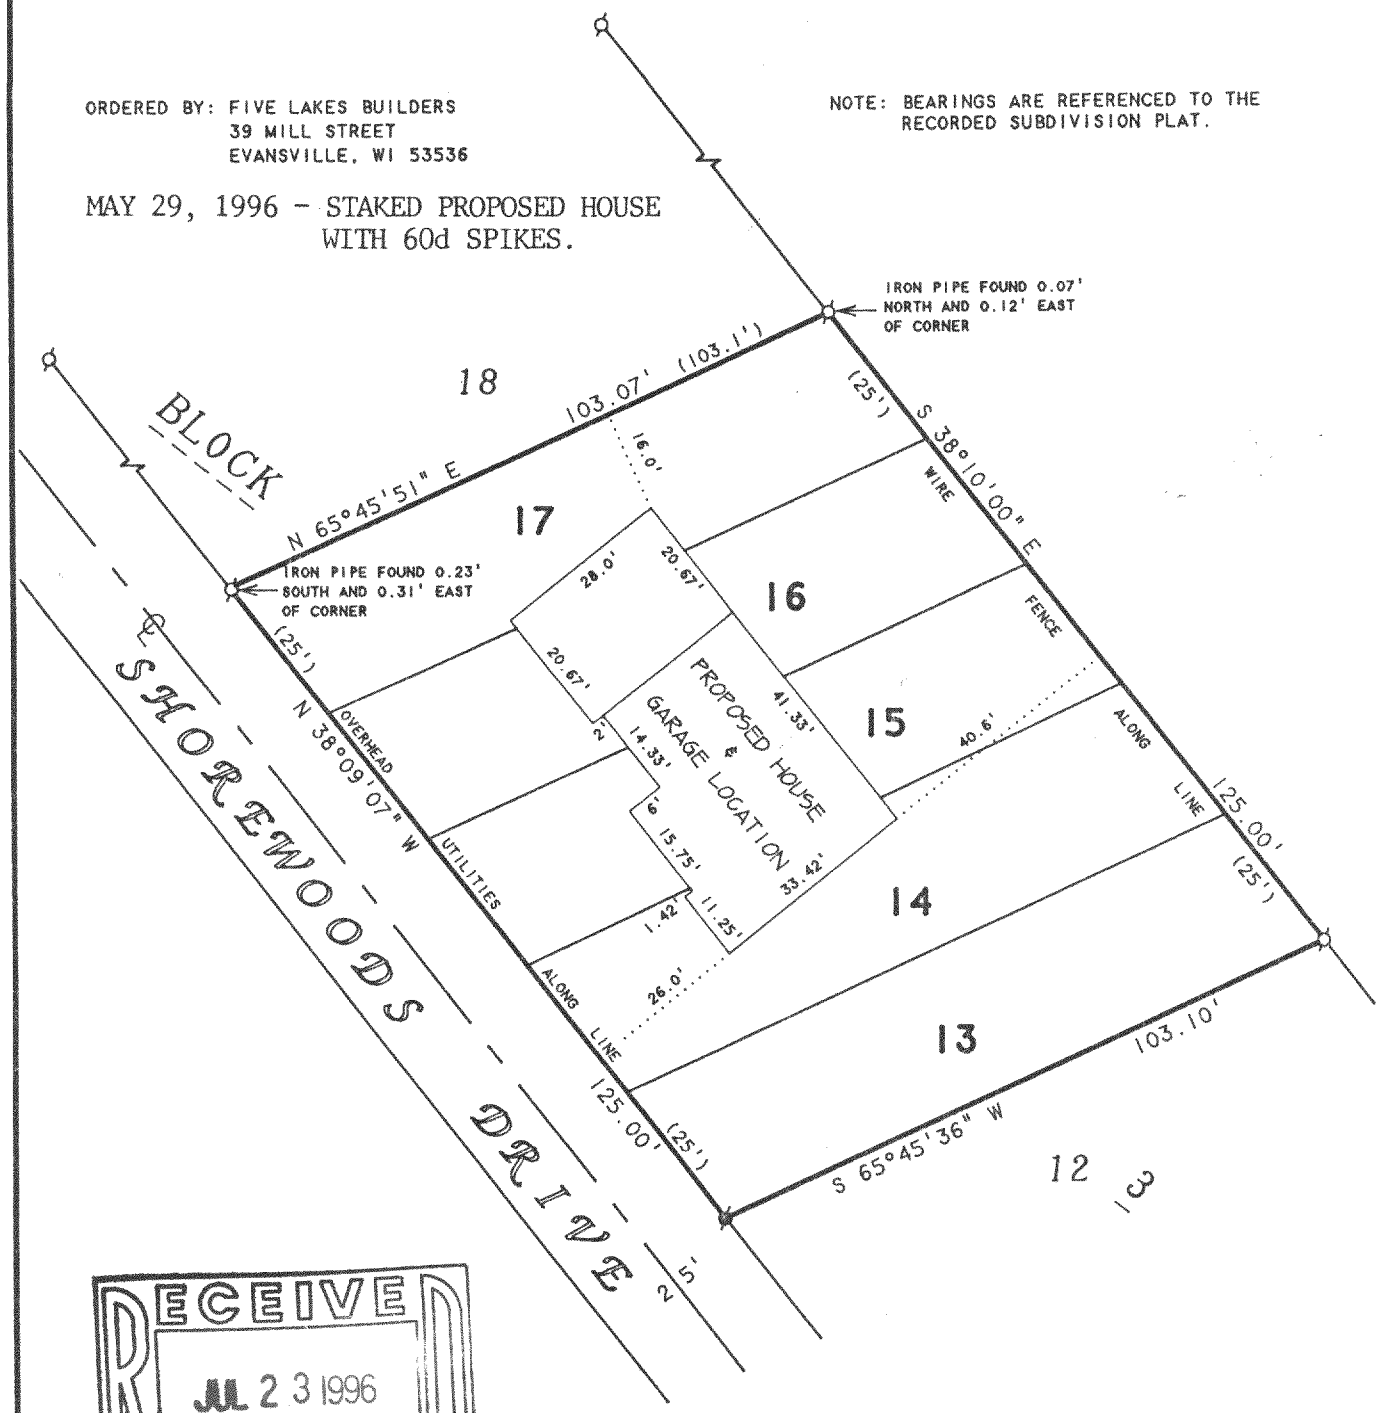

RECEIVED
JUL 23 1996

PLAT OF SURVEY OF

LOTS 13 - 17, BLOCK 3, NORTH LAKE SHOREWOODS, LOCATED IN T3N, R16E, WALWORTH COUNTY, WISCONSIN.

N

SCALE 1"=30'

LEGEND

- -IRON PIPE FOUND
- -IRON ROD FOUND
- ( )-RECORDED AS

I HEREBY CERTIFY THAT I HAVE SURVEYED THE ABOVE DESCRIBED PROPERTY AND THAT THE ABOVE MAP IS A TRUE REPRESENTATION THEREOF AND SHOWS THE SIZE AND LOCATION OF THE PROPERTY, ITS EXTERIOR BOUNDARIES, THE LOCATION OF ALL VISIBLE STRUCTURES AND DIMENSIONS OF ALL PRINCIPAL BUILDINGS THEREON, BOUNDARY FENCES, APPARENT EASEMENTS, ROADWAYS AND VISIBLE ENCROACHMENTS, IF ANY, TO THE BEST OF MY KNOWLEDGE AND BELIEF.

THIS SURVEY IS MADE FOR THE USE OF THE PRESENT OWNERS OF THE PROPERTY, AND ALSO THOSE WHO PURCHASE, MORTGAGE, OR GUARANTEE THE TITLE THERETO WITHIN ONE (1) YEAR FROM DATE HEREON.

David F. Abell

DAVID F. ABELL
WISCONSIN REGISTERED LAND SURVEYOR, S-1596

May 9, 1996 REVISED: 5/29/96

DATE JOB NUMBER - 94096

NOTE: THIS IS NOT A CERTIFIED COPY UNLESS SEALED.

CWLS-27
316-848