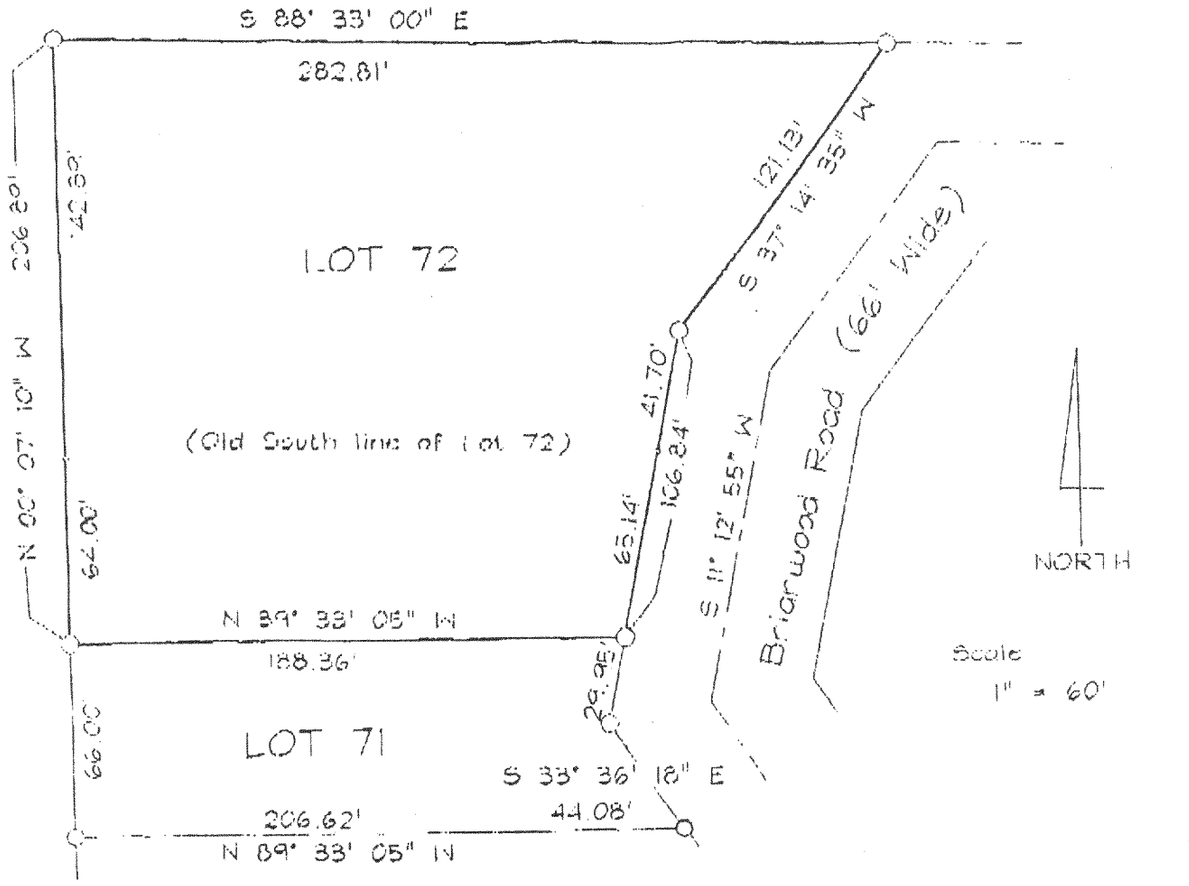

LEGEND

O - 1" IRON PIPE FOUND
O - 1" IRON PIPE SET
O - 2" IRON PIPE FOUND
O - 2" IRON PIPE SET

DESCRIPTION:

Lot 72 & the North 64.00' of Lot 71,
Sylvan Trace Subdivision, in the
NW 1/4 Section 2, T3N, R16E,
Walworth Co., Wisconsin.
This is a Lotline adjustment.

I certify that I have surveyed the above described property and that the above map is a true representation thereof, and shows the size and location of the property, it's exterior boundaries, the location of all visible structures and dimensions of all principal buildings thereon, boundary fences, appearant easements, roadways, and visible encroachments, if any, to the best of my knowledge and belief.

This survey is made for the present owner of the property and also those who purchase, mortgage, or guarantee the title thereto within 1 year from the date hereon.

James F. Biagi
Feb. 24, 1996

WISCONSIN
JAMES F. BIAGI
MILWAUKEE, WIS.
LAND SURVEYOR

LOT-72
316-879