

LAND-MARK SURVEYING

Mark L. Miritz

Wisconsin Professional Land Surveyor S-2582


N9330 Knuteson Drive
Whitewater, WI 53190
Phone: (262) 495-3284
MARKMIRITZ@
LAND-MARKSURVEYING.COM

OWNERS:
ANDREW W. FERGUSON
JOANN L. FERGUSON
N5944 LAKEVIEW DRIVE
ELKHORN, WI 53121

PLAT OF SURVEY

LOT 14 OF EVERGREEN ESTATES, LOCATED
IN THE NORTHWEST 1/4 OF SECTION 19,
TOWN 3 NORTH, RANGE 17 EAST, TOWN
OF LAFAYETTE, WALWORTH COUNTY,
WISCONSIN

LAKEVIEW DRIVE
(66' WIDE)

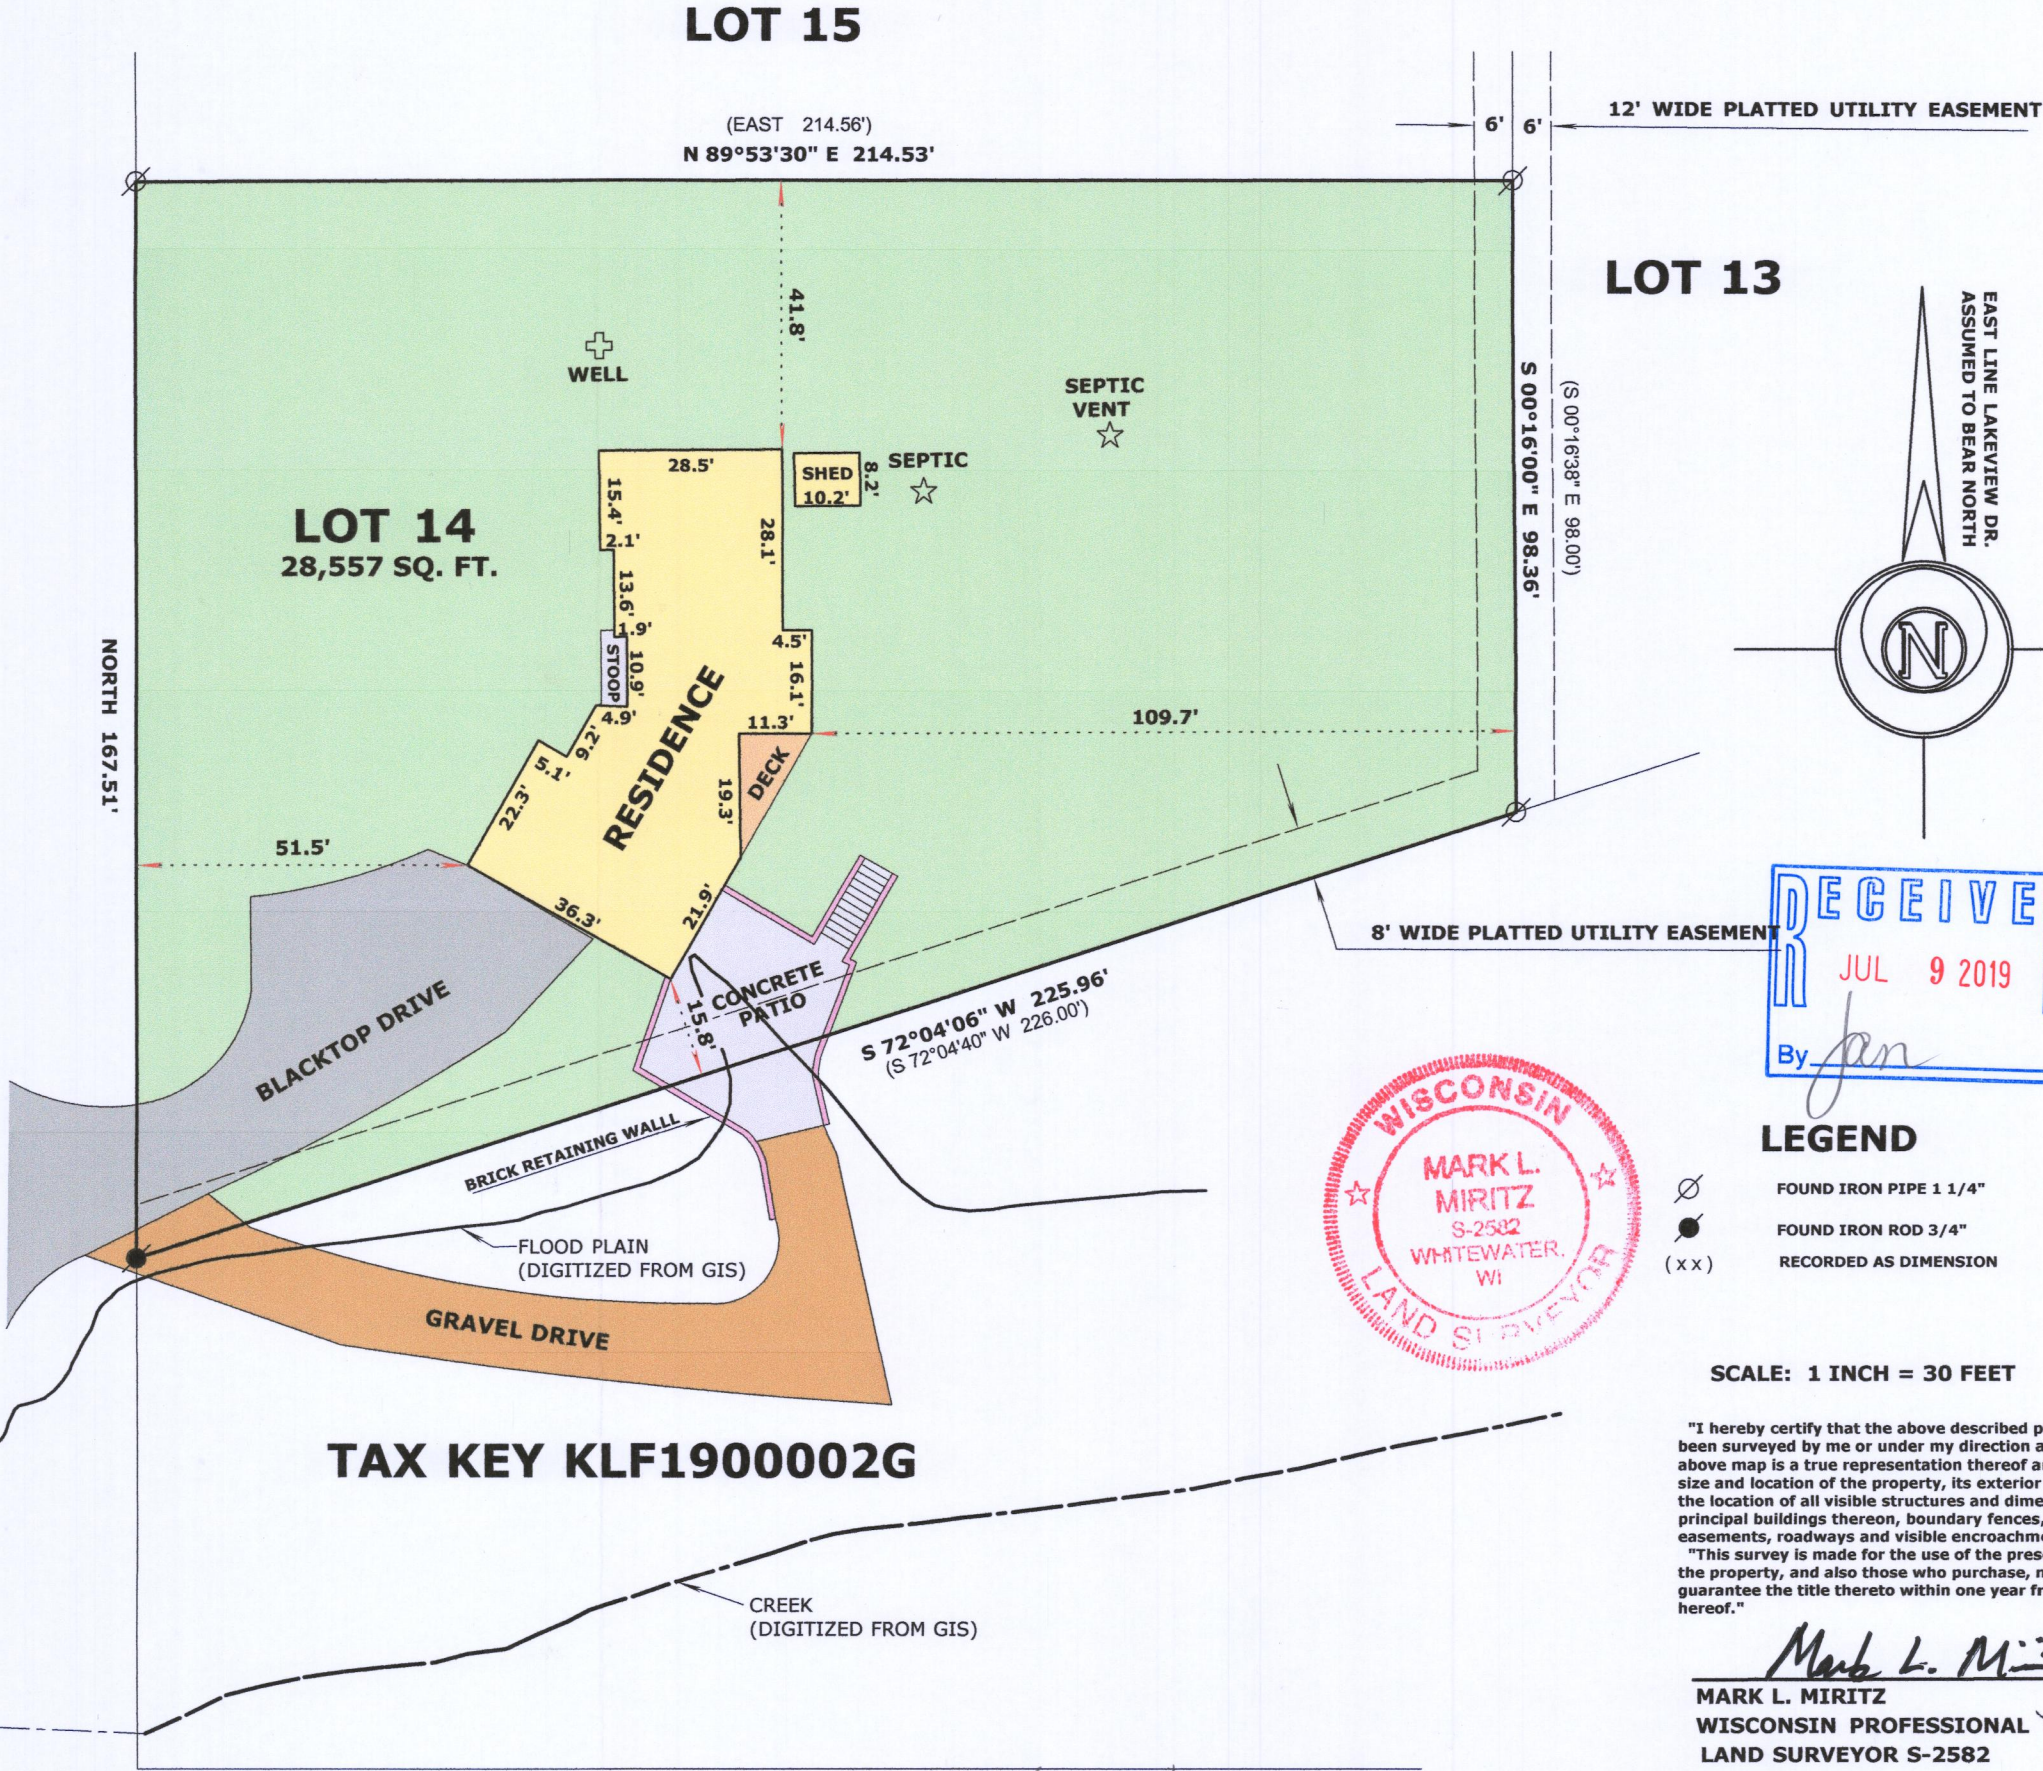

"I hereby certify that the above described property has been surveyed by me or under my direction and that the above map is a true representation thereof and shows the size and location of the property, its exterior boundaries, the location of all visible structures and dimensions of all principal buildings thereon, boundary fences, apparent easements, roadways and visible encroachments, if any."
"This survey is made for the use of the present owners of the property, and also those who purchase, mortgage, or guarantee the title thereto within one year from date hereof."

KE-14 317-1098