



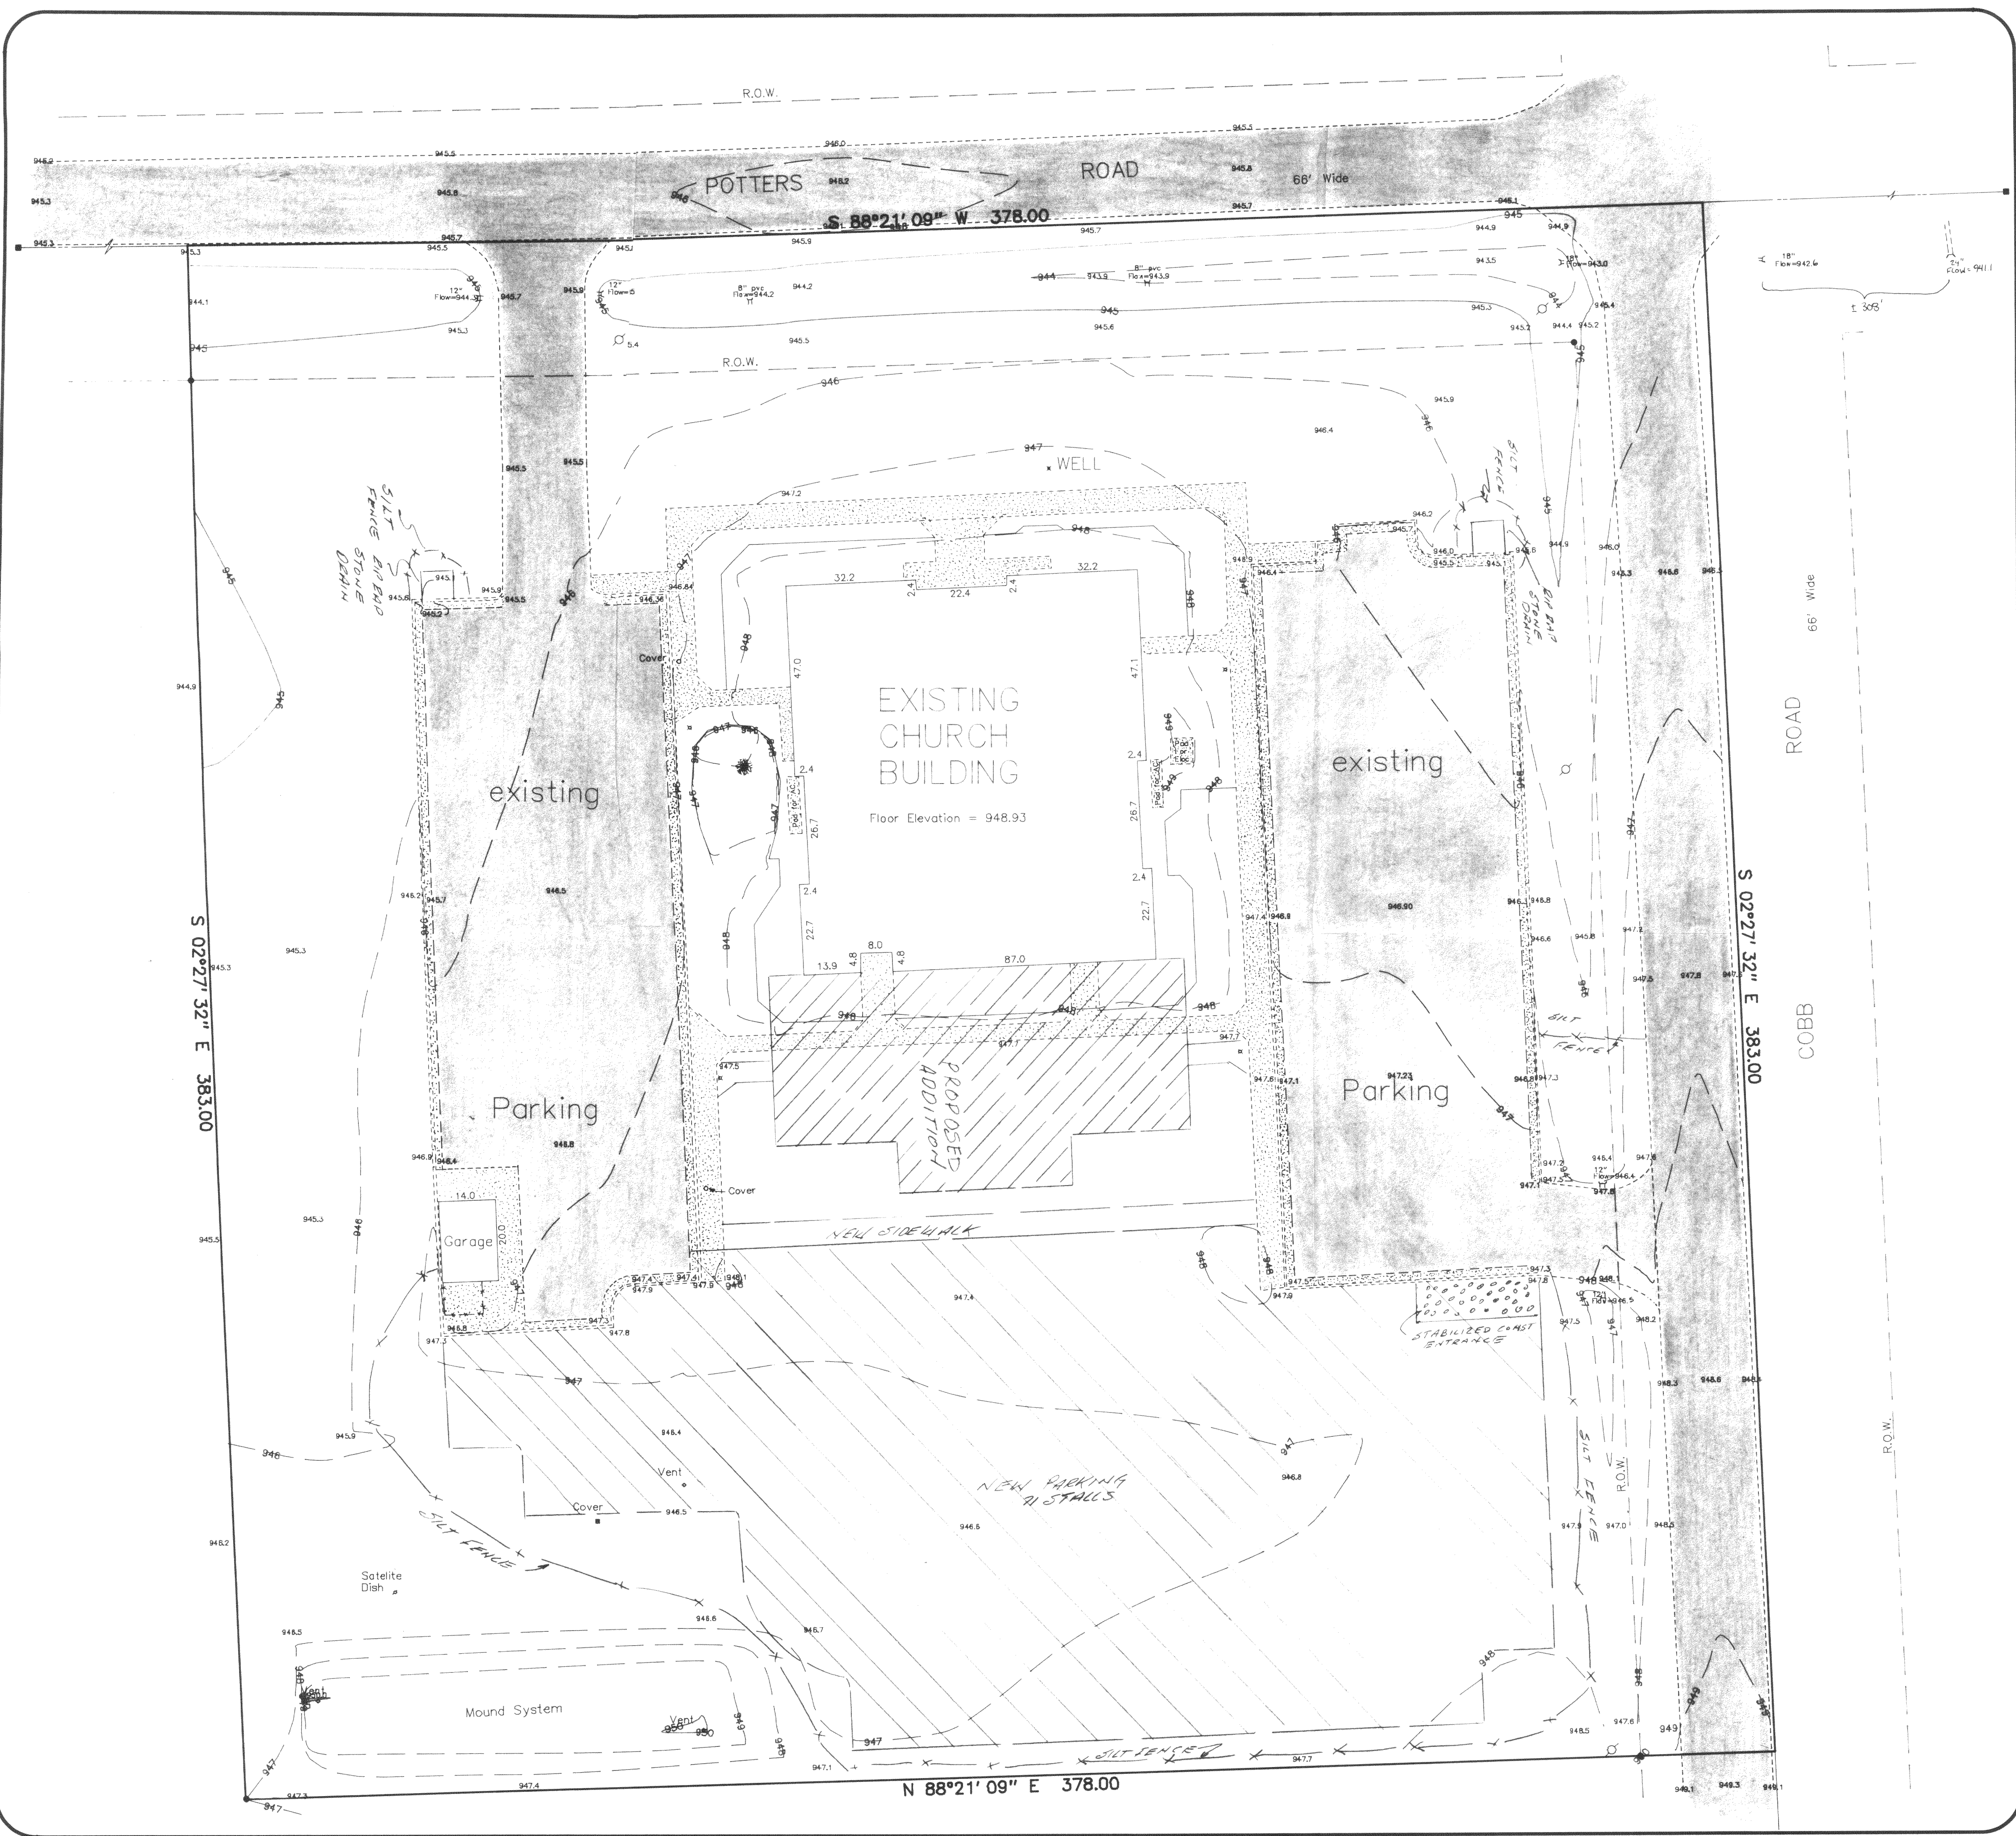

PLAT OF SURVEY

Lot 1 of Certified Survey Map No. 2103, located in the Northwest 1/4 of the Southeast 1/4 of Section 19, Town 3 North, Range 17 East, Town of Lafayette, Walworth County, Wisconsin.

Ordered by: Harold Pann @
Larson & Darby, Inc.
1322 East State P.O. Box 4344
Rockford, IL 61110-0844

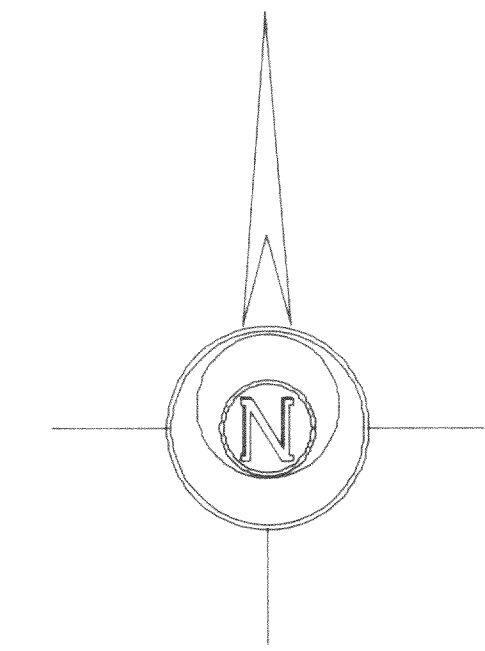

Bearings referenced to the Wisconsin State Plane Coordinate System, South Zone.

Elevations referenced to Benchmark B as shown on survey dated 5-24-91 described as 60p. spike in SE face of 42" Oak
Elevation = 947.70.

JENSEN SURVEYING & MAPPING S.C.


45 South Wisconsin Street P.O. Box 322
Elkhorn, Wisconsin. 53121
Telephone & Facsimile (414) 723-3434

Mapping date: January 17, 1993.


Revisions:

Legend

- Found County Section Corner
- Found Iron rod 3/4"
- Blacktop Surface
- Concrete Surface
- Utility Pole
- Light Pole
- SILT FENCE

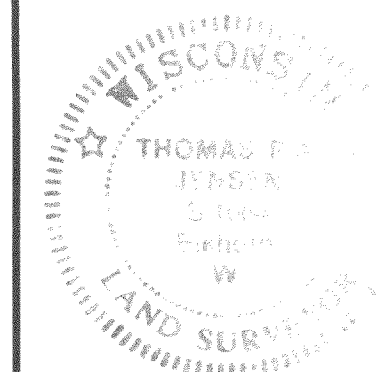

Scale: 1" = 20'

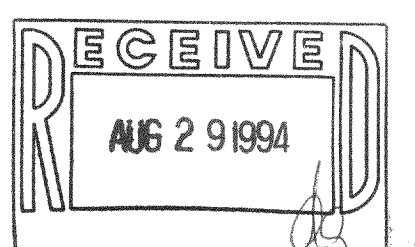

Copyright © 1994 by Jensen Surveying & Mapping S.C.

All rights reserved. No part of this survey plat may be reproduced or transmitted in any form by any means - graphic, electronic, or mechanical, including photocopying, tracing, or information storage and retrieval systems - without permission in writing from Thomas P.A. Jensen, Jensen Surveying & Mapping S.C..

I, Thomas P.A. Jensen, Wisconsin Registered Land Surveyor, do hereby certify that this survey was performed by me, or under my direction in full compliance with the owner's / agent's instructions and Chapter A-E 7 of the Wisconsin Administrative Code "Minimum Standards for Property Surveys"; and that this map is an accurate representation thereof to the best of my knowledge and belief.

Thomas P.A. Jensen R.L.S. 1084

Sheet no. 1 of 1 Sheets

Job Reference Number: 1993.153