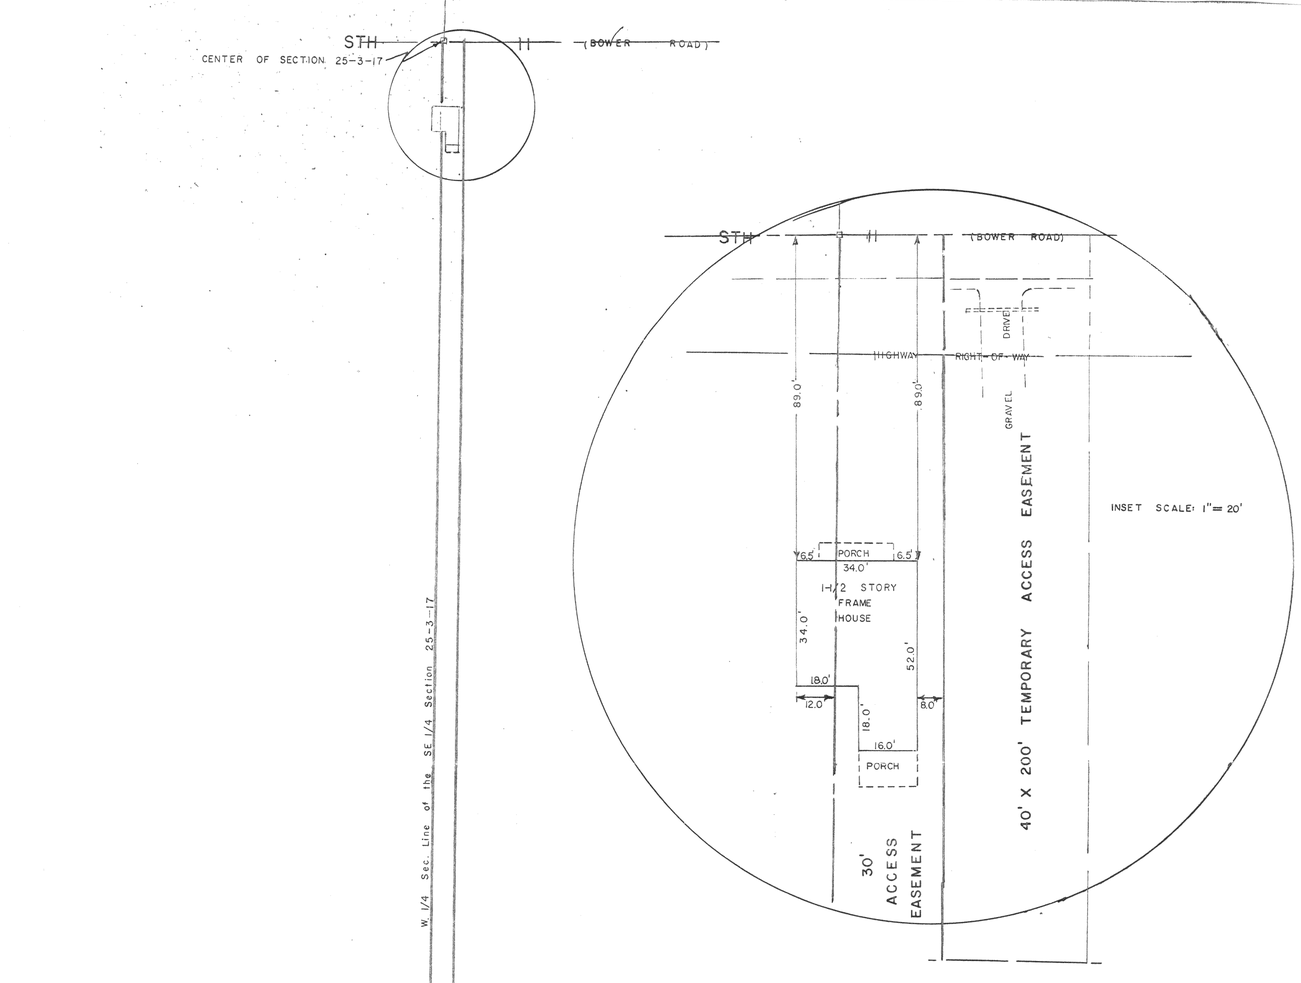

I HEREBY CERTIFY THAT I HAVE SURVEYED THE DESCRIBED PROPERTY AND THAT THE MAP SHOWN HEREON IS A CORRECT REPRESENTATION THEREOF AND SHOWS THE SIZE AND LOCATION OF THE PROPERTY, ITS EXTERIOR BOUNDARIES, THE LOCATION OF ALL VISIBLE STRUCTURES AND DIMENSIONS OF ALL PRINCIPAL BUILDINGS THEREON, APPARENT EASEMENTS, ROADWAYS, AND ENCROACHMENTS, IF ANY.

THIS SURVEY IS MADE FOR THE USE OF THE PRESENT OWNERS OF THE PROPERTY, AND THOSE WHO PURCHASE, MORTGAGE OR GUARANTEE THE TITLE THERETO WITHIN ONE YEAR FROM DATE HEREOF.

WISCONSIN LAND SURVEYOR

Clarence M. Zellner
CLARENCE M. ZELLNER REG. NO. S-482

January 31, 1995
DATE

QUALITY CONSULTING SERVICES, INC.
"Quality engineering is the cornerstone of our business"
6502 Grand Teton Plaza
Madison, Wisconsin 53719
9415 W. Forest Home Avenue Suite 303
Hales Corners, Wisconsin 53130
MADISON • MILWAUKEE

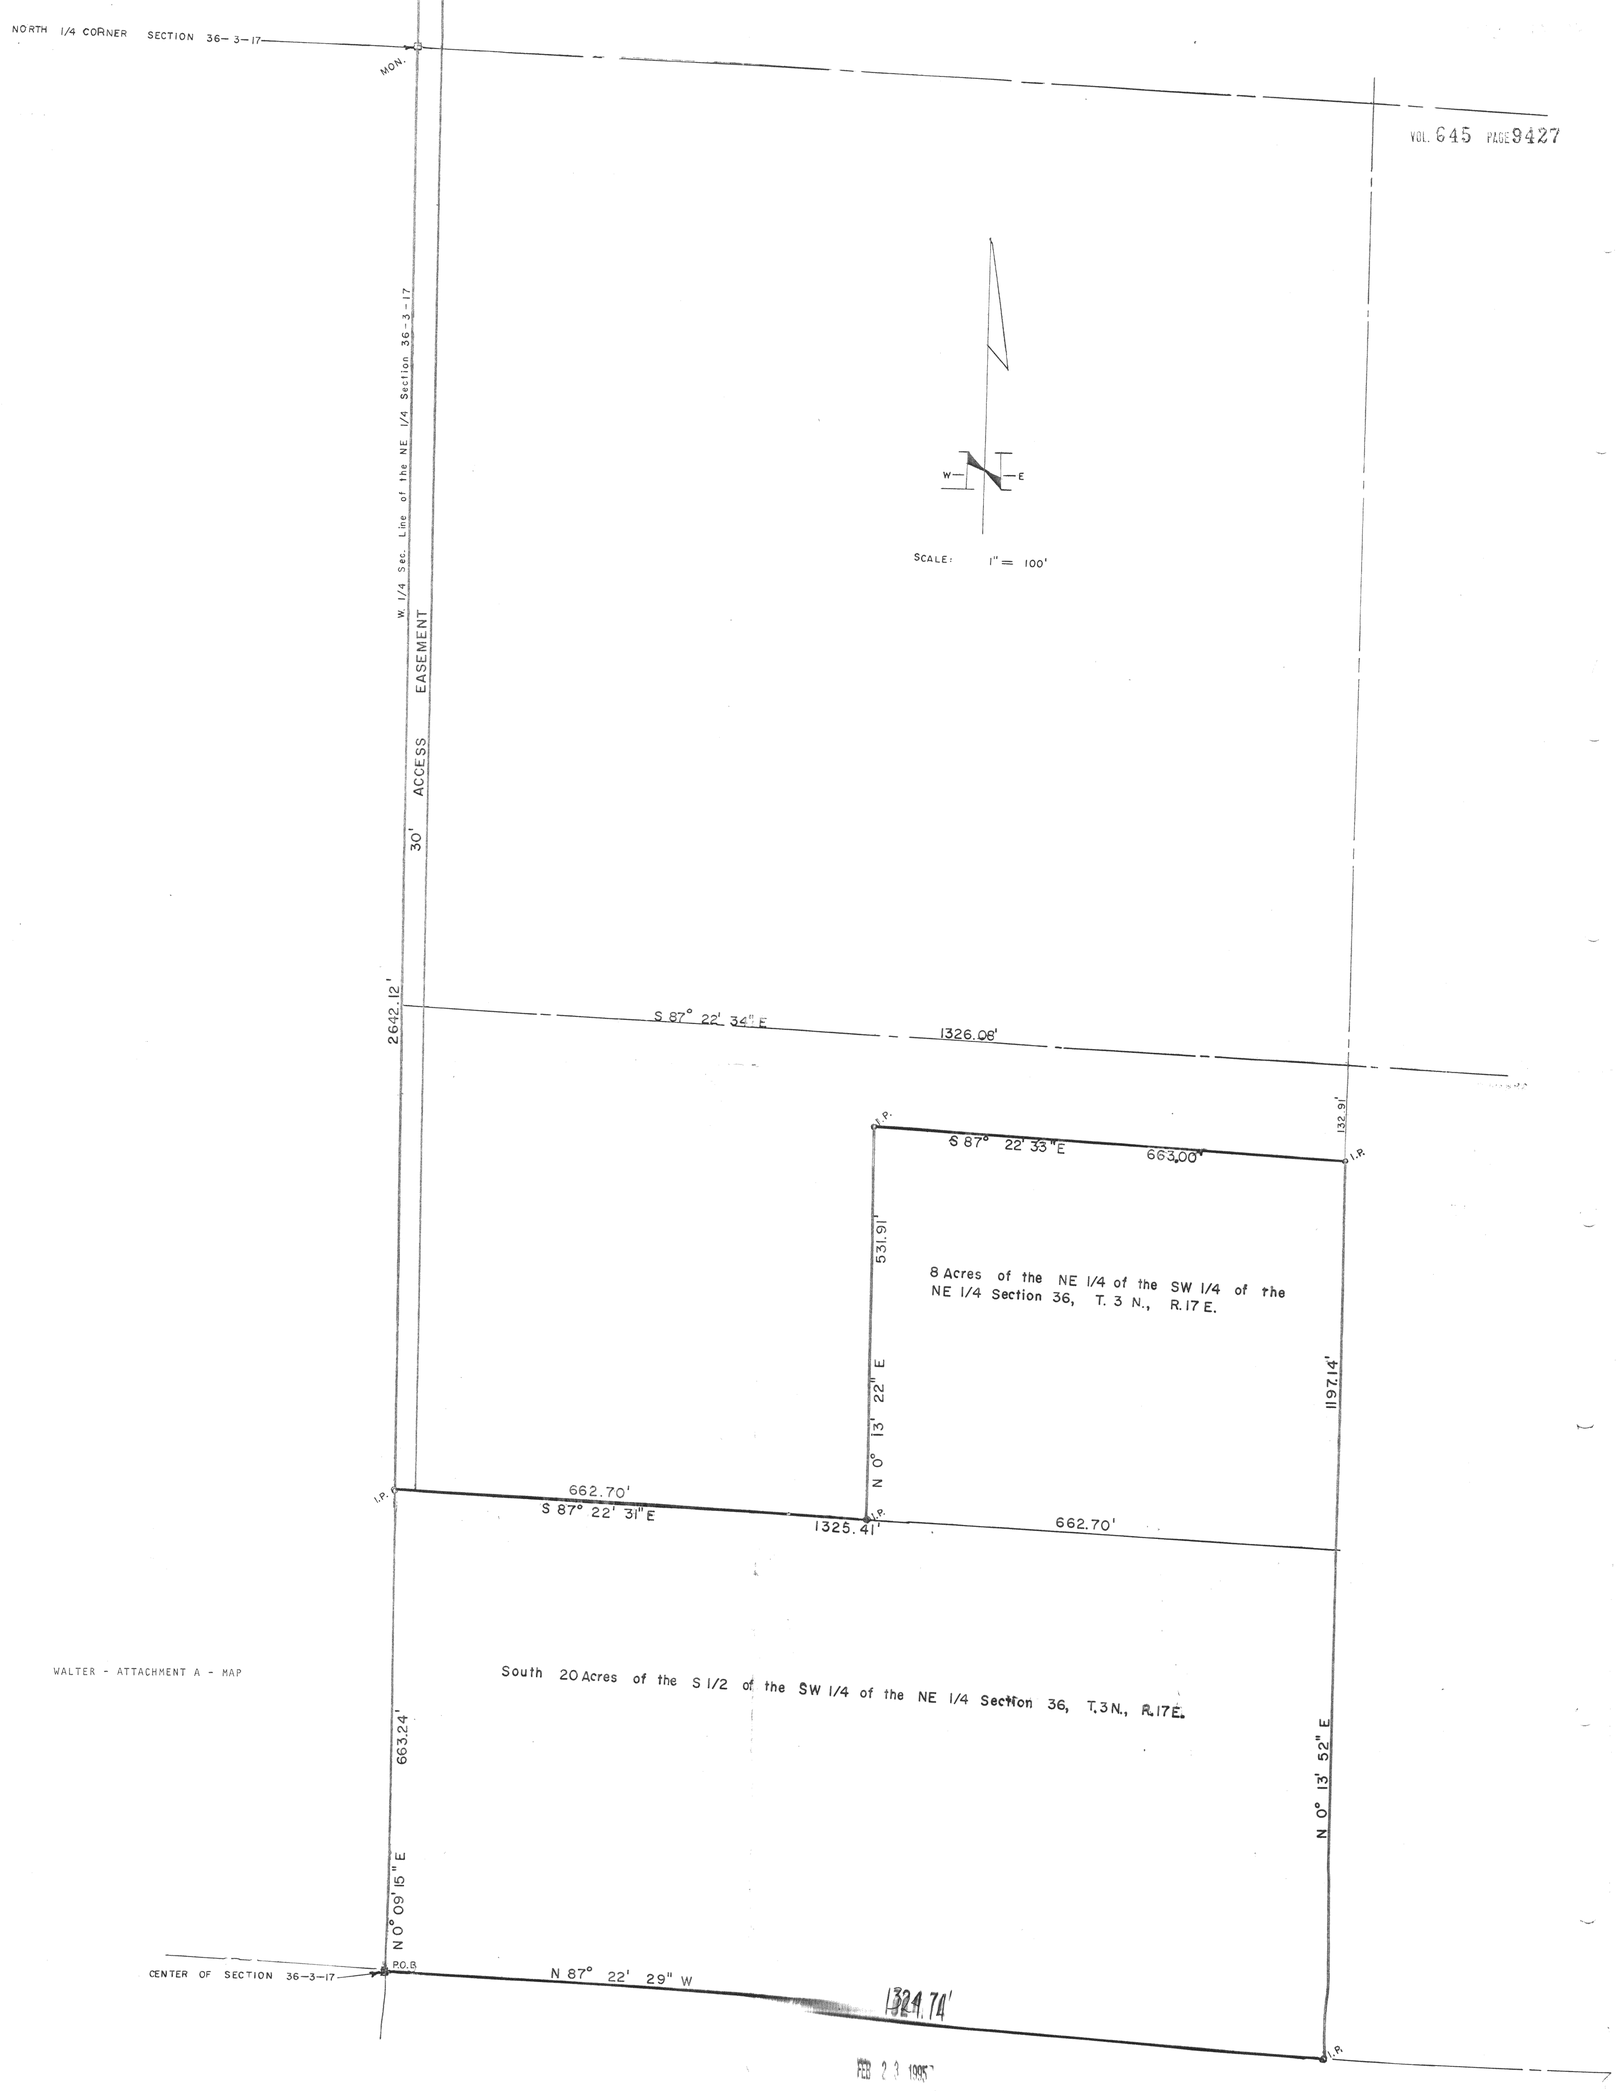

WALTER - ATTACHMENT A - MAP

KLF -36-2
KLF - 25 - 7
KA - 2746-1

RECEIVED MAR 3

FEB 23 1995

317-394