PREPARED FOR:
RAULAND AGENCY INC
118 KENOSHA ST.
P.O. BOX 159
WALWORTH, WI
53184

PLAT OF SURVEY

- OF -

LOT 1 CERTIFIED SURVEY MAP NO. 114 LOCATED IN THE SOUTHWEST 1/4 OF SECTION 12, TOWN 3 NORTH, RANGE 17 EAST, WALWORTH COUNTY, WISCONSIN.

J.K. SURVEYING INC.
N3705 WILLOWBEND LANE
LAKE GENEVA, WI, 53147
262-248-3697

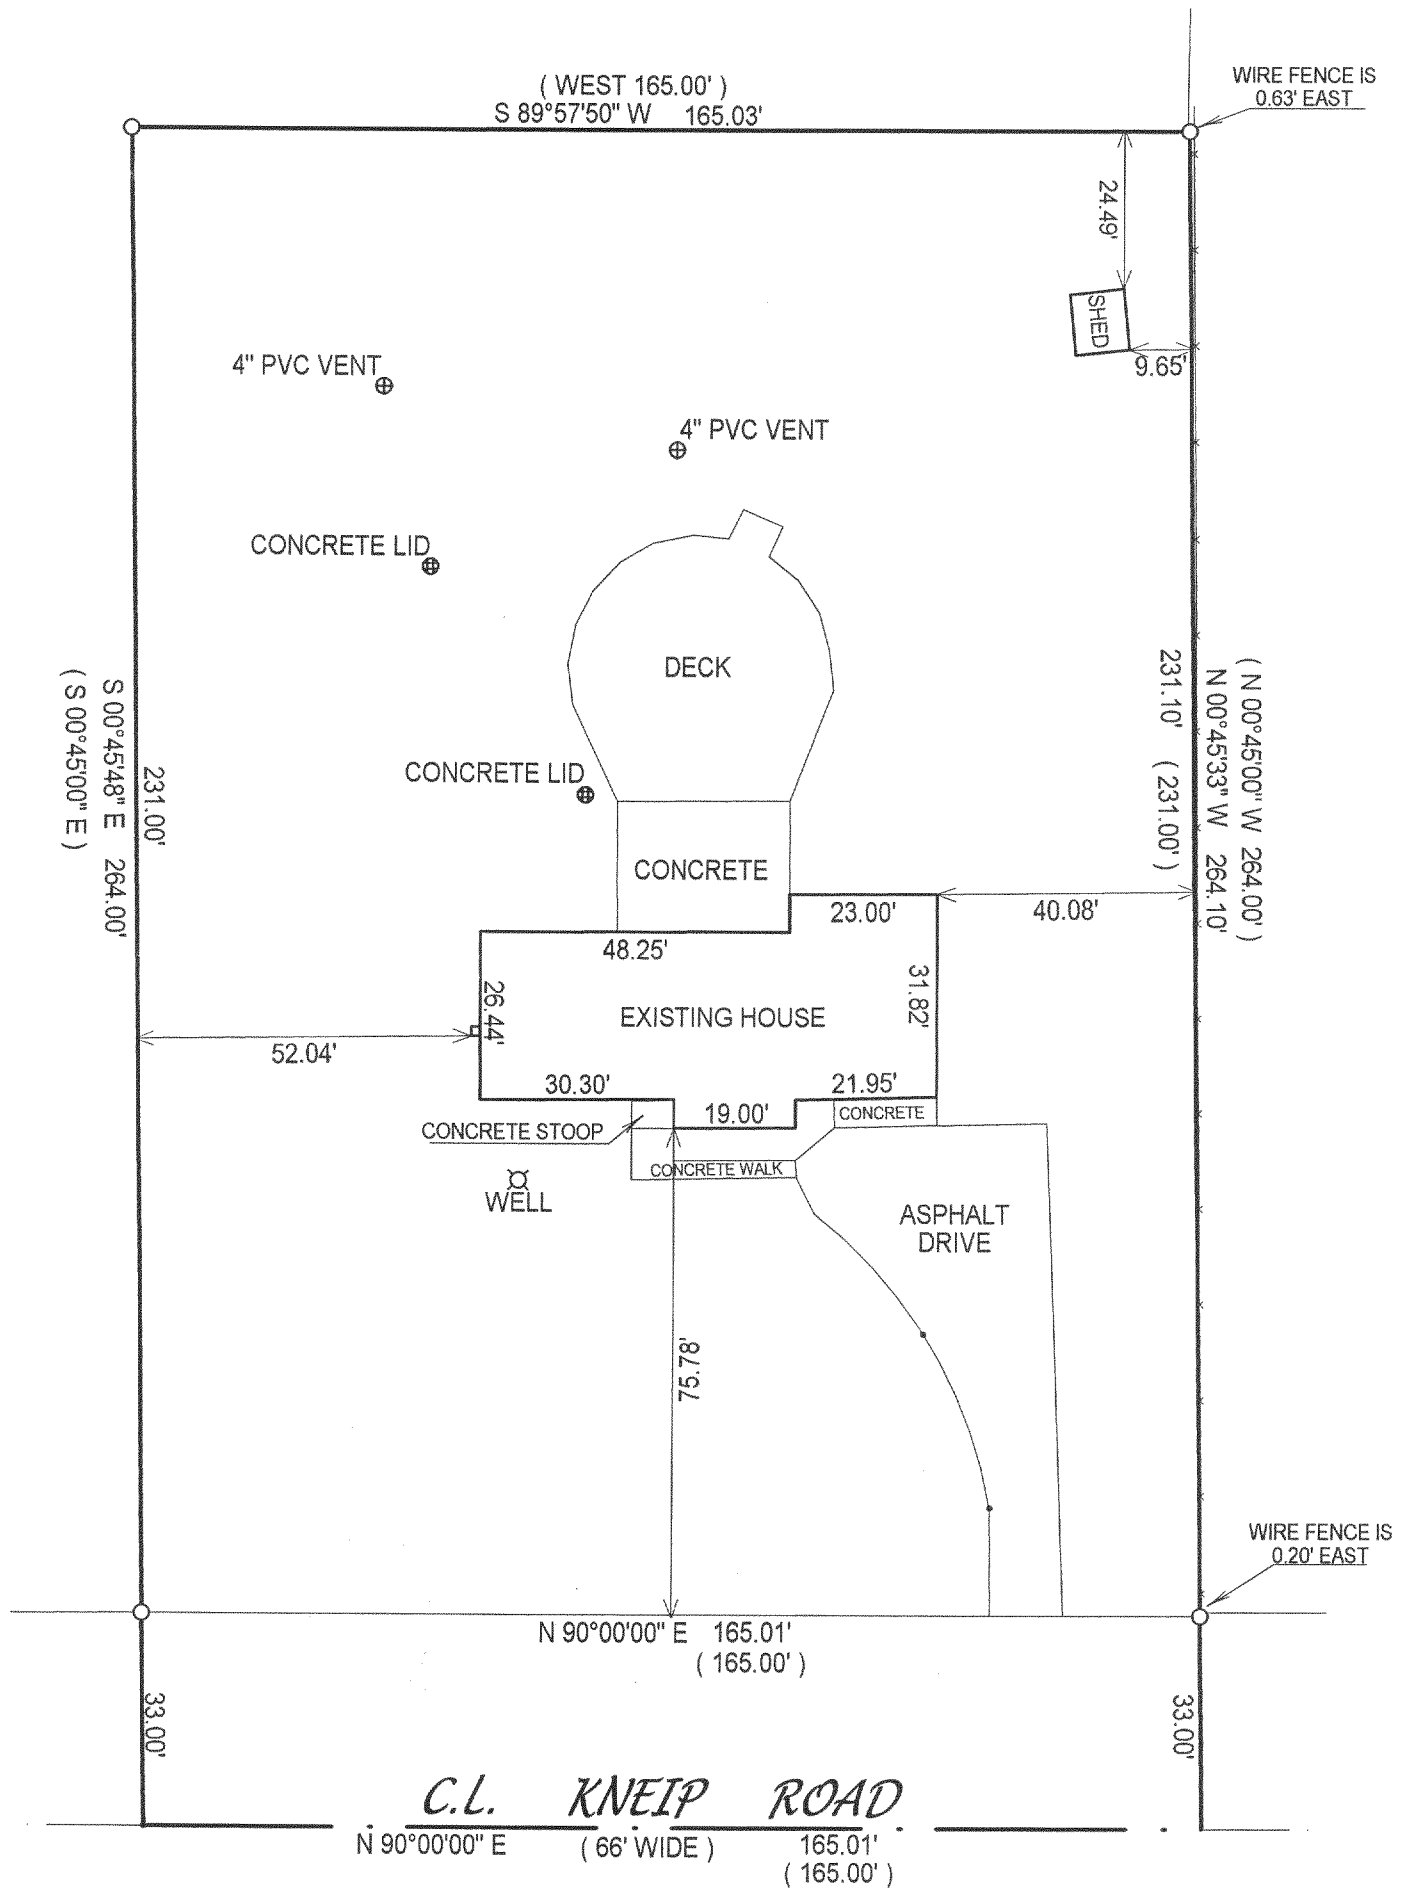

( )= recorded as

□ = found iron bar

○ = found iron pipe

● = set iron pipe

■ = set iron bar

SCALE 1" = 30'

JOB # 03-469

TAX ID # KA11400001

ORP

COMPARE LEGAL DESCRIPTION ABOVE AND DRAWING WITH DEED. FOR BUILDING RESTRICTIONS AND EASEMENTS NOT SHOWN,REFER TO DEED, ABSTRACT SOURCES AND LOCAL MUNICIPAL CODES. NOTIFY THE SURVEYOR IMMEDIATELY OF ANY DISCREPANCY.

"I hereby certify that I have surveyed the above described property and that the above map is a true representation thereof and shows the size and location of all visible structures, apparent easements and encroachments if any."
This survey is made for the present owners of the property, and those who purchase, mortgage, or guarantee the title thereto, within one year from the date hereof.

WISCONSIN
JEFFERY L. KIMPS
2436
LAKE GENEVA, WIS.
LAND SURVEYOR

JEFFREY L. KIMPS S - 2436
Wisconsin Registered Land Surveyor
(original if signed in red)
DATED THIS THE 5th DAY OF AUGUST 2003.

317-606