

Property Exhibit

of

Lot 1 of Certified Survey Map No. 4574,


recorded in Vol. 30 of Certified Survey Maps of Walworth County on Page 67 and located in the Southwest 1/4 of Section 21, Town 3 North, Range 17 East, Town of LaFayette, Walworth County, Wisconsin.

and



A Portion of Tax Parcel KLF 2100007,

located in the Northwest 1/4 of the Southwest 1/4 of Section 21, Town 3 North, Range 17 East, Town of LaFayette, Walworth County, Wisconsin.

Surveyed for: **Kevin Robers**
W4050 State Highway 11
Elkhorn, Wisconsin. 53121

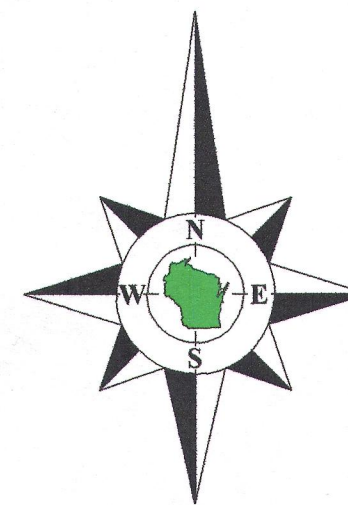

Bearings reference to the Wisconsin State Plane Coordinate System, South Zone.

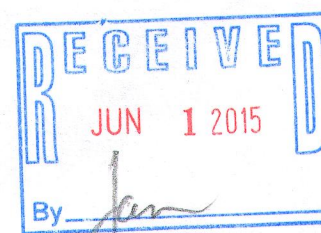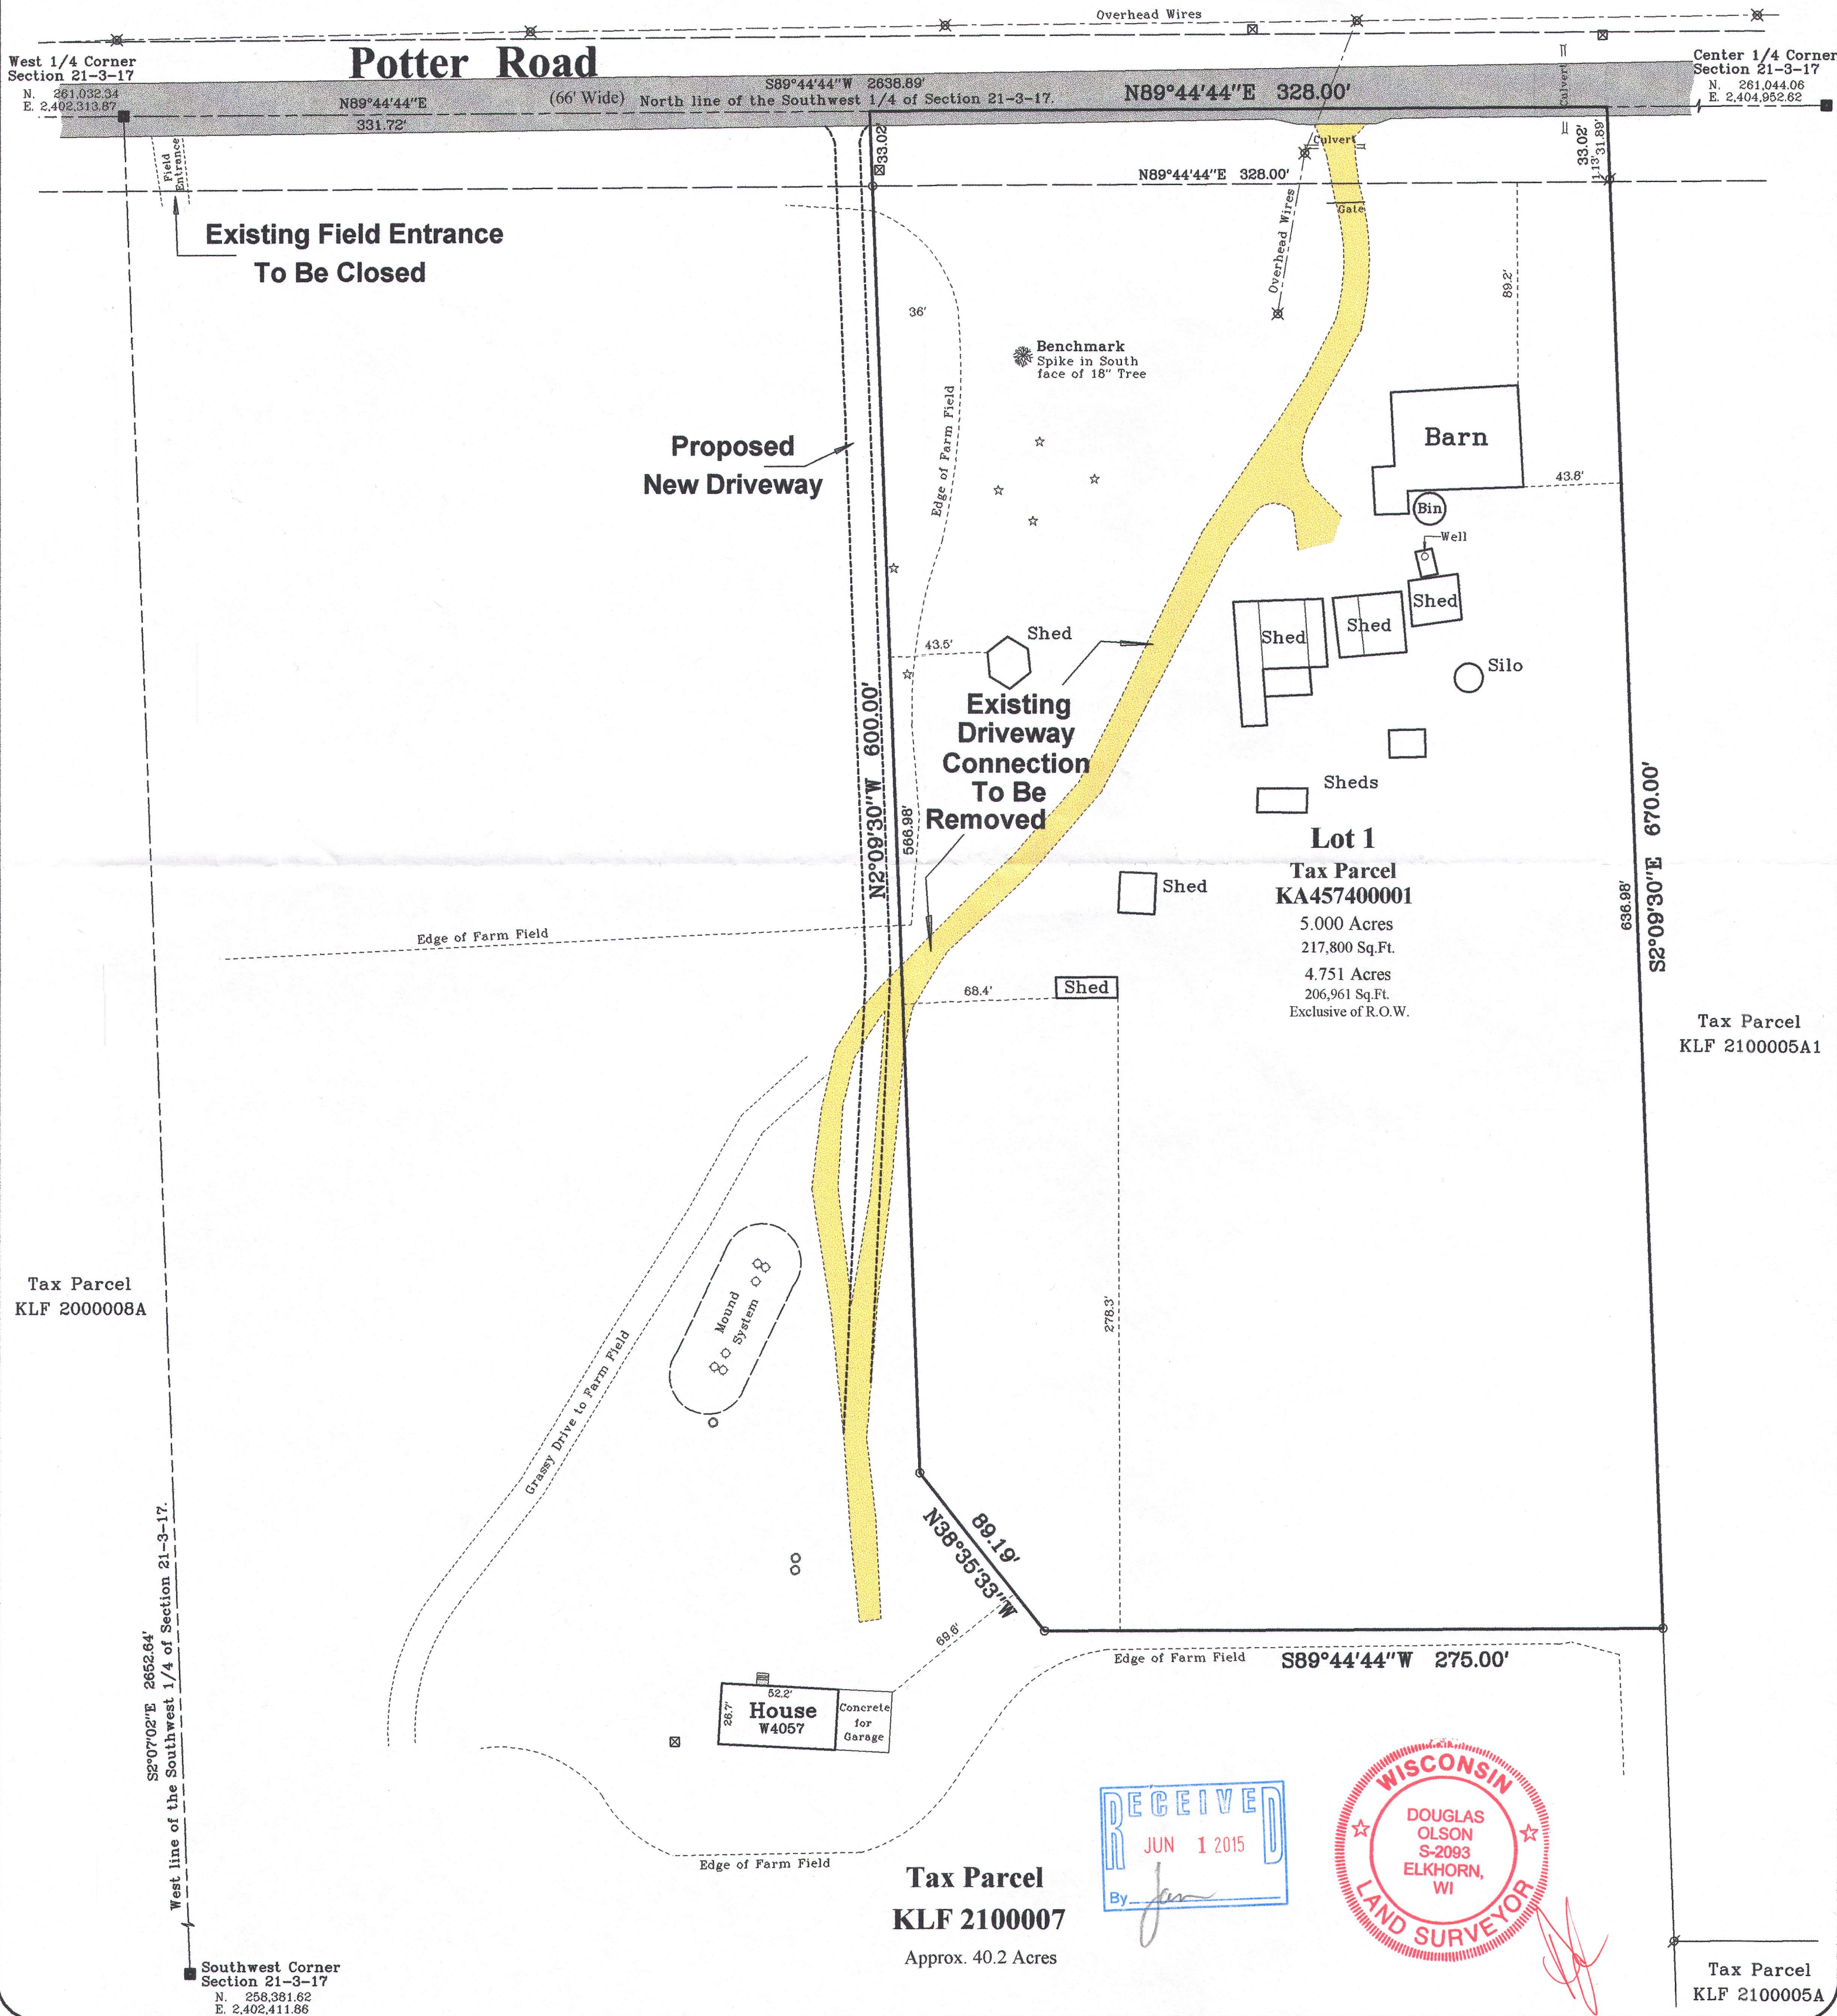


Tax Parcel
KLF 2000008A

Tax Parcel
KLF 2100007
Approx. 40.2 Acres

Tax Parcel
KLF 2100005A1

Tax Parcel
KLF 2100005A

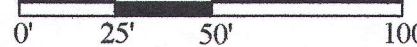2014.059	Sheet 1 of 1 Sheets	 Jensen & Olson Land Surveying, LLC 45 South Wisconsin Street * P.O. Box 322 * Elkhorn, Wisconsin. 53121 Telephone: (262) 723-3434 * Facsimile: (262) 723-8044 Email: jensen.olson@elknet.net	Scale in Feet 1" = 50' 	Survey Date: July 31, 2014. Revisions: No. 1 - Proposed Driveway No. 2 - Soil Borings No. 3 - Recorded CSM
	Drawing Name:			
	Job Reference Number			
	2014.059			
Legend - Found County Section Corner - Found Iron Pipe - Set Iron Pipe, 1" dia. - Recorded Information - Utility Pole - Soil Boring - Utility Box or Pedestal - Concrete Cover - Septic Vent - Asphalt Surface - Concrete Surface - Gravel				

KLF21-7

KA4574-1

312-994