

LAND-MARK SURVEYING

Mark L. Miritz

Wisconsin Professional Land Surveyor S-2582

N9330 Knuteson Drive
Whitewater, WI 53190
Phone: (262) 495-3284
MARKMIRITZ@
LAND-MARKSURVEYING.COM


PLAT OF SURVEY

LEGAL DESCRIPTION:

IN THE NORTHWEST 1/4, OF THE SOUTHEAST 1/4, SECTION 6,
TOWNSHIP 3 NORTH, RANGE 17, IN THE TOWN OF LAFAYETTE,
WALWORTH COUNTY, WISCONSIN:

LOT 1, CERTIFIED SURVEY MAP No. 3132

OWNER: JEFFERY S. HAGELI
N7024 HODGES ROAD
ELKHORN, WI. 53121

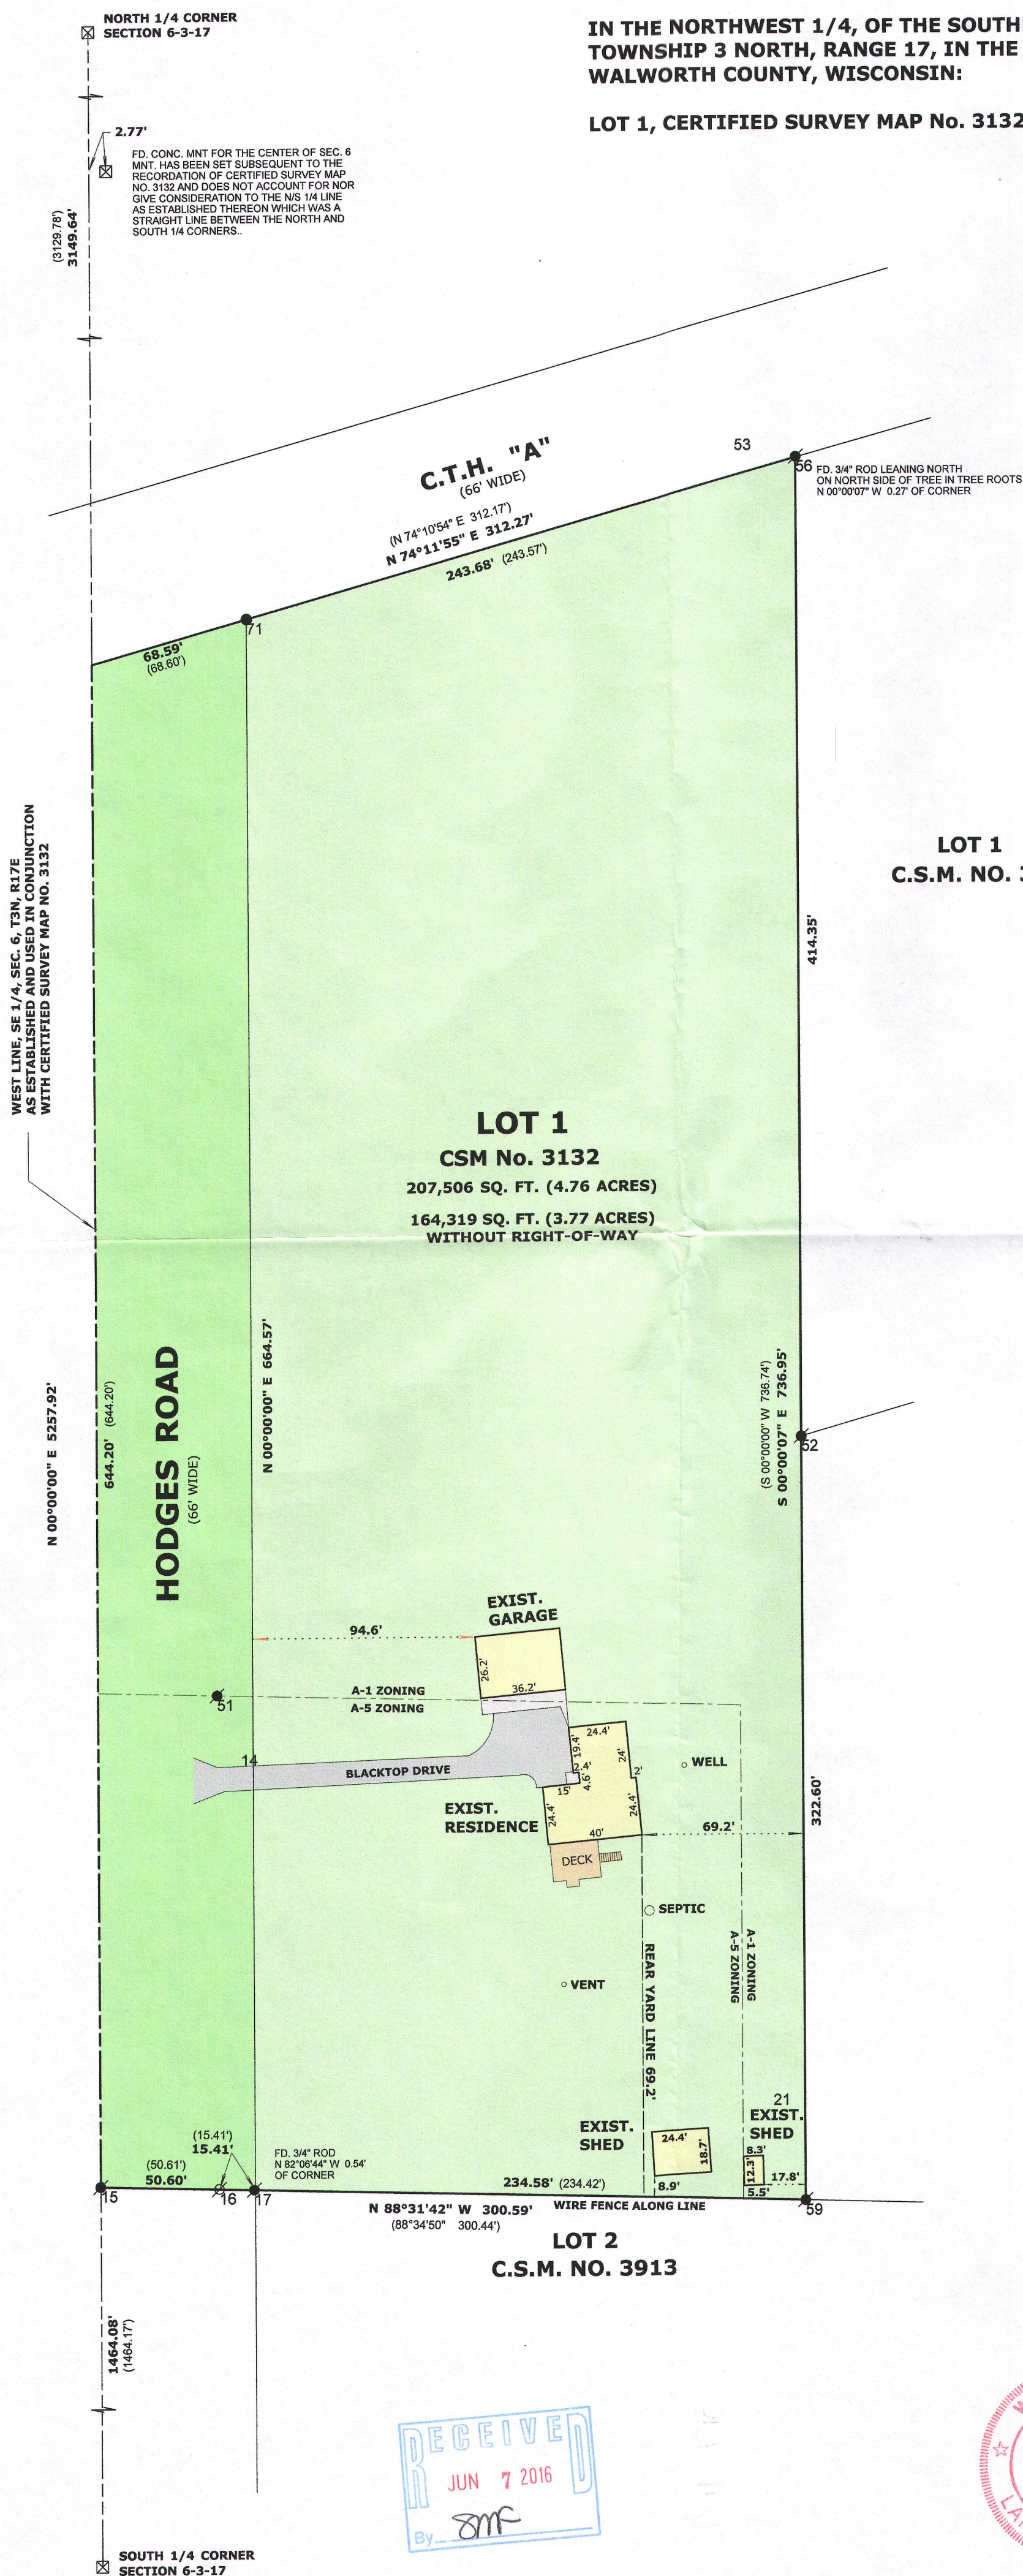

KA3132-1

317-1016