
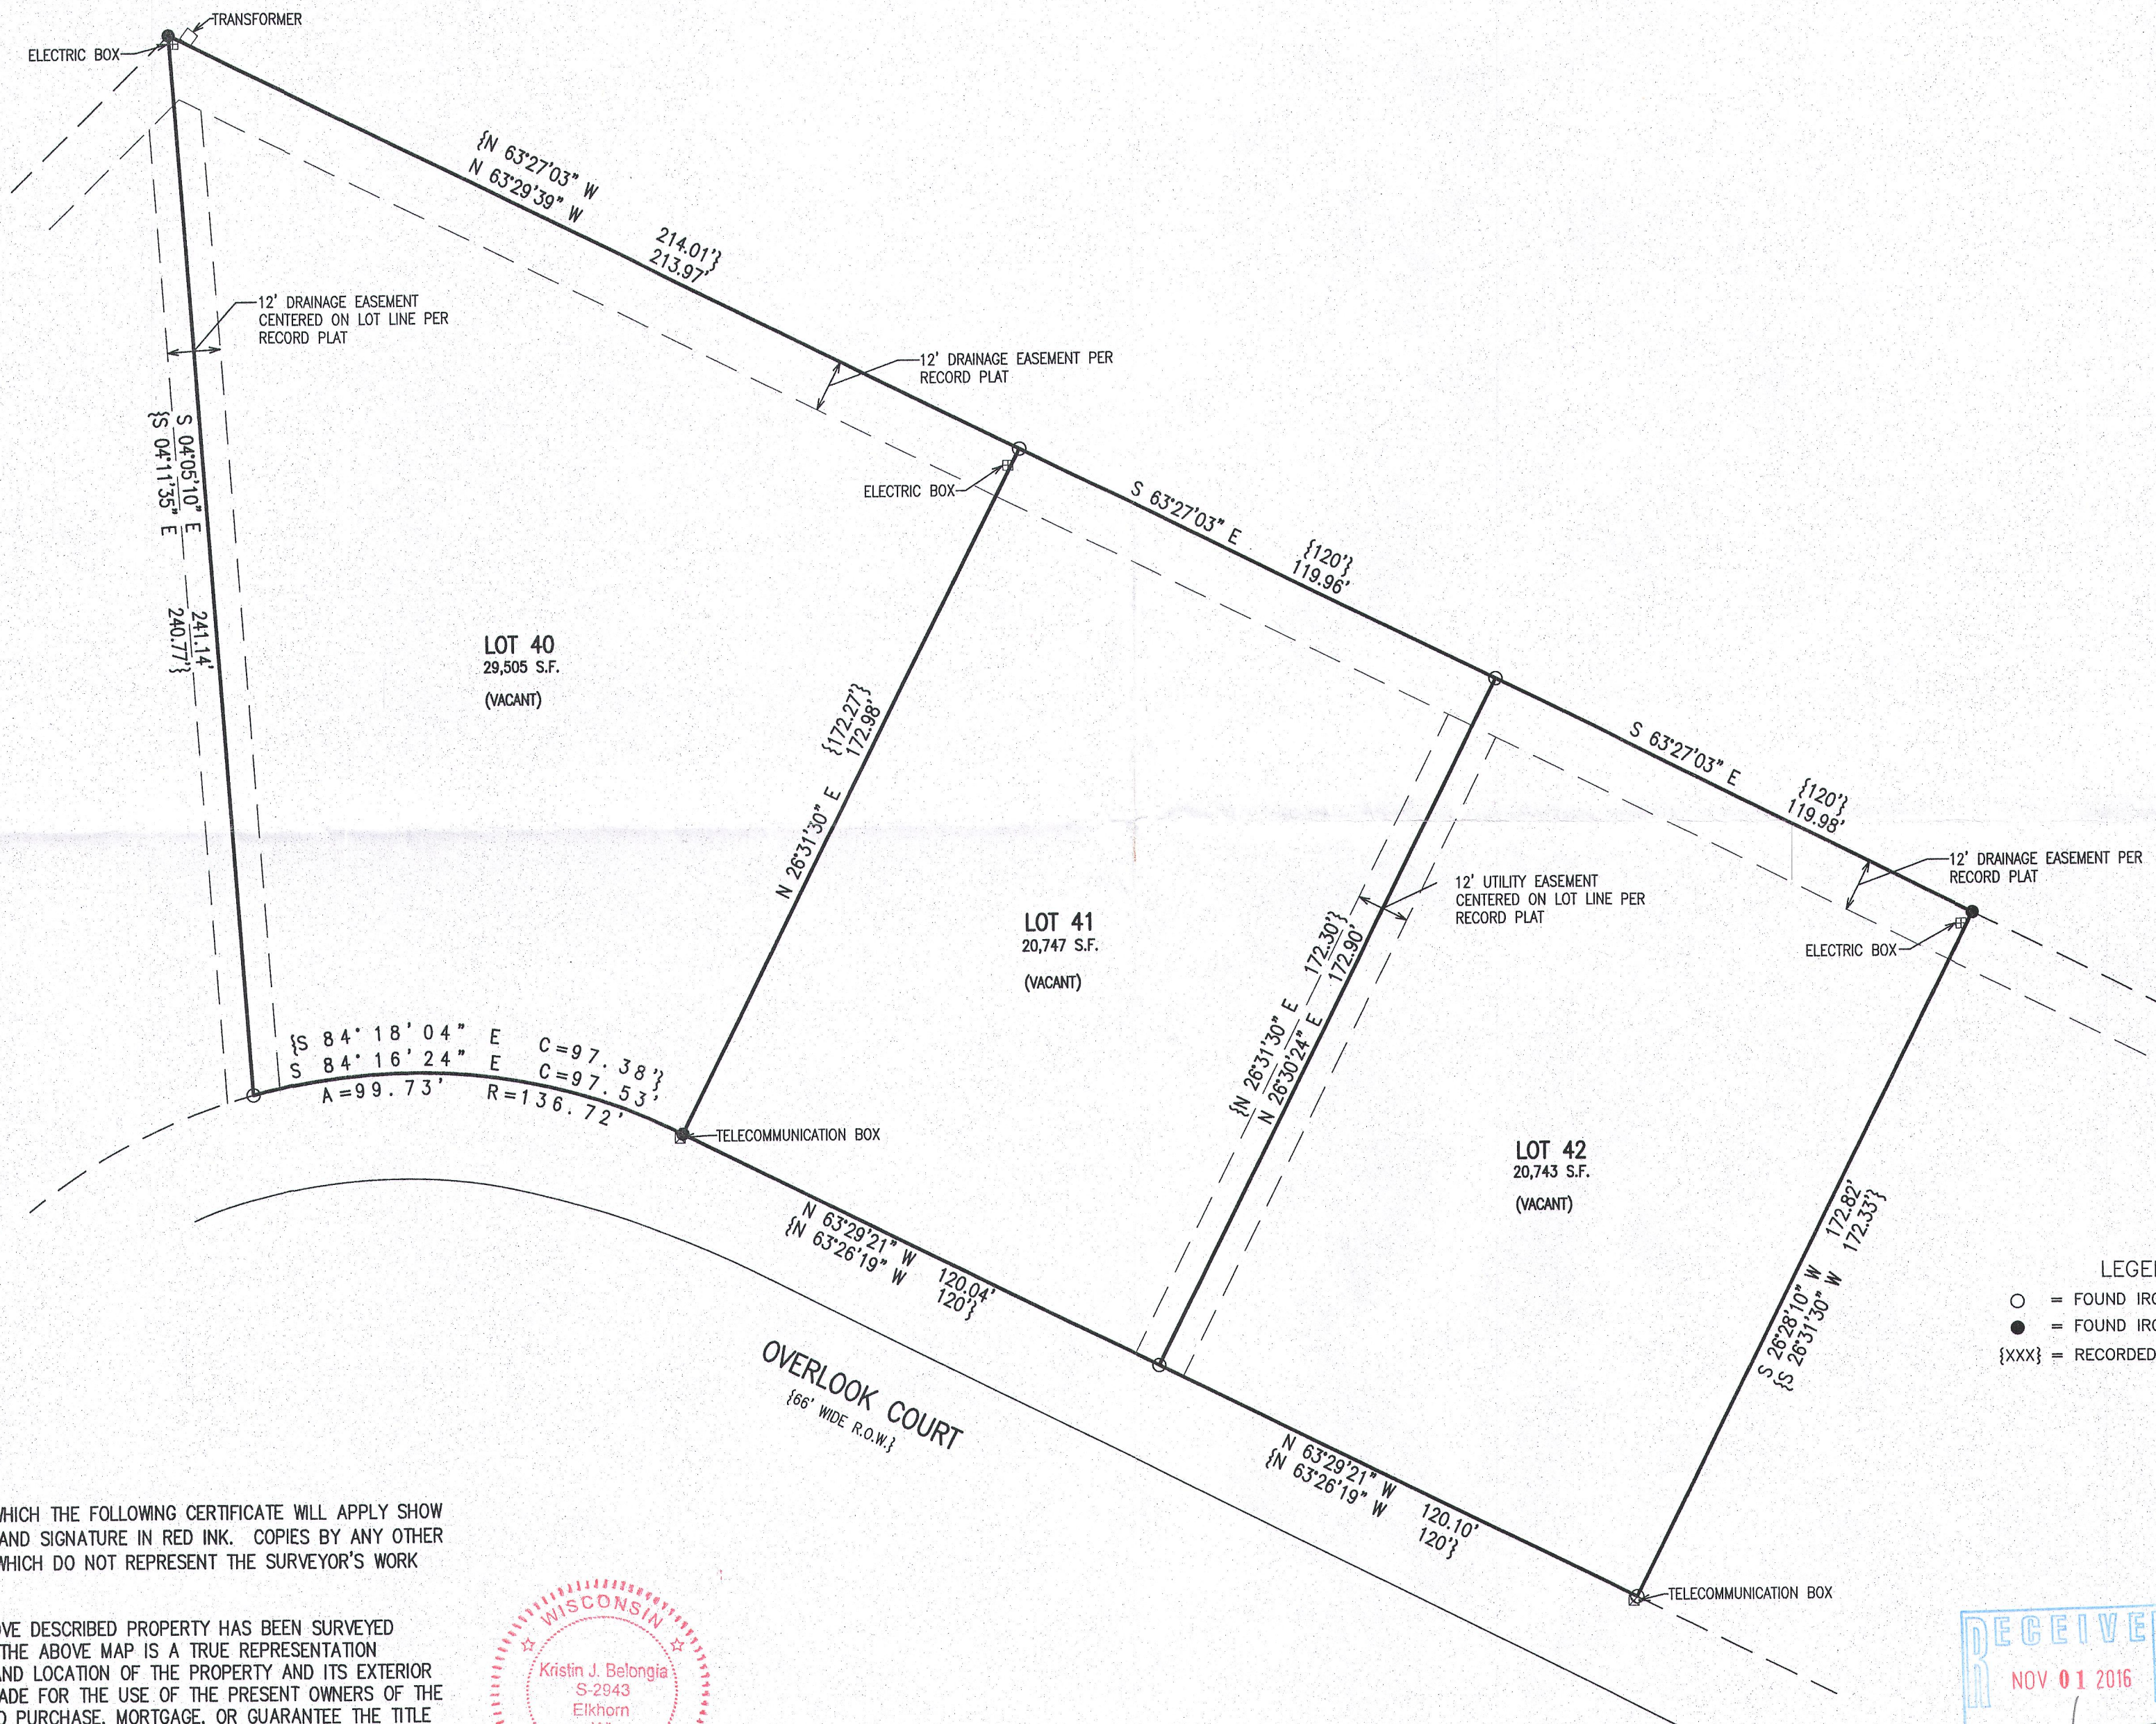


PLAT OF SURVEY LOTS 40, 41 & 42 OF EVERGREEN ESTATES

LOCATED IN PART OF THE NORTHWEST 1/4 OF SECTION 19,
TOWN 3 NORTH, RANGE 17 EAST, WALWORTH COUNTY, WISCONSIN



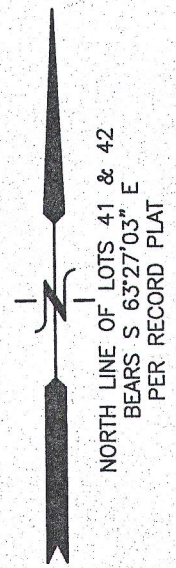


NOTE: COPIES OF THIS MAP TO WHICH THE FOLLOWING CERTIFICATE WILL APPLY SHOW THE SURVEYOR'S ORIGINAL SEAL AND SIGNATURE IN RED INK. COPIES BY ANY OTHER MEANS MAY HAVE ALTERATIONS WHICH DO NOT REPRESENT THE SURVEYOR'S WORK PRODUCT.

I HEREBY CERTIFY THAT THE ABOVE DESCRIBED PROPERTY HAS BEEN SURVEYED UNDER MY DIRECTION AND THAT THE ABOVE MAP IS A TRUE REPRESENTATION THEREOF AND SHOWS THE SIZE AND LOCATION OF THE PROPERTY AND ITS EXTERIOR BOUNDARIES. THIS SURVEY IS MADE FOR THE USE OF THE PRESENT OWNERS OF THE PROPERTY, AND ALSO THOSE WHO PURCHASE, MORTGAGE, OR GUARANTEE THE TITLE THERETO WITHIN ONE YEAR FROM THE DATE HEREOF.

DATED: SEPTEMBER 14, 2016

Kristin Belongia
KRISTIN J. BELONGIA P.L.S. 2943

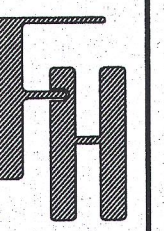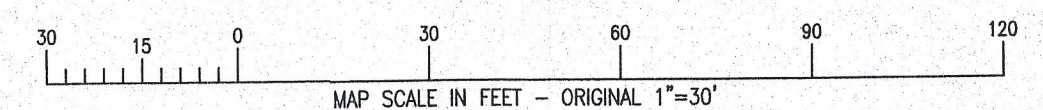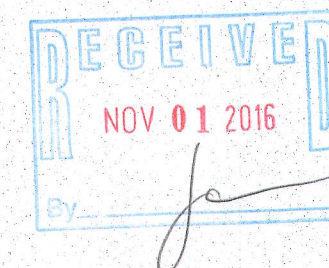

PLAT OF SURVEY

WORK ORDERED BY -
RITA HENEGHAN
1321 WEST CONCORDIA
CHICAGO, IL 60642

FARRIS, HANSEN & ASSOCIATES, INC.
ENGINEERING - ARCHITECTURE - SURVEYING
7 RIDGWAY COURT P.O. BOX 437
ELKHORN, WISCONSIN 53121
OFFICE: (262) 723-2096 FAX: (262) 723-5886

REVISIONS

PROJECT NO.
9603
DATE:
9/21/2016
SHEET NO.
1 OF 1

KE-40 KE-42
KE-41 317-1032