


#121-65

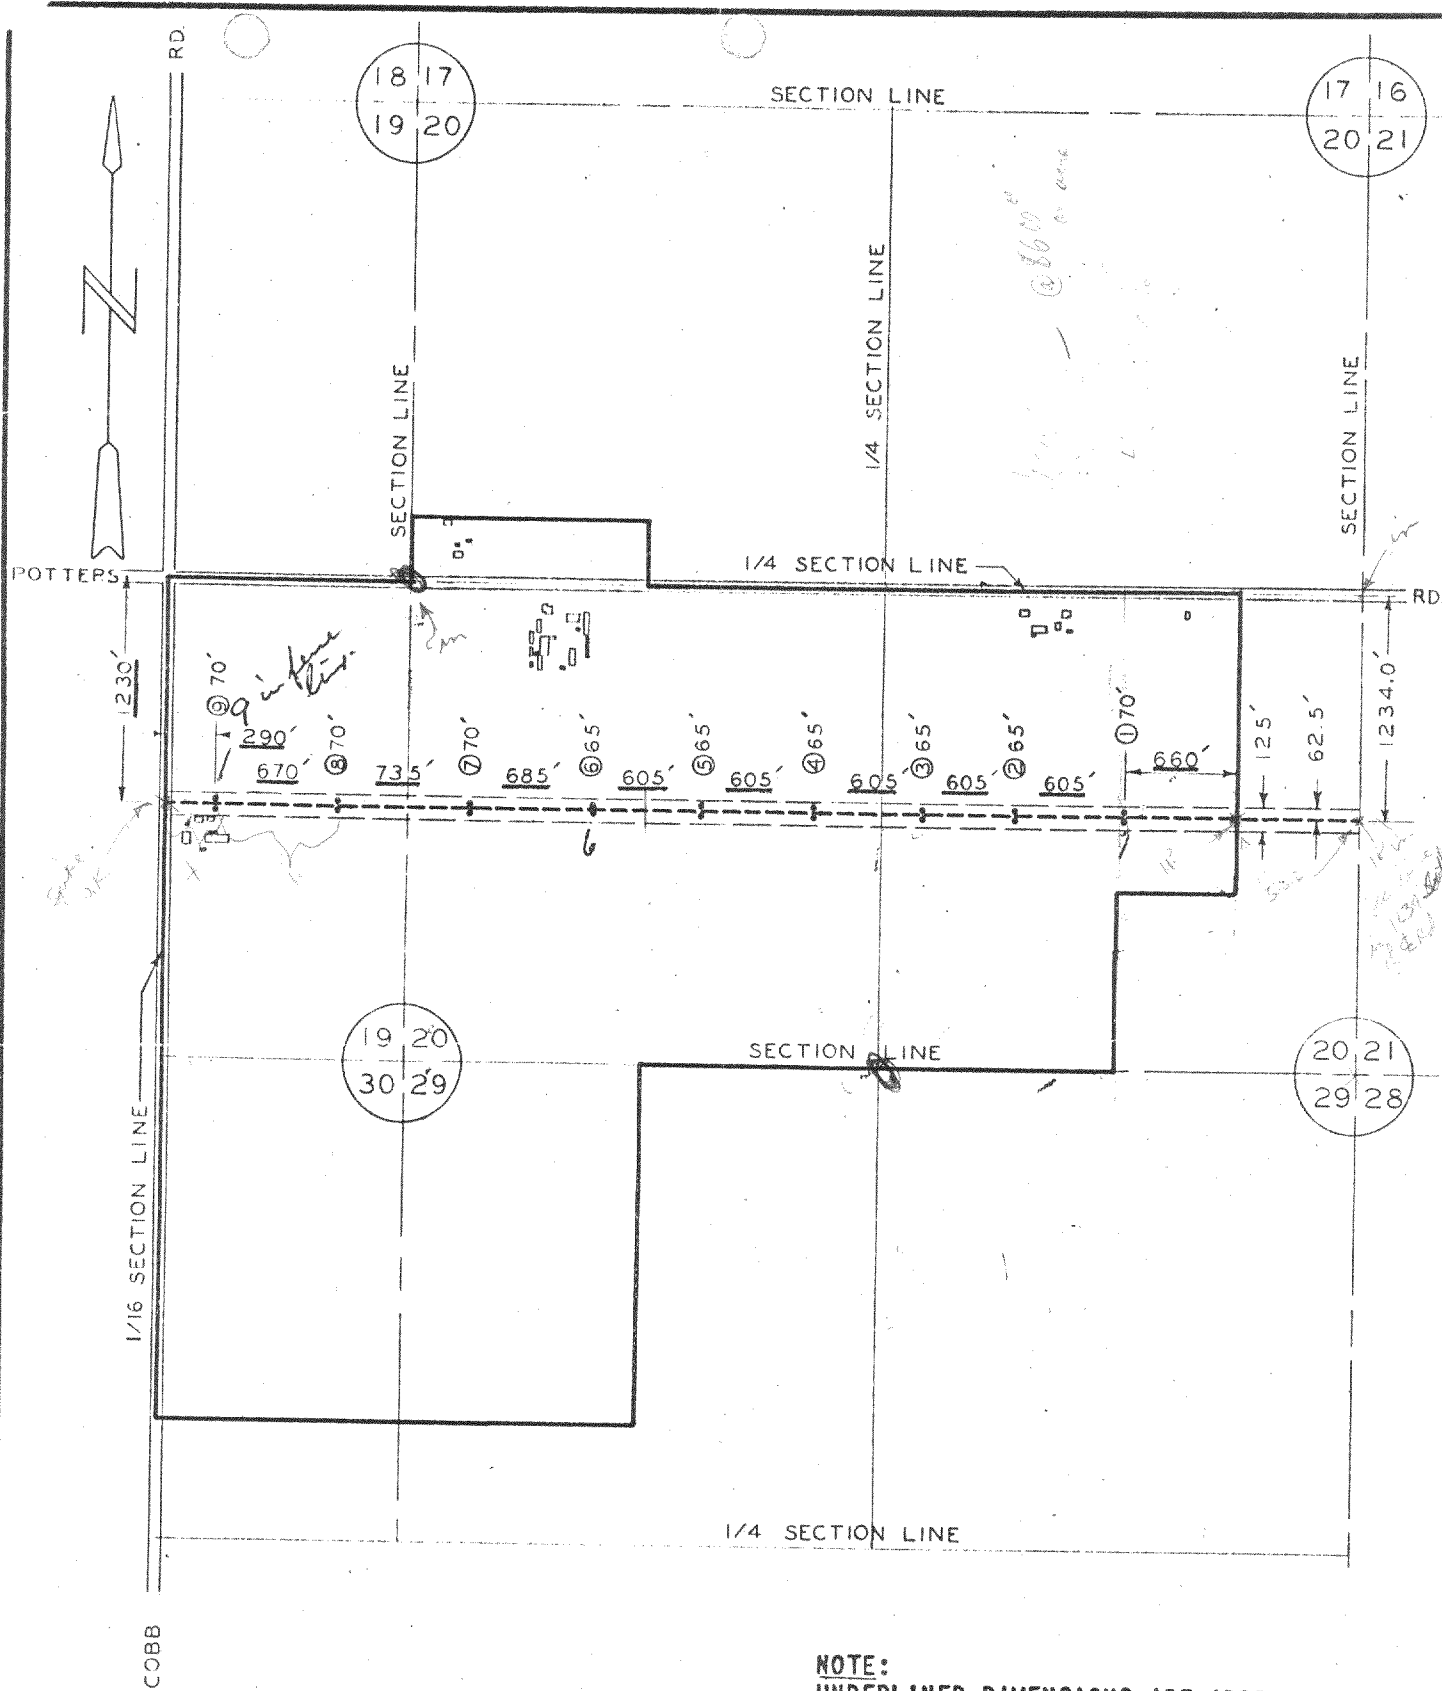

**NOTE:**  
 UNDERLINED DIMENSIONS ARE APPROXIMATE.  
 ACCESS FOR SURVEY WAS DENIED.

EXHIBIT "B"  
 TRACT NO. 13

**KEY**

- : "H" FRAME STRUCTURE
- CENTER LINE OF TRANSMISSION LINE EASEMENT STRIP
- BOUNDARIES OF EASEMENT STRIP
- PROPERTY LINE

**WISCONSIN ELECTRIC POWER CO.**

PROPERTY OF SIMONS SEED FARMS, INC.  
 IN SECTIONS 19, 20, 29, & 30  
 T3N - R17E TOWN OF LA FAYETTE  
 WALNORTH COUNTY

DRAWN BY: DRG      SCALE: 1" = 1000'  
 APP'D BY: RDR      DATE: 2-27-63  
 APP'D BY: SLP      DWG. NO. 2034-50A

L-19-7      L-29-4  
 20-5      L- " 5  
 " 6      L-30-1  
 7 + 8      30-2

317-32B