SUBDIVIDING LOT SURVEYS

KUOKKANEN & ASSOCIATES, INC.

910 ELM GROVE ROAD

ELM GROVE, WISCONSIN 53122 PHONE: (262) 782-8690 FAX: (262) 782-1770 BUILDING SURVEYS

LAND DIVISIONS


04-696-827

Jamie & Tracy Noble / Life Homes, Inc. PREPARED FOR: W4699 Pebble Drive (Town of Lafayette) LOCATION:

DESCRIPTION OF PROPERTY

Unit 46 in Phase 2 of ROLLING GREEN COUNTRY ESTATES, a Condominium, located in the Southeast 1/4 and the Southwest 1/4 of Section 18, Town 3 North, Range 17 East, Town of Lafayette, Walworth County, Wisconsin.

(32,176 sq.ft.)

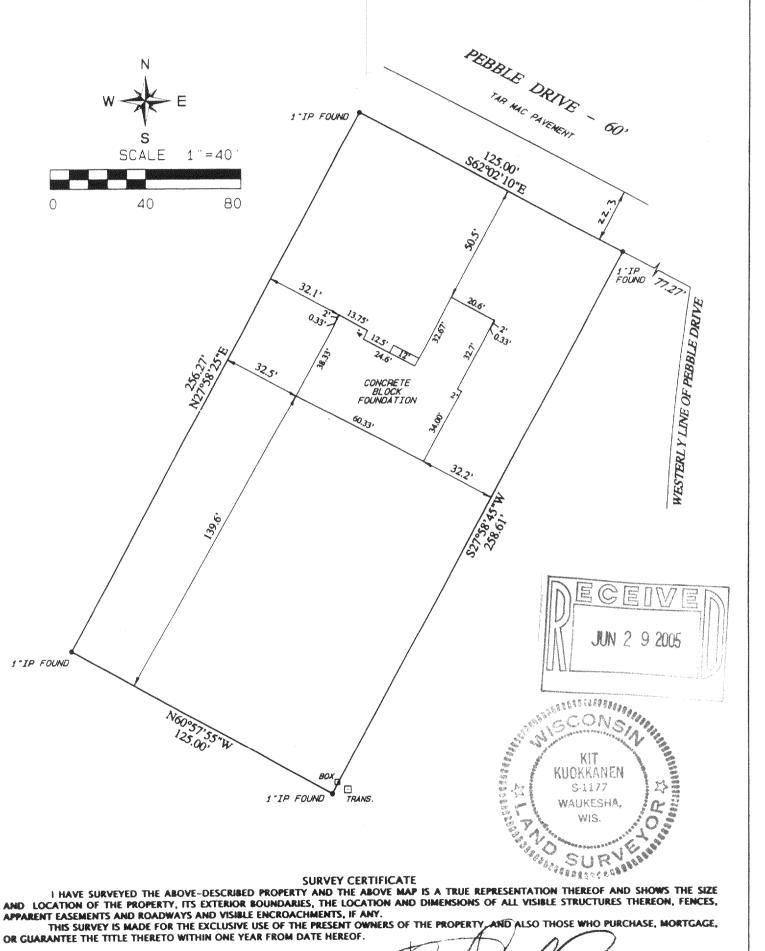

OLTOBER 6, 2004 RECERTIFICATION

KIT KUOKKABEN REGISTERED LAND SURVEYOR

KR6 00046