

PLAT OF SURVEY OF

Certified Surveys, pages 78, 79, 80 and 81 of Document Number 073470, located in part of the Northeast Quarter of the
Northeast Quarter of Section 27 and part of the Northwest Quarter and Southwest Quarter of the Southwest Quarter of
PARCEL IDENTIFICATION NUMBER: OA 39260001

ALSO, Lots 2, 3, 4, 7 and 8 of THE OAKS, A SUBDIVISION, being a division of Lot 2 of Certified Survey Number 3931 located
in part of the Northwest Quarter and Southwest Quarter of the Southwest Quarter Section 26 and part of the Northeast Quarter
and Southeast Quarter of the Southwest Quarter of Section 27, Town 5 North, Range 18 East of the 4th Principal Meridian,


LOT 3 PARCEL IDENTIFICATION NUMBER: OAK 00003
LOT 4 PARCEL IDENTIFICATION NUMBER: OAK 00004
LOT 7 PARCEL IDENTIFICATION NUMBER: OAK 00007
LOT 8 PARCEL IDENTIFICATION NUMBER: OAK 00008



NOTE:
SEE THE OAKS SUBDIVISION PLAT FOR DISTANCE AND BEARING INFORMATION REGARDING LOTS AND EASEMENTS.
SEE CERTIFIED SURVEY MAP NUMBER 3926 FOR BUILDING SETBACK LINES.
AS REQUESTED, THE INTERIOR PROPERTY LINES ARE SHOWN AT THE APPROXIMATE
RECORDED LOCATION AND THE MONUMENTED PROPERTY CORNERS WERE NOT LOCATED.

NOT TO SCALE

SCALE: 1 inch = 100 feet
ORDERED BY: M. Canfield / KEEFE REAL ESTATE
JOB NO. 14087

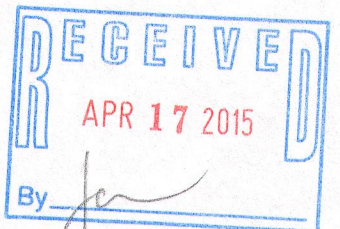

Fieldwork completed on and date of certification: July 17, 2014
I hereby certify that I have surveyed the above described property and the above
plat is a true representation thereof and shows the size and location of the
property, its exterior boundaries, the location and dimensions of all visible
structures thereon, boundary fences, apparent easements and roadways and visible
encroachments, if any.
This survey is made for the exclusive use of the present owners of the property,
and also those who purchase, mortgage or guarantee the title thereto within ONE
YEAR from the date hereof.



Mark A. Bolander
Wisconsin Professional Land Surveyor 1784
OA3926-1 OAK-7
OAK-4 OAK-8
OAK-3
OAK-2 318-1176