

# PLAT OF SURVEY


## OF

Lot 1 of WILMOUTH COUNTY CERTIFIED SURVEY MAP NO. 3926, according to the recorded plat thereof, recorded in Volume 4 of Certified Surveys, pages 78, 79, 80 and 81 of Document Number 073670, located in part of the Northwest Quarter of the Northwest Quarter of Section 27 and part of the Northwest Quarter and Southwest Quarter of the Southwest Quarter of Section 30, Town 5 North, Range 18 East of the 4th Principal Meridian, Town of Spring Prairie, Wilmarth County, Wisconsin.

PARCEL IDENTIFICATION NUMBER: OA 39260001

ALSO, Lots 2, 3, 4, 7 and 8 of THE OAKS, A SUBDIVISION, being a division of Lot 2 of Certified Survey Number 3031 located in part of the Northwest Quarter and Southwest Quarter of the Southwest Quarter Section 26 and part of the Northwest Quarter and Southeast Quarter of the Southwest Quarter of Section 27, Town 5 North, Range 18 East of the 4th Principal Meridian, Wilmarth County, Wisconsin.

LOT 3 PARCEL IDENTIFICATION NUMBER: OAK 00003  
 LOT 4 PARCEL IDENTIFICATION NUMBER: OAK 00004  
 LOT 7 PARCEL IDENTIFICATION NUMBER: OAK 00007  
 LOT 8 PARCEL IDENTIFICATION NUMBER: OAK 00008

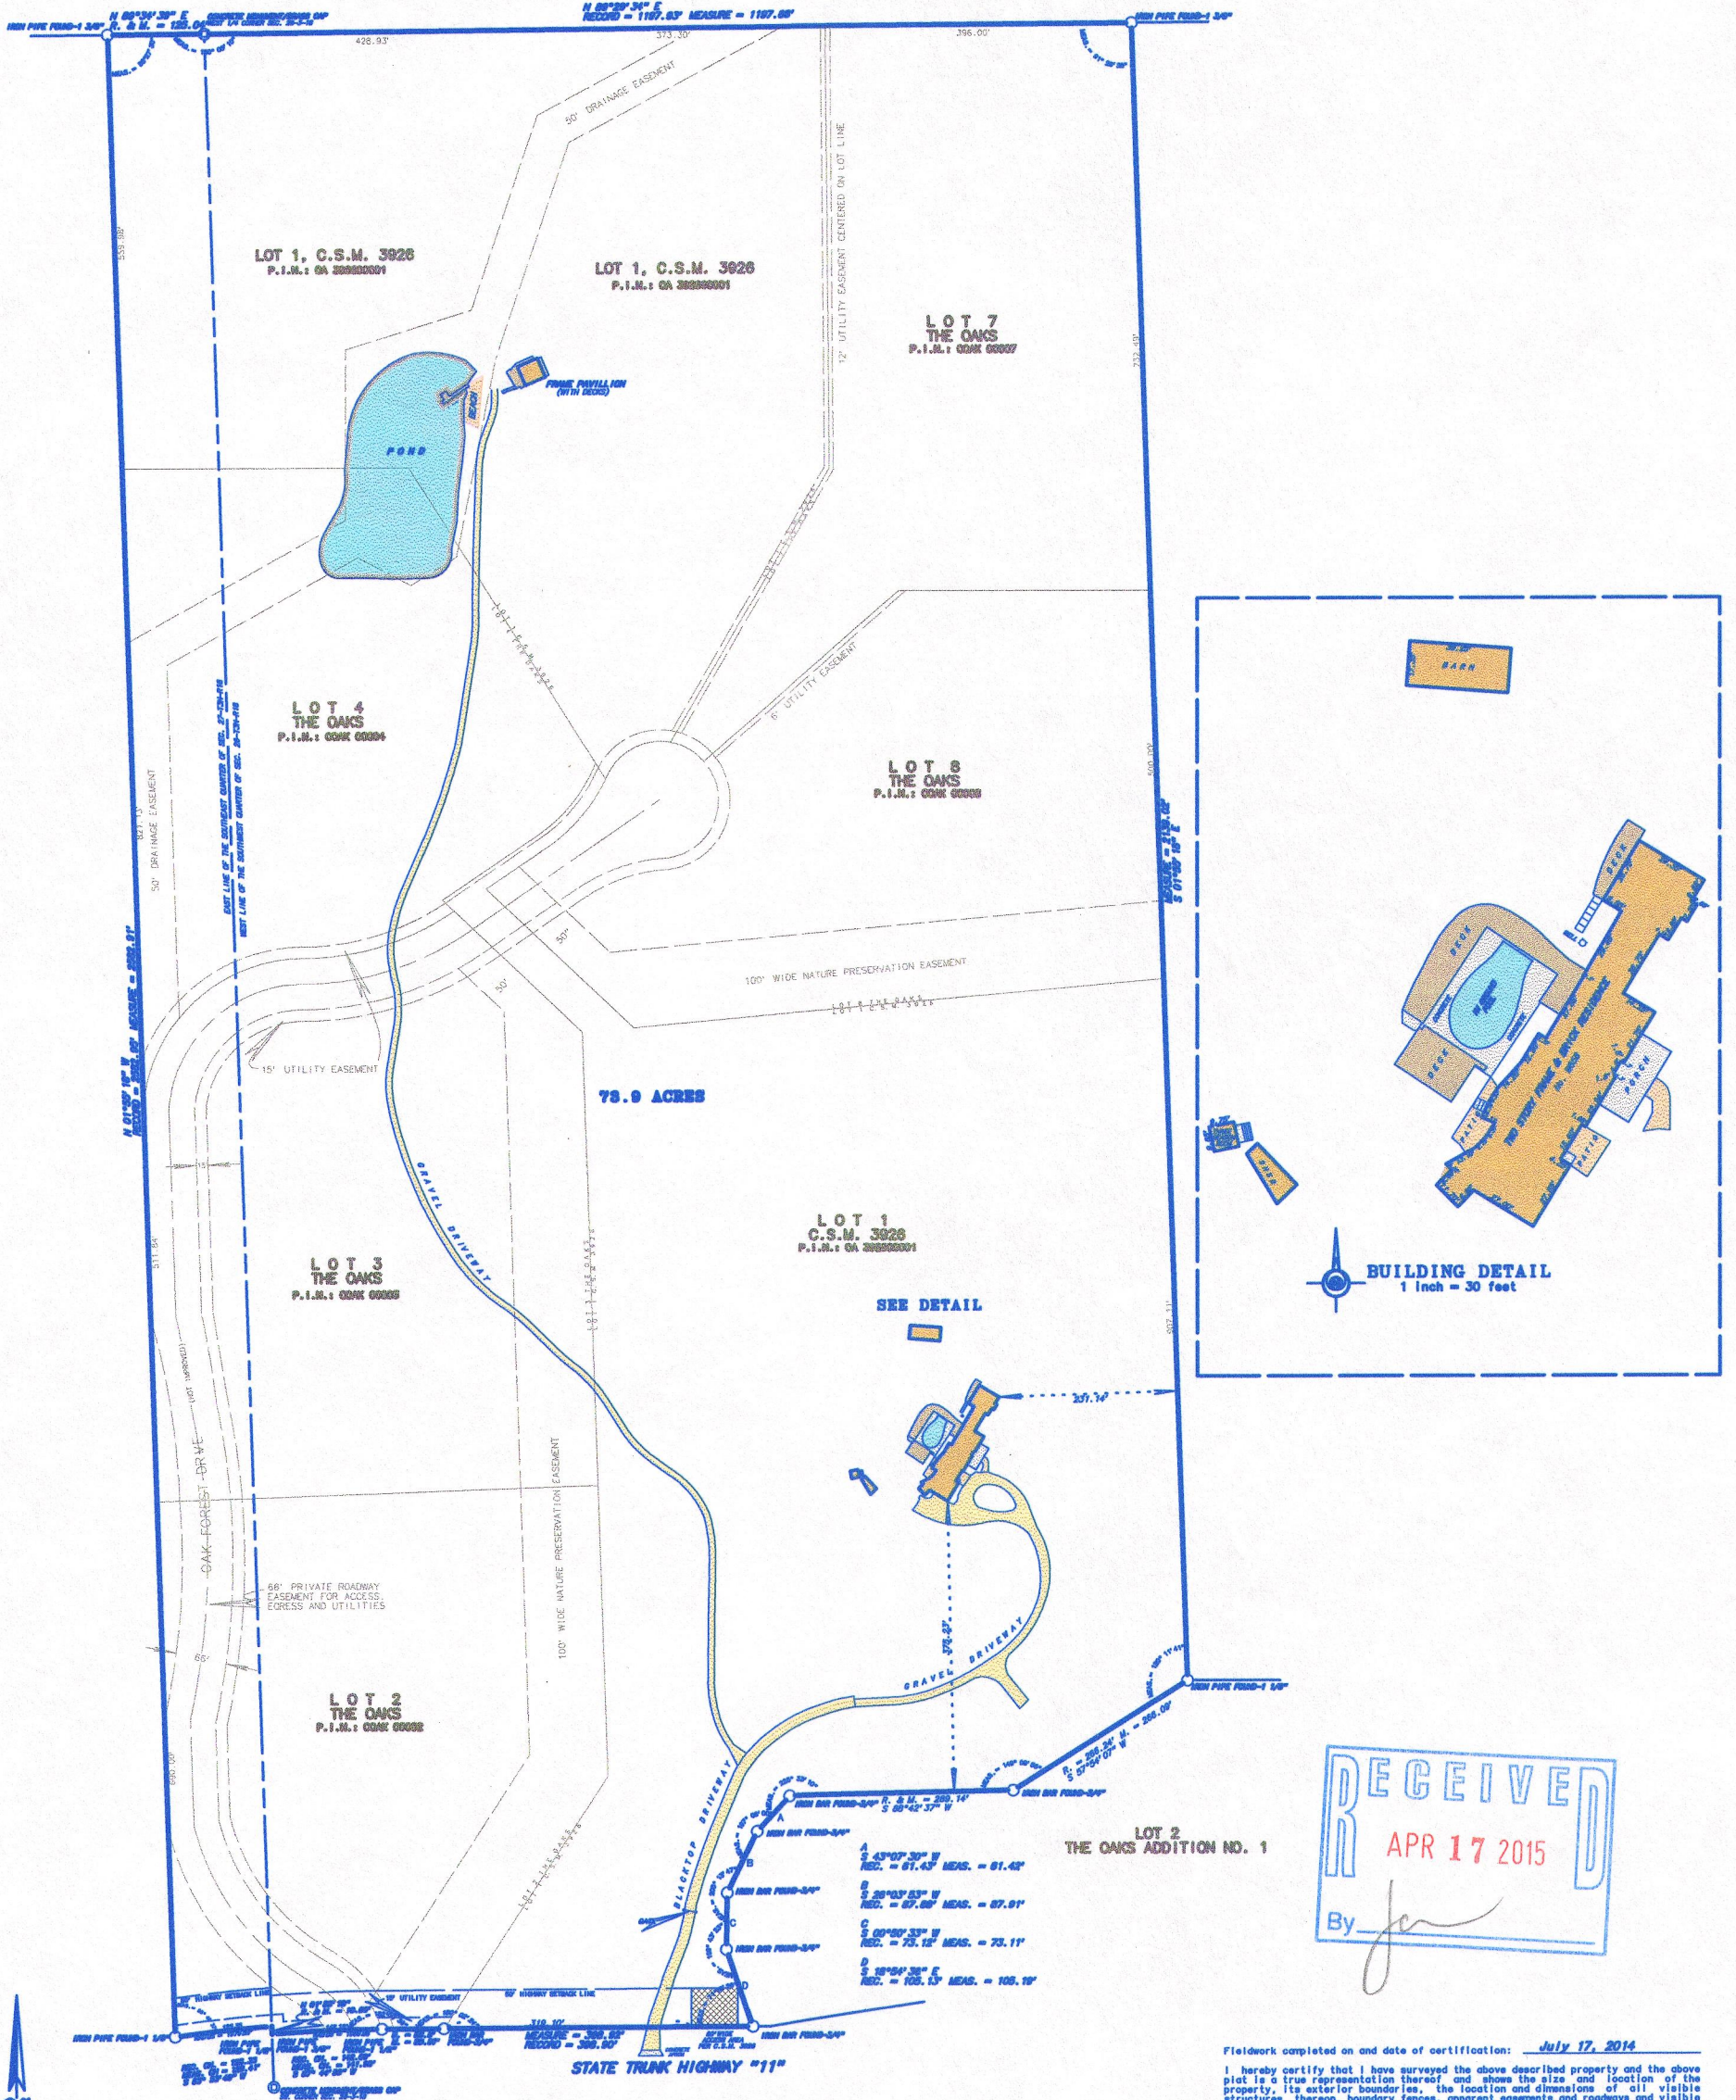

NOTE:  
 SEE THE OAKS SUBDIVISION PLAT FOR DISTANCE AND BEARING INFORMATION REGARDING LOTS AND EASEMENTS.  
 SEE CERTIFIED SURVEY MAP NUMBER 3926 FOR BUILDING SETBACK LINES.  
 AS REQUESTED, THE INTERIOR PROPERTY LINES ARE SHOWN AT THE APPROXIMATE  
 RECORDED LOCATION AND THE MONUMENTED PROPERTY CORNERS WERE NOT LOCATED.

NOT TO SCALE  
 1 inch = 100 feet

SCALE: \_\_\_\_\_  
 ORDERED BY: M. Canfield / KEEFE REAL ESTATE  
 JOB NO. 14087

Fieldwork completed on and date of certification: July 17, 2014  
 I hereby certify that I have surveyed the above described property and the above  
 plat is a true representation thereof and shows the size and location of the  
 property, its exterior boundaries, the location and dimensions of all visible  
 structures thereon, boundary fences, apparent easements and roadways and visible  
 encroachments, if any.  
 This survey is made for the exclusive use of the present owners of the property,  
 and also those who purchase, mortgage or guarantee the title thereto within ONE  
 YEAR from the date hereof.  
 Dated at Bassett, Wisconsin this \_\_\_\_\_ day of \_\_\_\_\_ 2014.



Mark A. Bolander  
 Mark A. Bolander  
 Wisconsin Professional Land Surveyor 1784  
 OA3926-1 OAK-7  
 OAK-4 OAK-8  
 OAK-3  
 OAK-2 318-1176