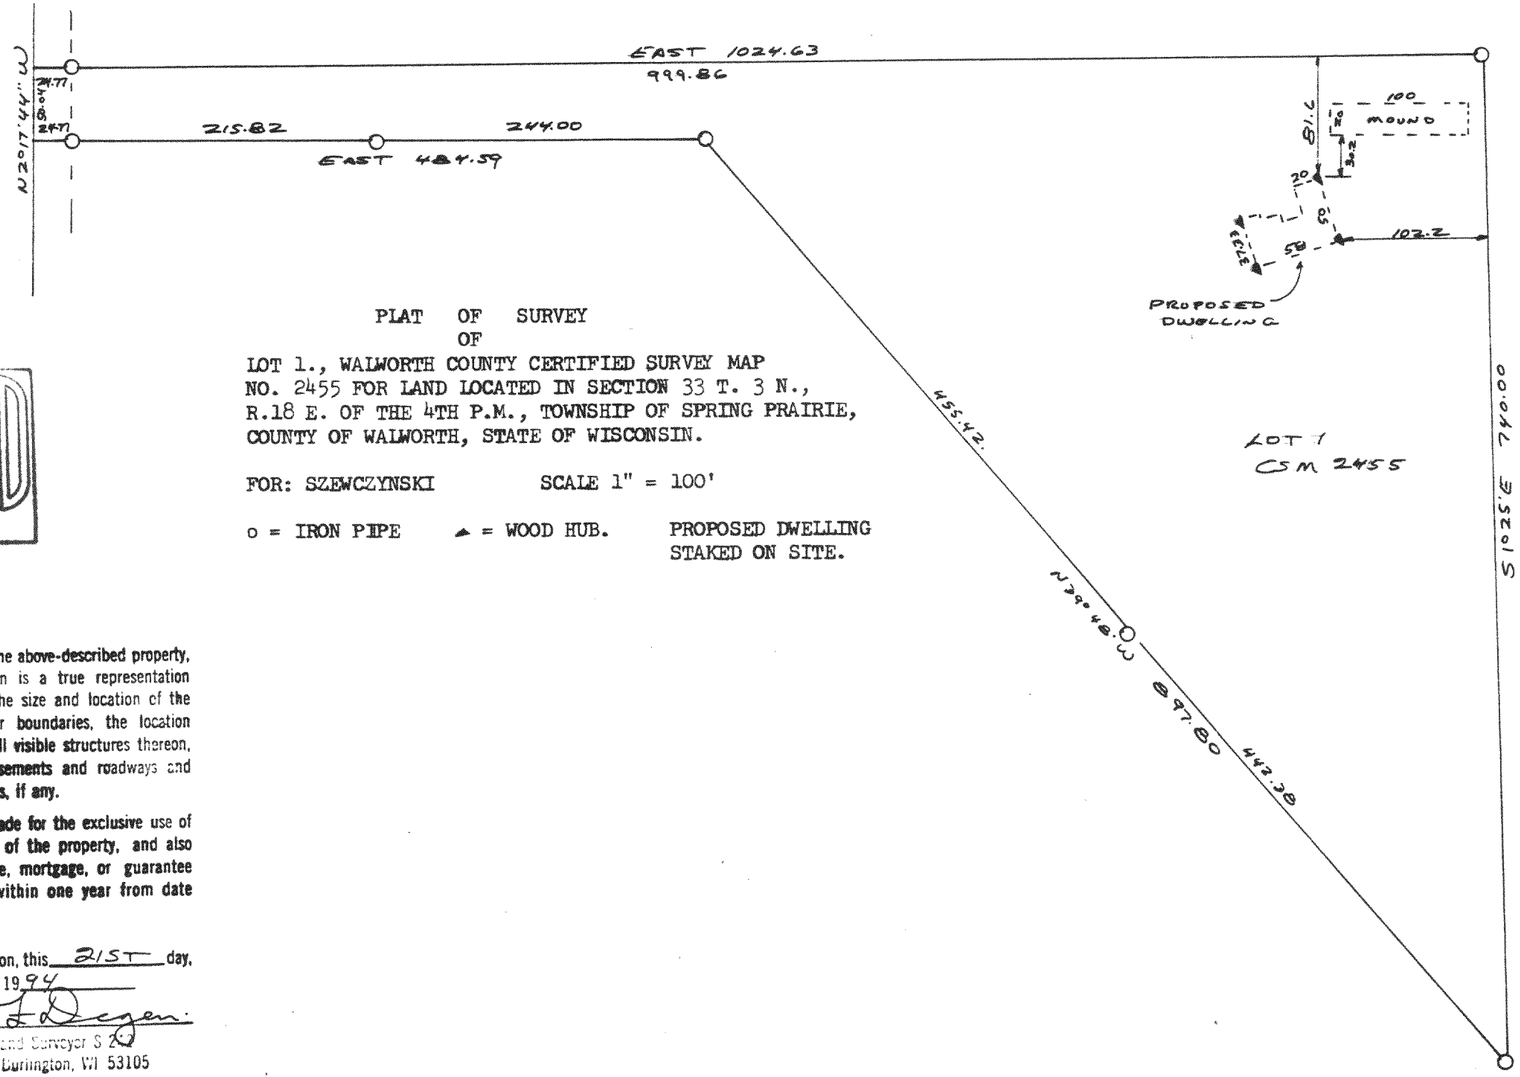

PLAT OF SURVEY
OF
LOT 1., WALWORTH COUNTY CERTIFIED SURVEY MAP NO. 2455 FOR LAND LOCATED IN SECTION 33 T. 3 N., R.18 E. OF THE 4TH P.M., TOWNSHIP OF SPRING PRAIRIE, COUNTY OF WALWORTH, STATE OF WISCONSIN.

FOR: SZEWCZYNSKI SCALE 1" = 100'

o = IRON PIPE ▲ = WOOD HUB. PROPOSED DWELLING STAKED ON SITE.

RECEIVED
AUG 2 1994

I have surveyed the above-described property, and the map hereon is a true representation thereof and shows the size and location of the property, its exterior boundaries, the location and dimensions of all visible structures thereon, fences, apparent easements and roadways and visible encroachments, if any.

This survey is made for the exclusive use of the present owners of the property, and also those who purchase, mortgage, or guarantee the title thereto, within one year from date hereof.

Dated at Burlington, this 21ST day, of JULY, 1994

John F. Degen

John F. Degen, Land Surveyor S 2
589 N. Pine St. Burlington, WI 53105

OA-2455-1

318-467

19-C-2 #34