**LAND-MARK SURVEYING**
**Mark L. Miritz**
Wisconsin Registered Land Surveyor S-2582

N9330 Knuteson Drive
Whitewater, WI 53190
Phone:(262)495-3284
FAX : (262) 495-8421
LAND-MARKSURVEYING.COM

# PLAT OF SURVEY

**LOT 2 OF CERTIFIED SURVEY MAP NO. 1783, LOCATED IN THE SW 1/4 AND THE NW 1/4 OF THE NW 1/4 OF SECTION 6, TOWN 4 NORTH, RANGE 15 EAST, WHITEWATER TOWNSHIP, WALWORTH COUNTY, WISCONSIN.**

**OWNERS: KEITH J. JASS**
**LINDA NORTON**
**613 RICKORDS ST.**
**DELAVAN, WI 53115**

RECEIVED
AUG 11 2006
SMF

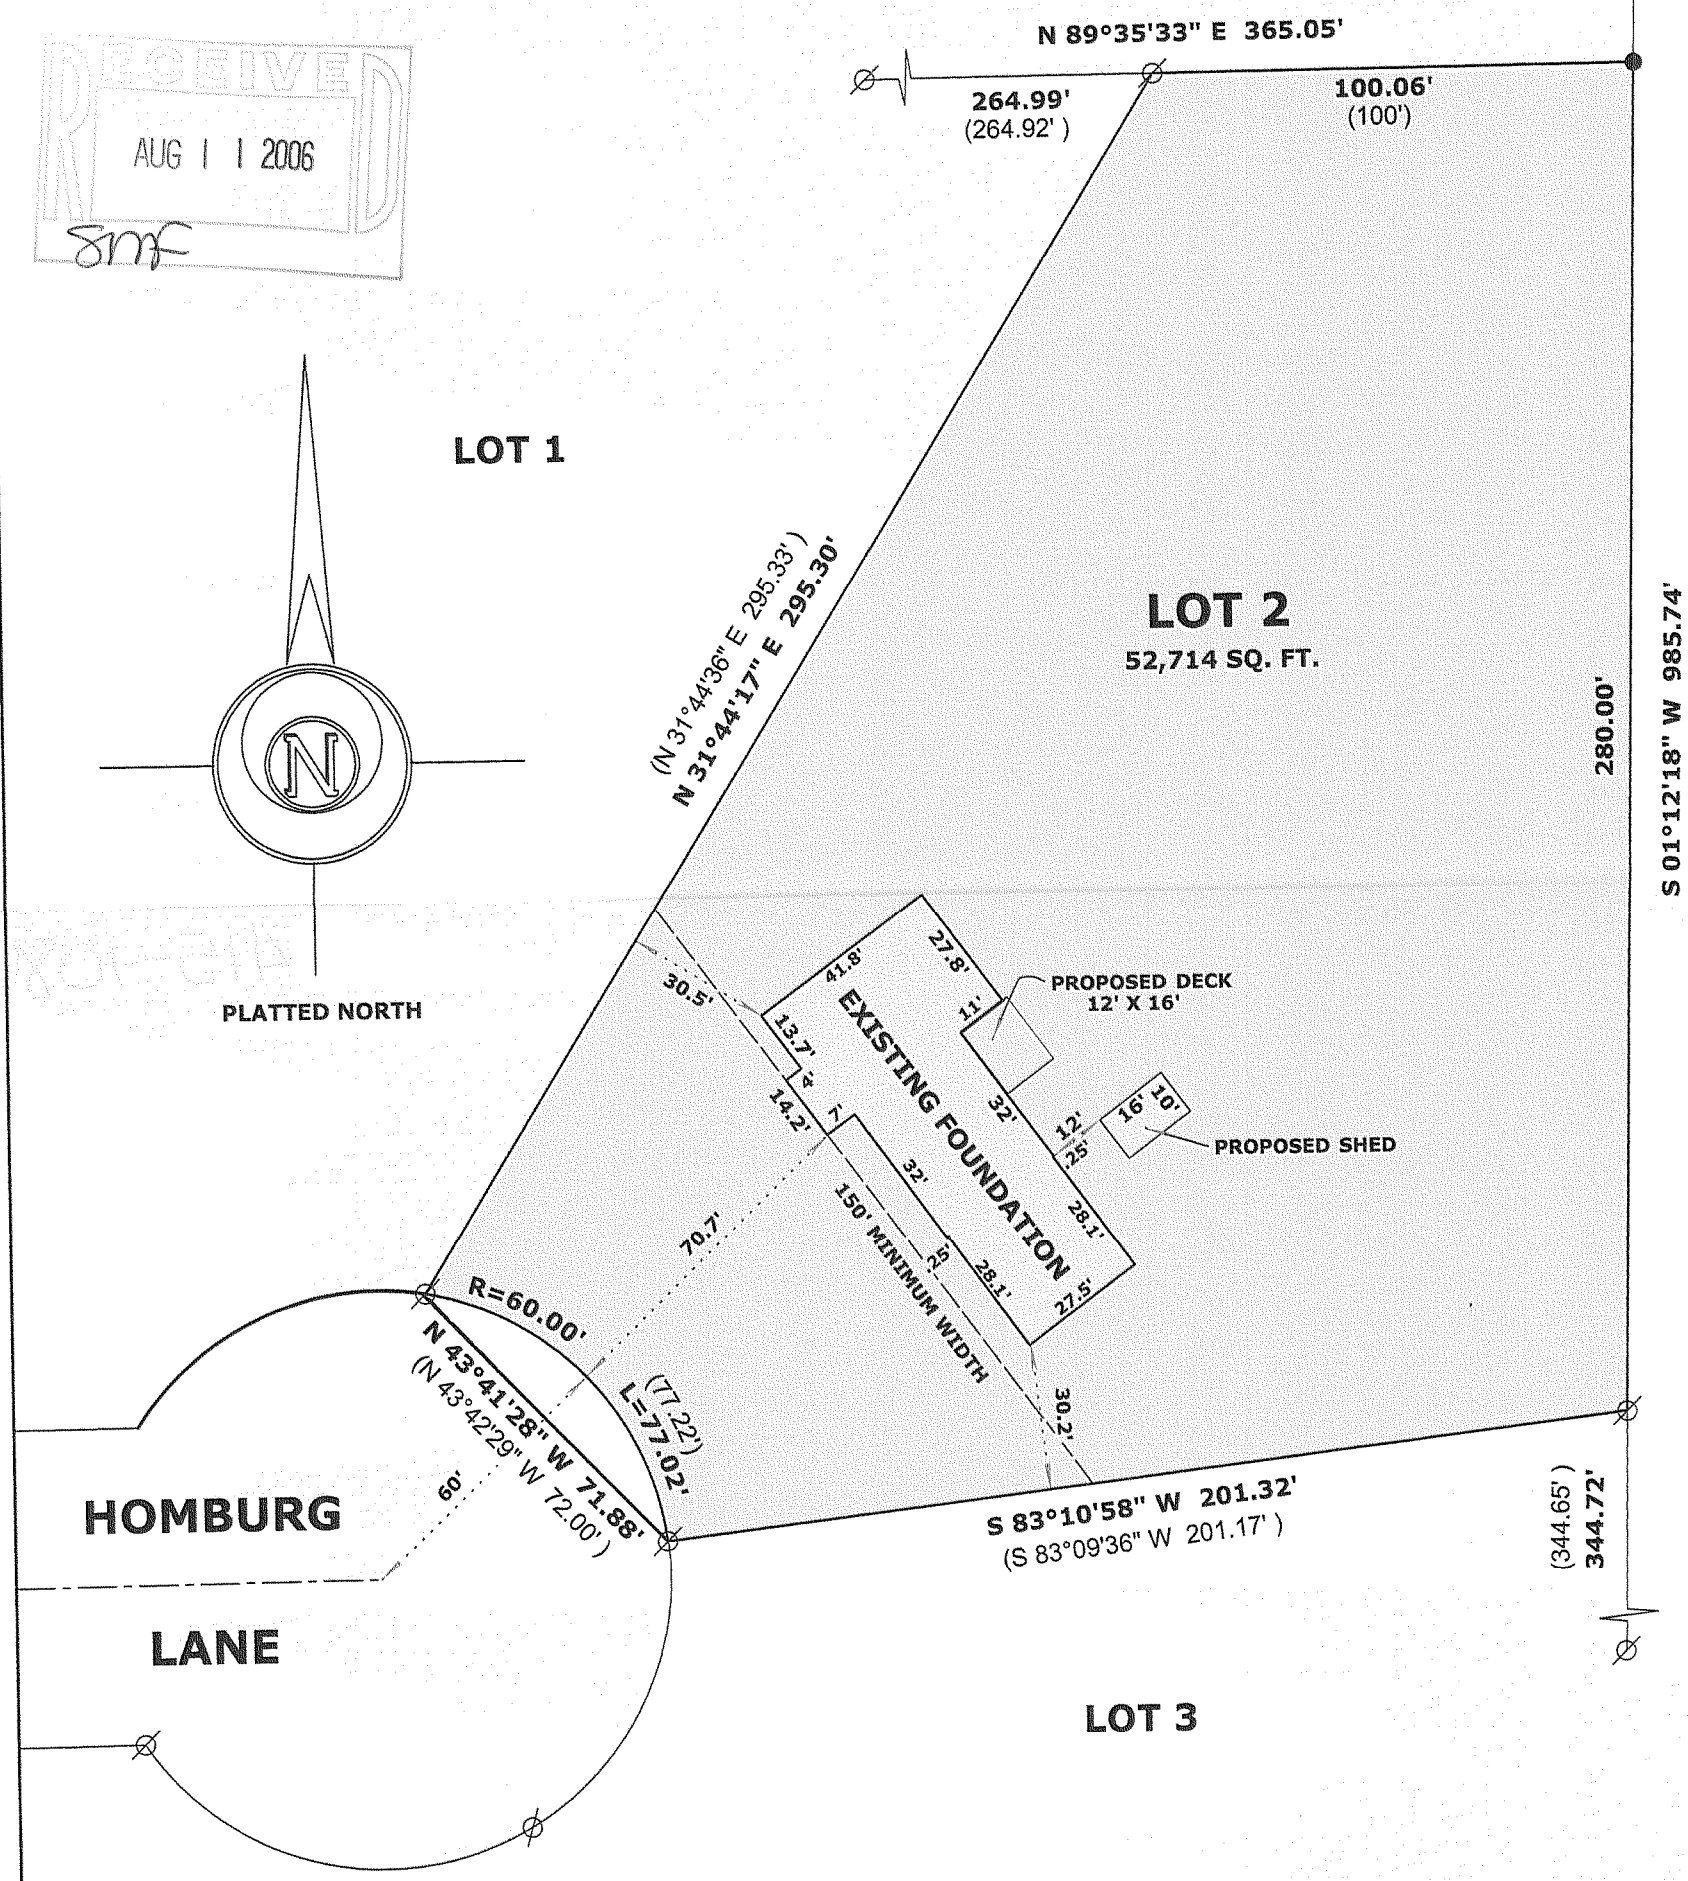


## LEGEND

- FOUND IRON PIPE
- FOUND IRON ROD
- FOUND COUNTY MONUMENT
- WOOD STAKE AT 10' OFFSET
- CHISEL CUT IN CONCRETE
- SET IRON ROD, 24" LONG, WEIGHING 1.5 LBS./LINEAL FT., 3/4" DIA.
- ( x x ) RECORDED AS DIMENSION
- —x—x— EXISTING FENCE

WISCONSIN
MARK L. MIRITZ
S-2582
WHITEWATER, WI
LAND SURVEYOR

**SCALE: 1" = 40 FEET**

"I hereby certify that the above described property has been surveyed by me or under my direction and that the above map is a true representation thereof and shows the size and location of the property, its exterior boundaries, the location of all visible structures and dimensions of all principal buildings thereon, boundary fences, apparent easements, roadways and visible encroachments, if any."
"This survey is made for the use of the present owners of the property, and also those who purchase, mortgage, or guarantee the title thereto within one year from date hereof."

**MARK L. MIRITZ**
**WISCONSIN REGISTERED**
**LAND SURVEYOR S-2582**

**REVISED JUNE 1, 2006 TO SHOW FOUNDATION AS BUILT**

**DATE: JANUARY 23, 2006 JOB NO. 06.111**

DA1783-2

415-1080