

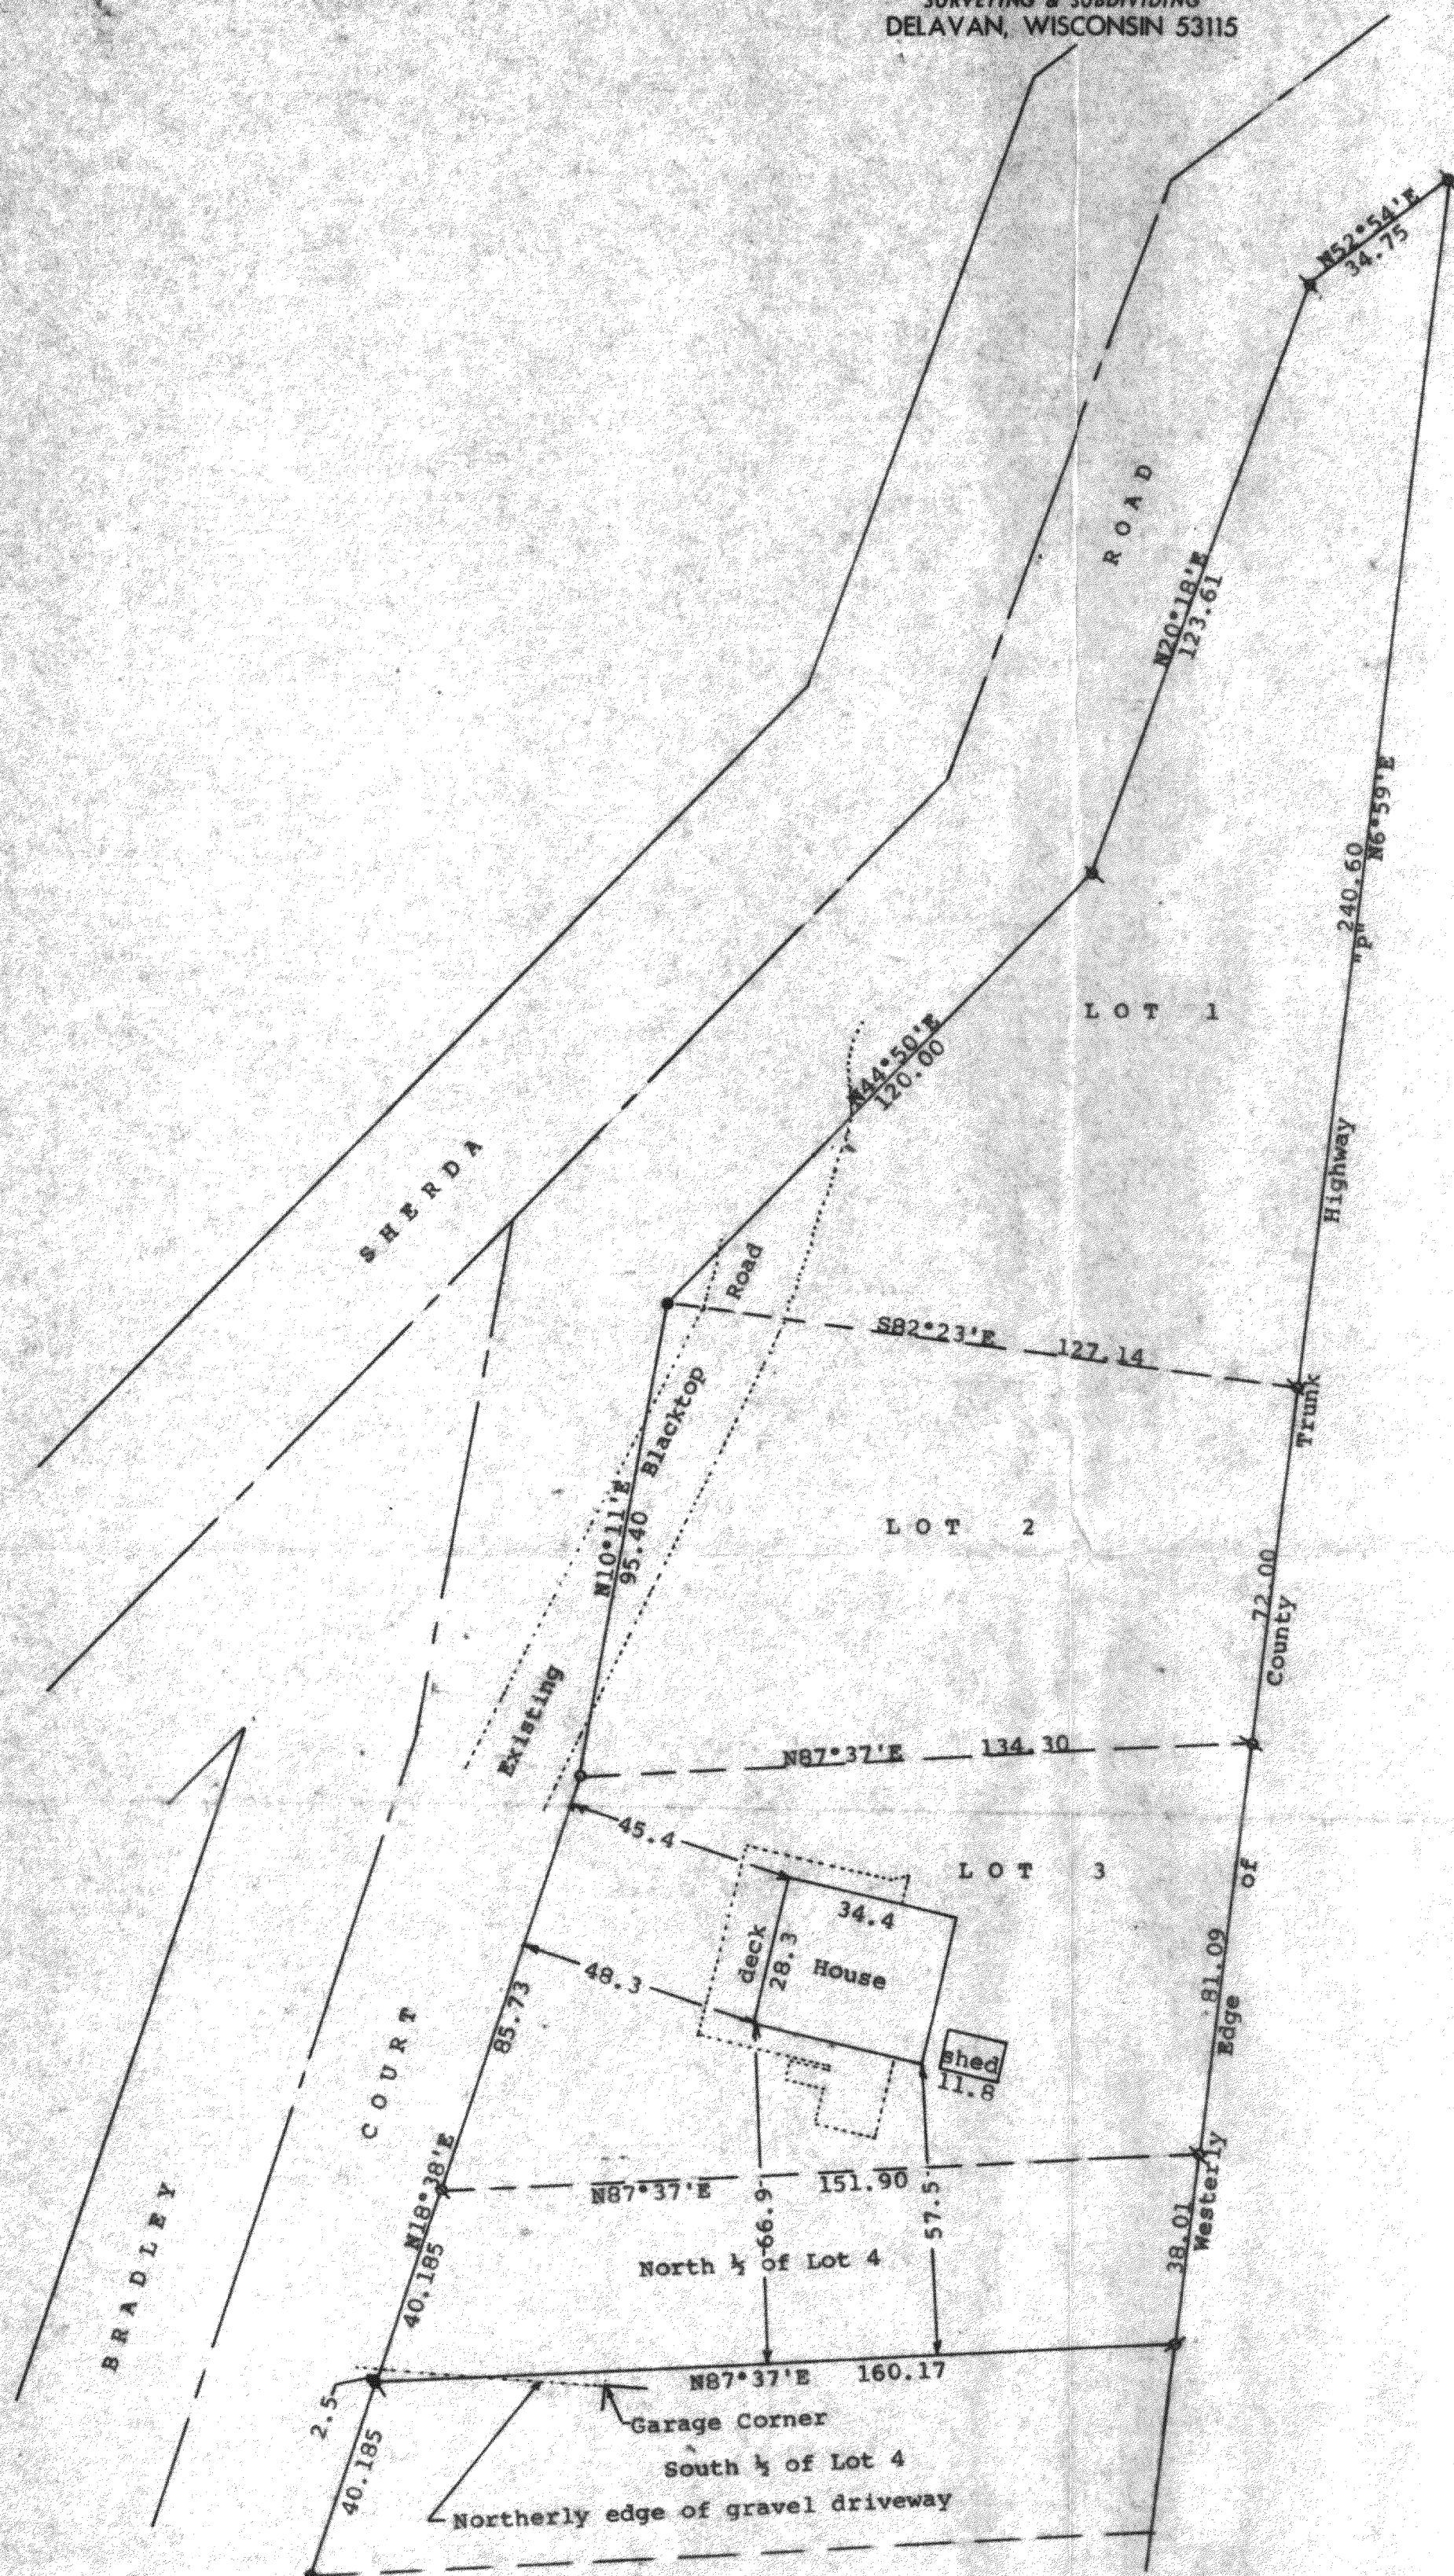


- = 2" Iron Pipe Found
- = 1½" Iron Pipe Found
- = ¾" Iron Pipe Found
- = ¾" X 24" Iron Pipe Set
- = badly bent ¾" Iron Pipe Found.
reset ¾" X 24" Iron Pipe

Bearings are those shown on the recorded
plat of Morning Side Heights
Survey ordered by:
Century 21, Skandia Realty
312 South 7th Street
Delavan, WI 53115

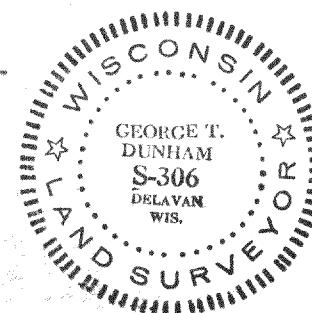

George T. Dunham
George T. Dunham, Surveyor

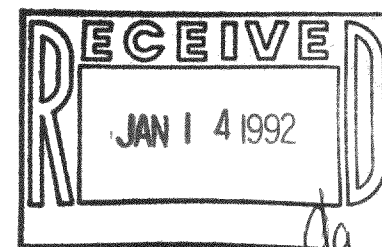

DMSH - 1
DMSH - 2
DMSH - 3