

DUNHAM SURVEYING, S.C.
SURVEYING & SUBDIVIDING
DELAVER, WISCONSIN 53115

N




Scale - 1" = 20'

o = Iron Pipe Found

Bearings are those shown on the recorded plat of Thorne Heights.

Survey ordered by: Nancy A. Tank
6N748 Pine Street
Bensenville, IL 60106

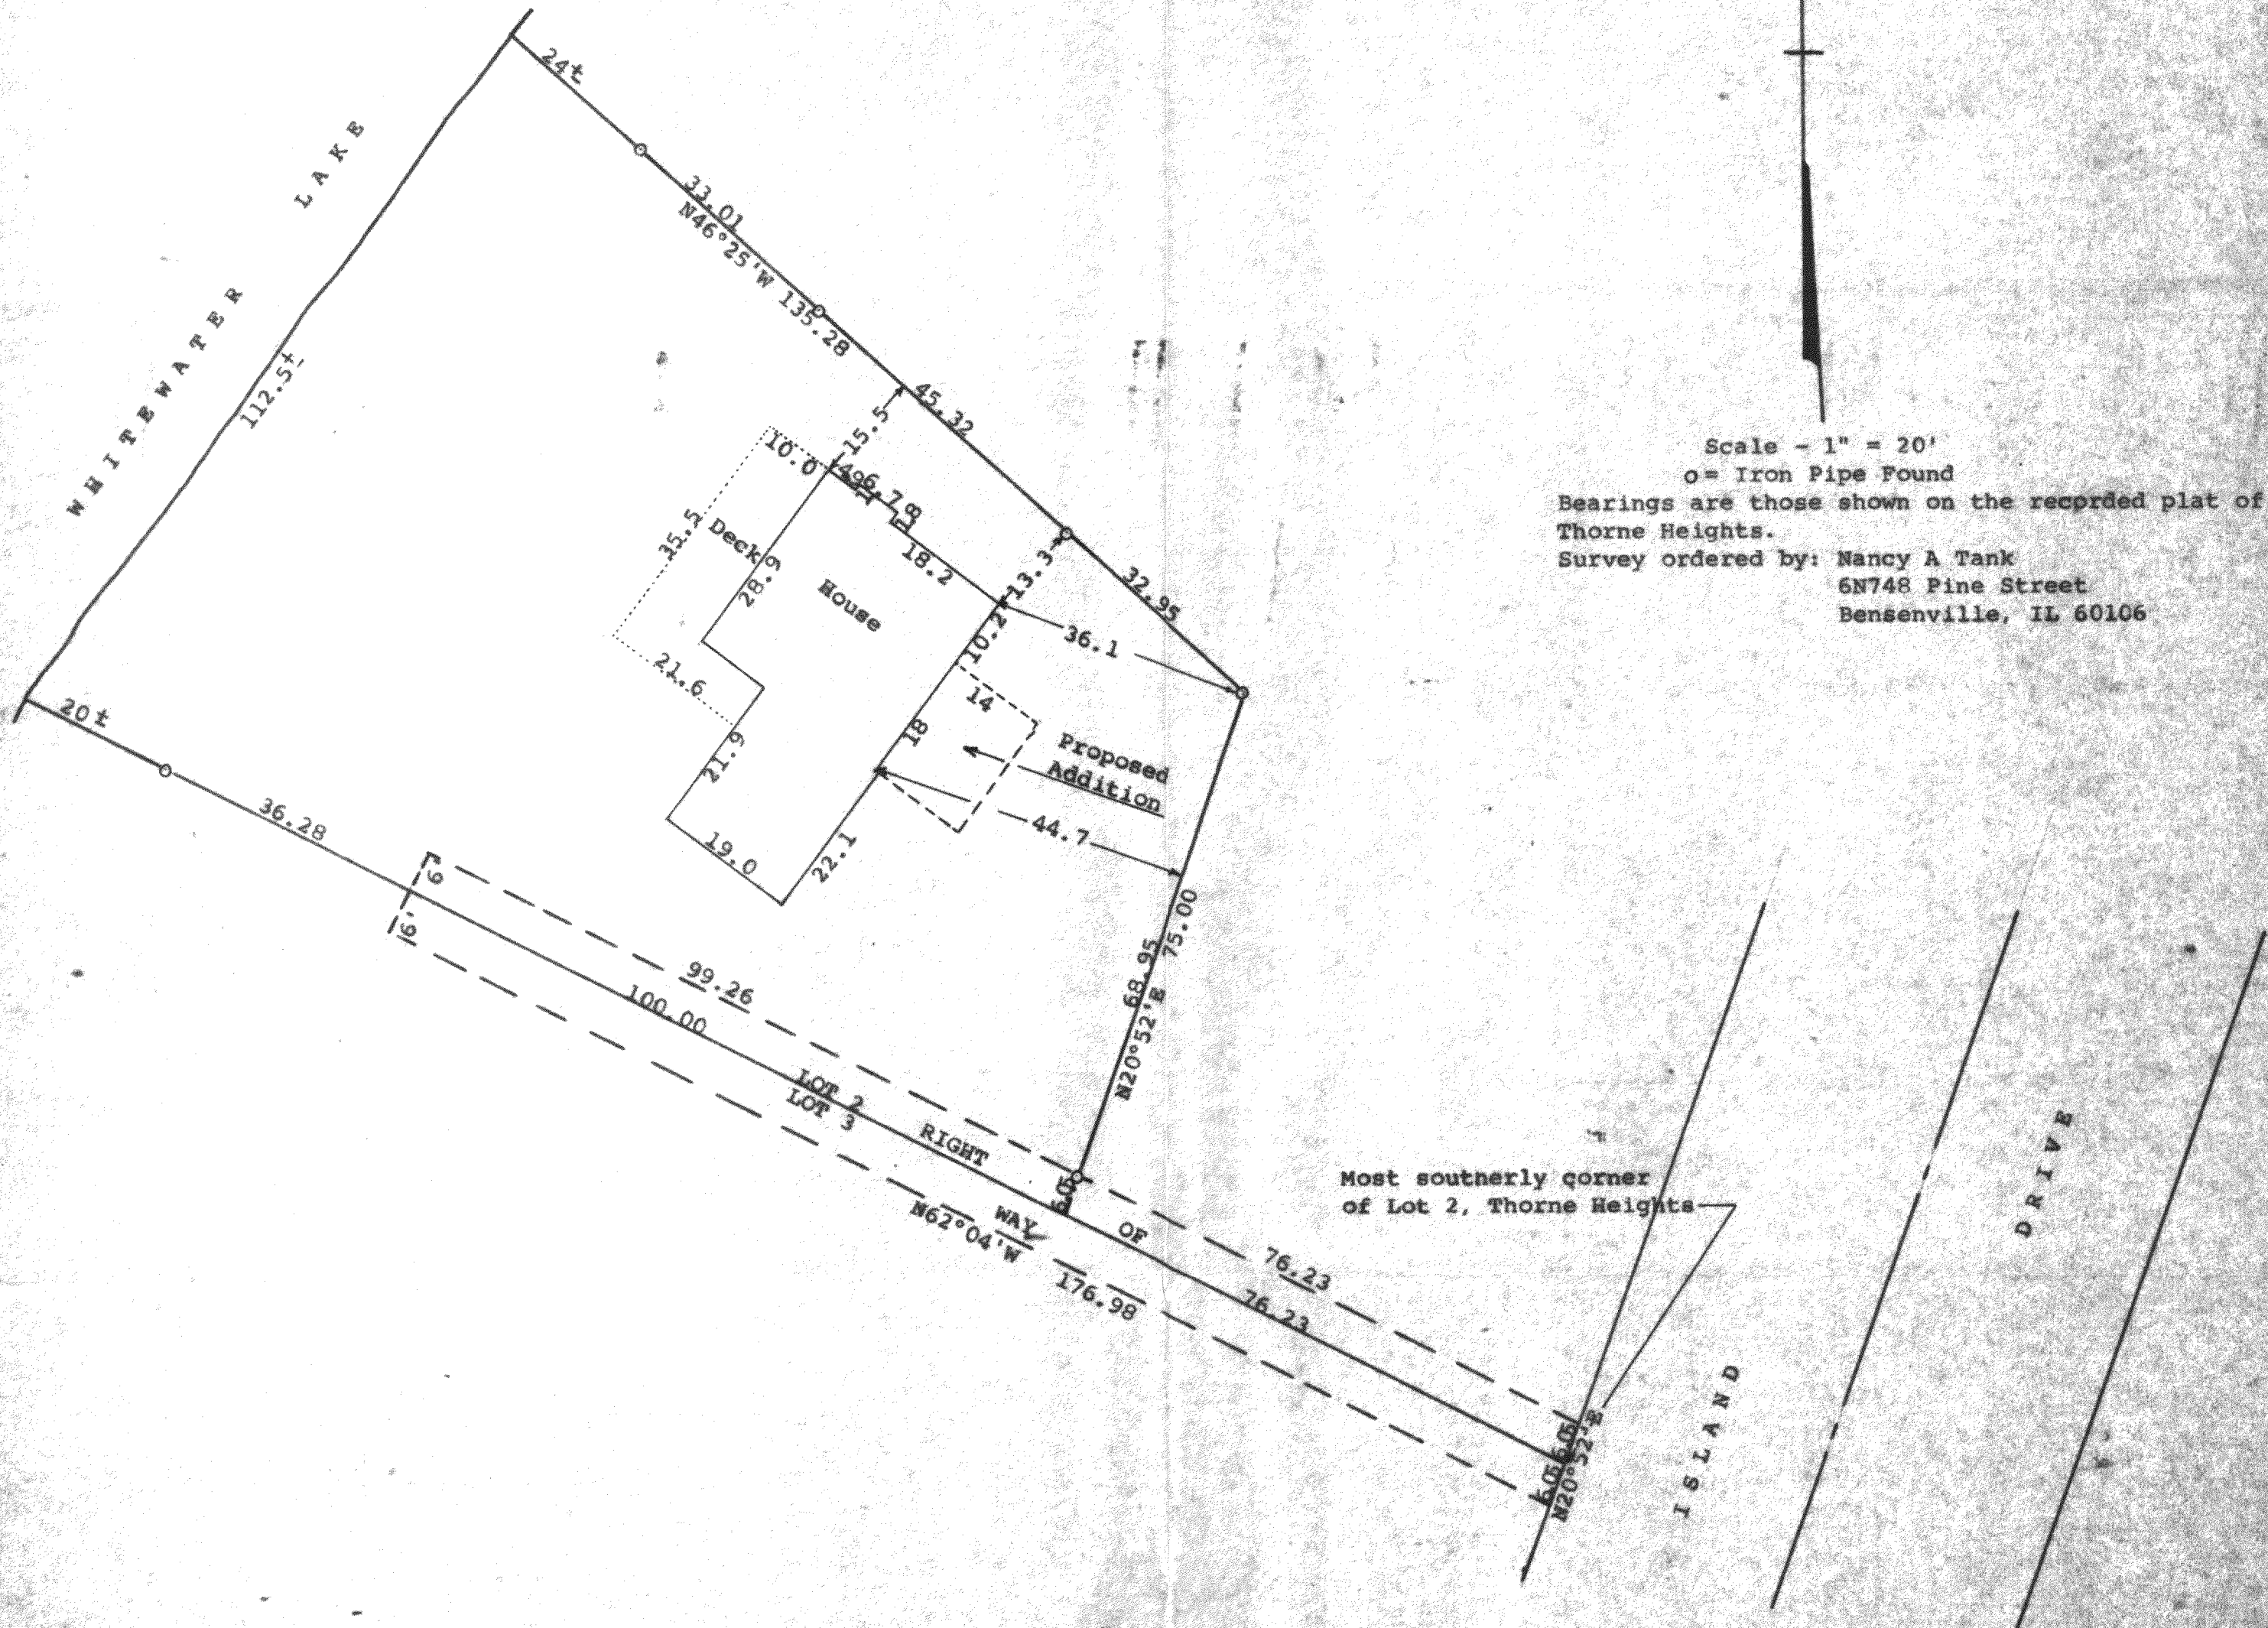

STATE OF WISCONSIN)
COUNTY OF WALWORTH) SS

I, George T. Dunham, Surveyor, certify that I have surveyed the property described as follows:

A part of Lot 2 of Thorne Heights, a subdivision located in Section 35, T 4 N, R 15 E, Walworth County, Wisconsin, described as follows: Commencing at the most southerly corner of said Lot 2; thence N62°04'W along the southerly line of said Lot 2, 76.23 feet to the place of beginning; thence N20°52'E 75.00 feet; thence N46°25'W 135.28 feet more or less to the shore of Whitewater Lake; thence southerly along the shore of Whitewater Lake 112.5 feet more or less to the southwest corner of said Lot 2; thence S62°04'E 156.28 feet more or less to the place of beginning; subject to a right of way to be used by others over and along the following described parcel of land: Beginning at the place of beginning of the above described parcel of land; thence N62°04'W along the southerly line of said Lot 2, 100.00 feet; thence N27°56'E 6.00 feet; thence S62°04'E 99.26 feet; thence S20°52'W 6.05 feet to the place of beginning. Also a right of way is granted to the owner of the above described parcel of land over and along the following described parcel of land: Beginning at the most southerly corner of said Lot 2; thence S20°52'W 6.05 feet; thence N62°04'W parallel to the southerly line of said Lot 2, 176.98 feet; thence N27°56'E 6.00 feet; thence S62°04'E along the southerly line of said Lot 2, 100.00 feet; thence N20°52'E 6.05 feet; thence S62°04'E 76.23 feet; thence S20°52'W 6.05 feet to the place of beginning.

and that the plat shown hereon is a correct representation thereof and shows the size and location of the property, its exterior boundaries, the location of all visible structures and dimensions of all principal buildings thereon, boundary fences, apparent easements, roadways and visible encroachments, if any, and that I have surveyed the property hereon described, according to the official records, to the best of my knowledge and belief.

June 6, 1991

George T. Dunham
George T. Dunham, Surveyor

