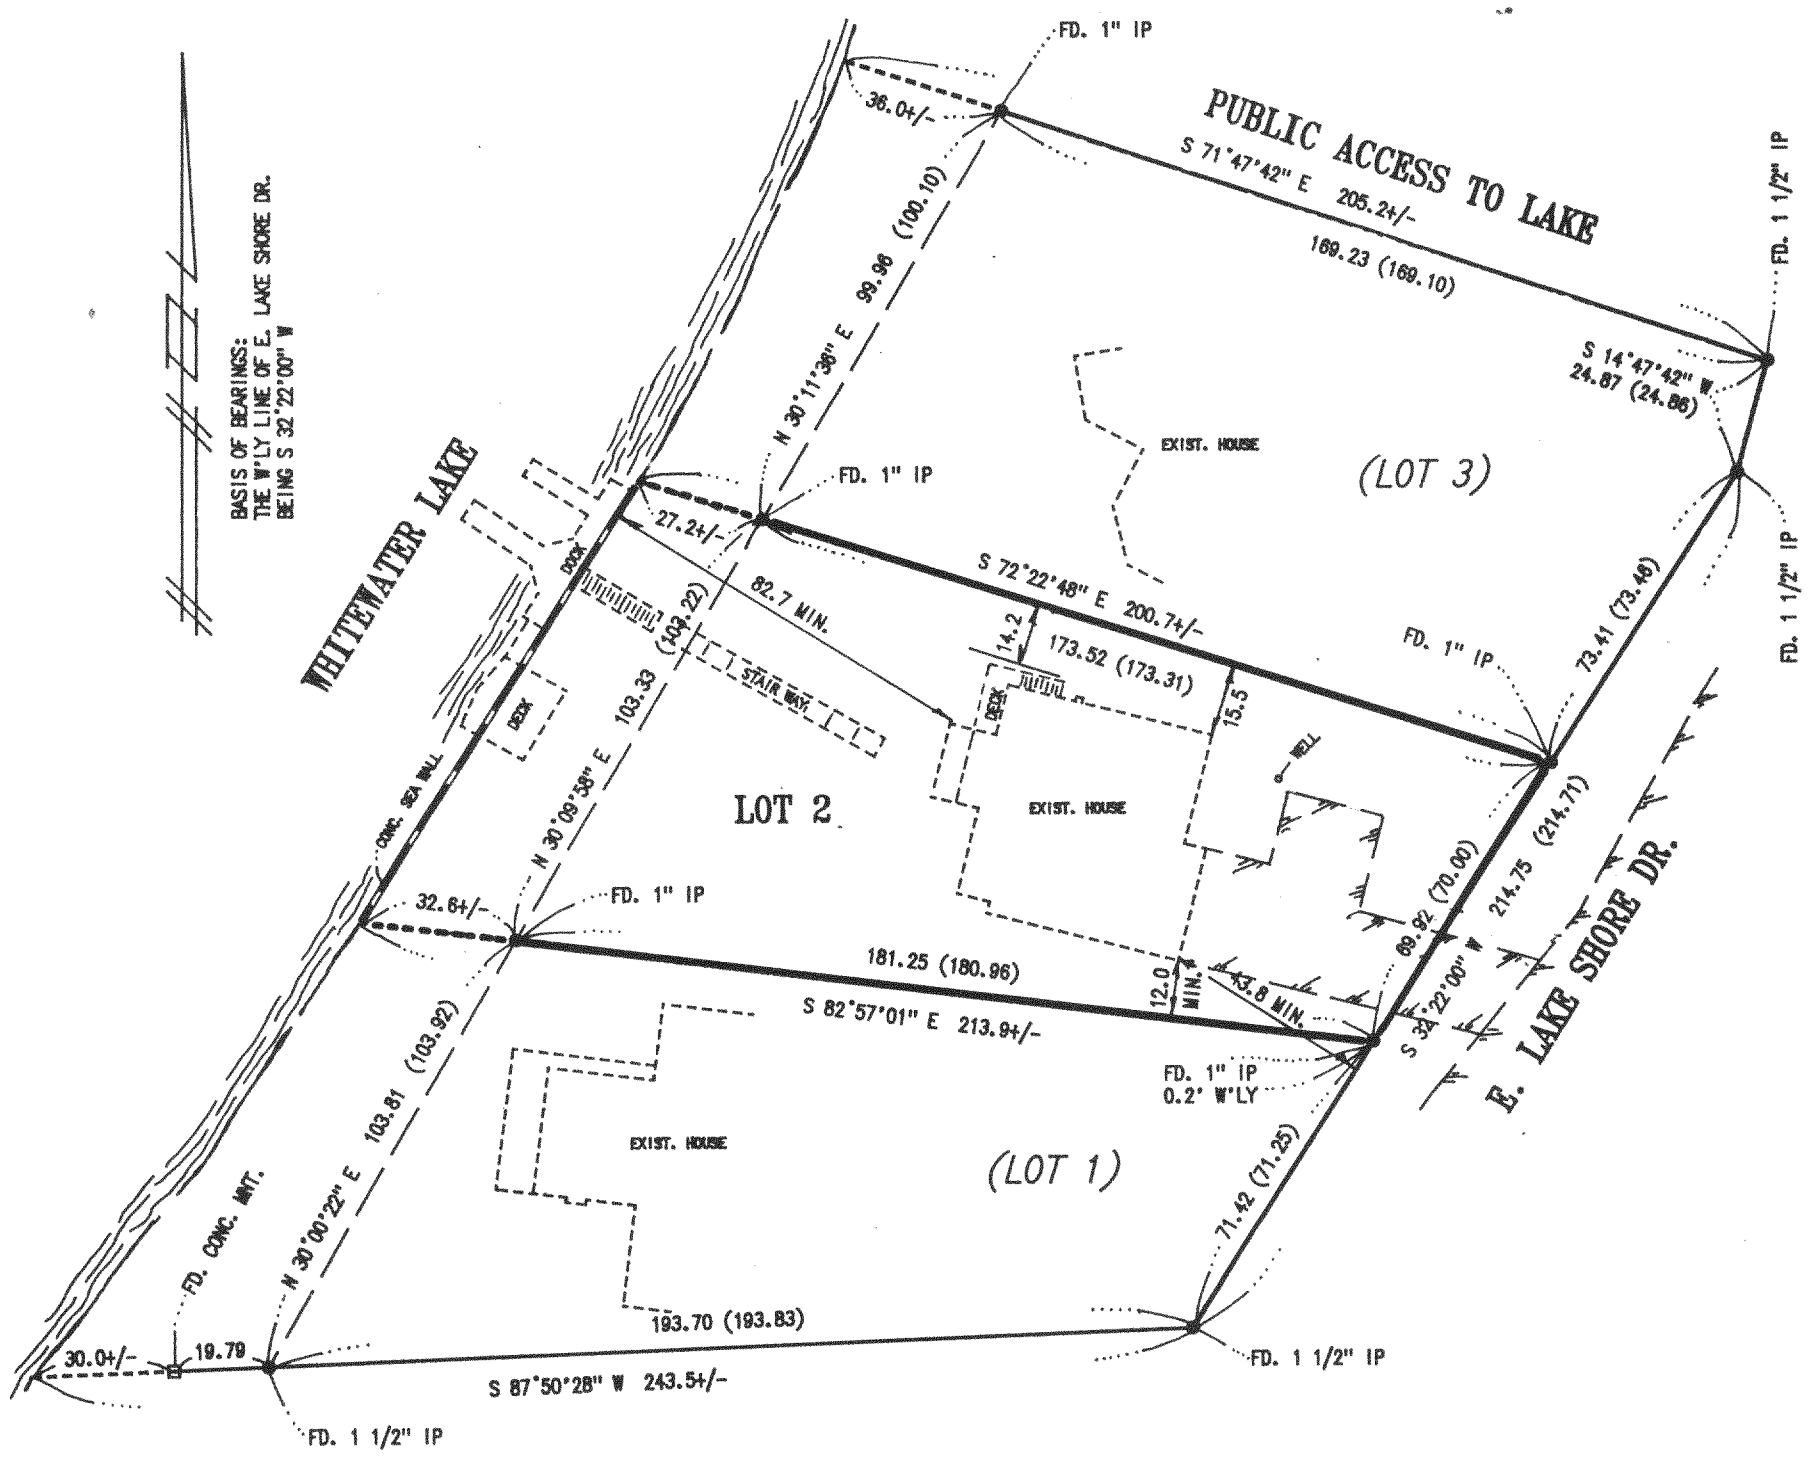

SURVEYOR'S CERTIFICATE
I, JAMES K. LANGONE, REGISTERED LAND SURVEYOR, CERTIFY THAT I HAVE SURVEYED THE PROPERTY DESCRIBED HEREON AND THAT THIS PLAT IS A TRUE AND CORRECT REPRESENTATION OF THE BOUNDARIES THEREOF.

DATE: 3/7/00

JAMES K. LANGONE
REGISTERED LAND SURVEYOR, S-1347

WISCONSIN
JAMES K. LANGONE
S-1347
WHITEWATER
WI
LAND SURVEYOR

NOTES:

( ) -- Indicates Record Data
● -- Indicates Mnt. FD. as Noted

0 20 40 80 120
SCALE: 1"=40'

LEGAL DESCRIPTION:

IN THE SW 1/4, SEC. 25, T4N, R15E, IN THE TOWN OF WHITEWATER, WALWORTH CO., WI.

LOT 2, SHEREDA WOODS

RECEIVED
APR 10 2000

JAMES K. LANGONE LAND SURVEYS & CIVIL ENGINEERING N339 Co. Rd. "N" (Upper) Whitewater, WI. 53190-2842 (262) 473-4119		
SCALE 1" = 40'	APPROVED BY	DRAWN BY JKL
DATE 3/07/00		REVISED
PLAT OF SURVEY LOT 2, SHEREDA WOODS		
CLIENT STRAND		DRAWING NUMBER 00-101

DSW-2

415-745